


Oc
Conewago
base
(2) sand beds
Mc Sherrystown
 → LINE 5
 ↑
See Stone
and Bescon
1929 folio

Mapped by the Army Map Service
 Published for civil use by the Geological Survey
 Control by USGS, USC&GS, and USFS
 Topography from aerial photographs by photogrammetric methods
 Aerial photographs taken 1943. Field check 1944
 Polyconic projection. 1927 North American datum
 10,000-foot grid based on Pennsylvania coordinate system, south zone
 1000-meter Universal Transverse Mercator grid ticks,
 zone 18, shown in blue
 Revisions shown in purple compiled by the Geological Survey in
 cooperation with State of Pennsylvania agencies from aerial
 photographs taken 1968 and 1973. This information not field checked

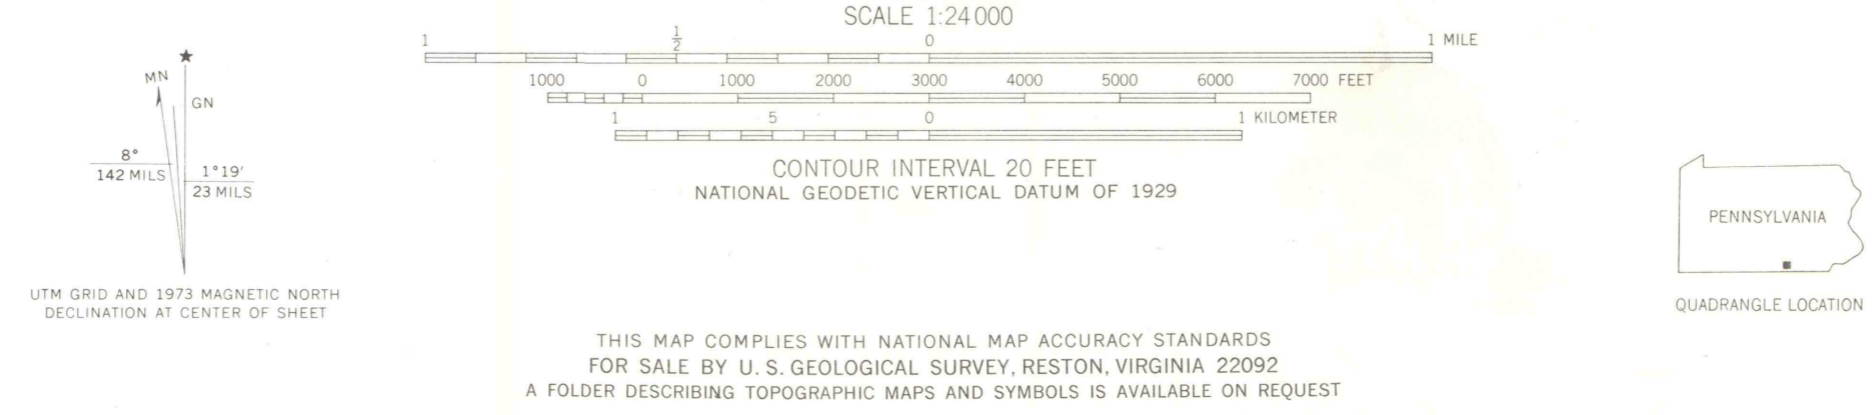

ROAD CLASSIFICATION
 Heavy-duty ——— Light-duty ———
 Medium-duty - - - - - Unimproved dirt - - - - -
 U.S. Route □ State Route ○

MC SHERRYSTOWN, PA.
 SE/4 GETTYSBURG 15' QUADRANGLE
 N3945—W7700/7.5
 1944
 PHOTOREVISED 1968 AND 1973
 AMS 5563 1 SE—SERIES V831

THIS MAP COMPLIES WITH NATIONAL MAP ACCURACY STANDARDS
 FOR SALE BY U.S. GEOLOGICAL SURVEY, RESTON, VIRGINIA 22092
 A FOLDER DESCRIBING TOPOGRAPHIC MAPS AND SYMBOLS IS AVAILABLE ON REQUEST