


GIBSONIA

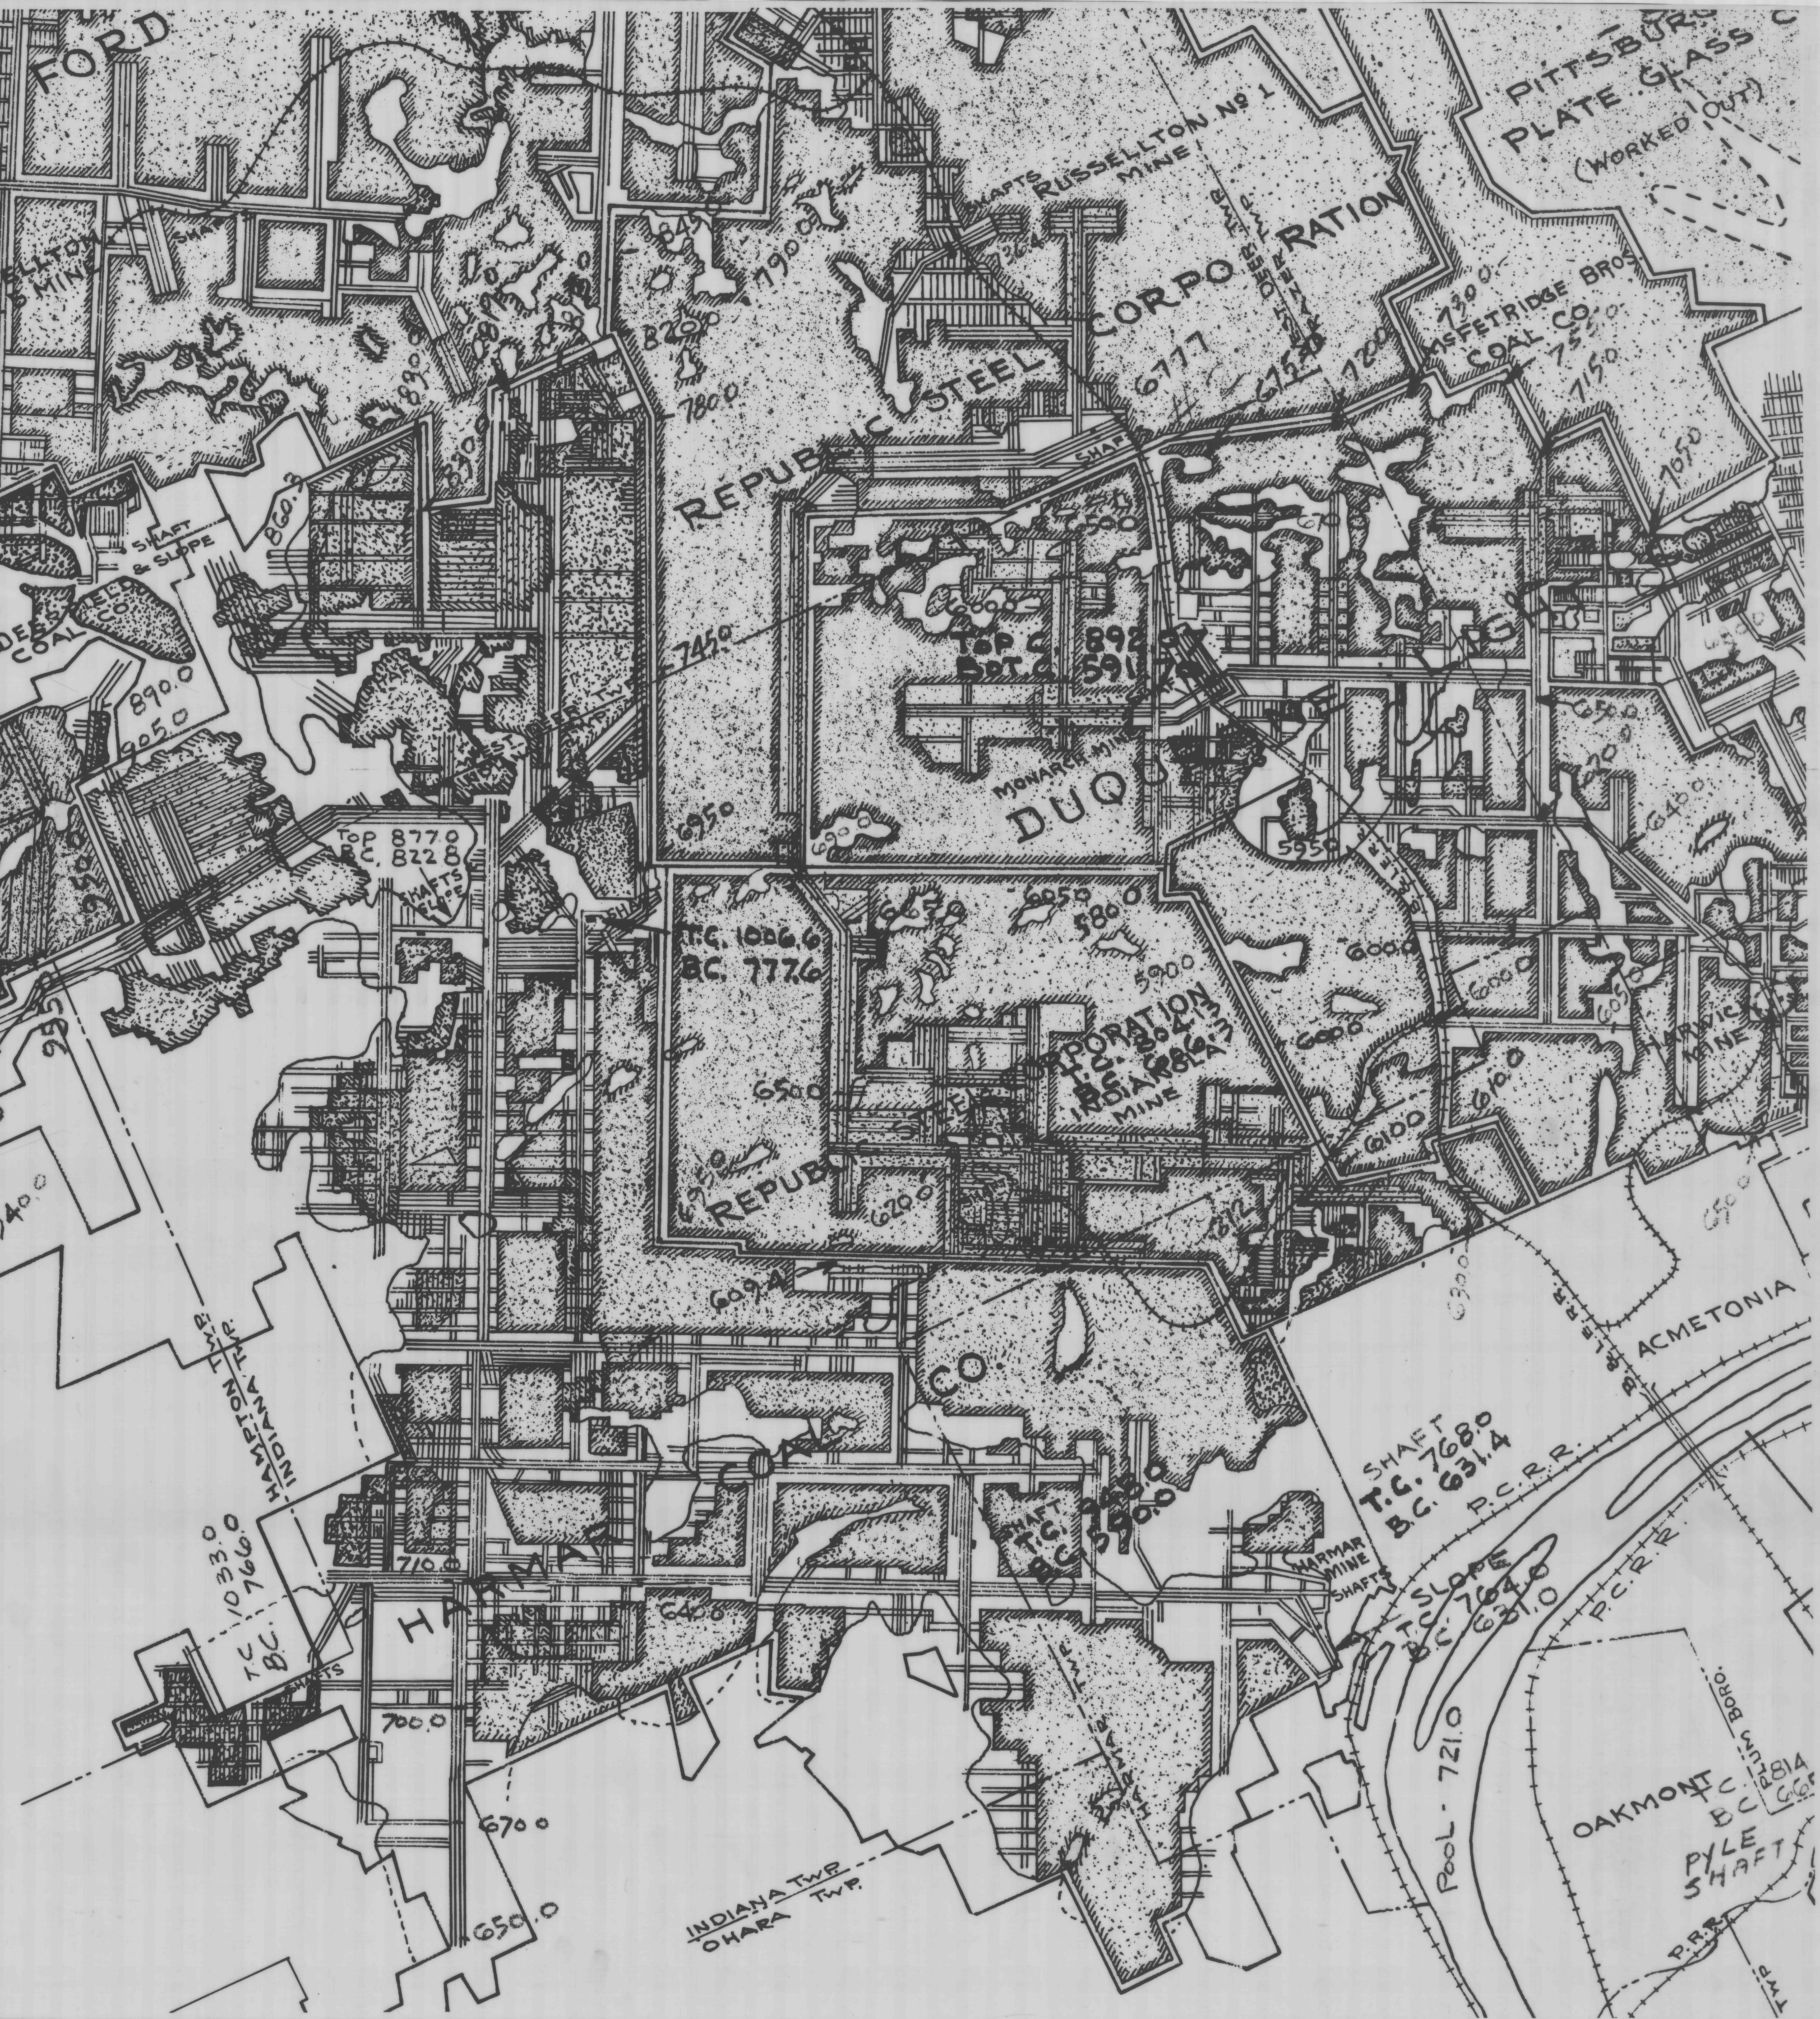

WILDMERE MINE

INDIANA TWP

REPUBLIC STEEL CORP

INDIANA MINE

SHAFT T.C. 7680 B.C. 6314

OAKMONT CO PYLE SHAFT

Pool - 721.0

INDIANA TWP OHARA TWP

ACMETONIA

PITTSBURGH PLATE GLASS CO (WORKED OUT)

WAFETRIDGE BROS COAL CO

MONARCH MINE








