
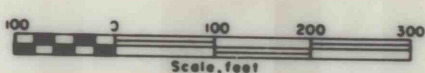


JOHN HOFFMAN

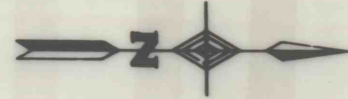

1

BRUCE HARMON

BETTY SNELL

GEORGE HAYS

JOHN HOFFMAN

BLANEY BOWSER
A HEINRICH Coal

BLANEY BOWSER

MINED OUT PRIOR TO 7/9/68

LEON ECHNOZI

THOMAS CRAIG

BLANEY BOWSER

L. BRINK

LEON ECHNOZI



BLANEY BOWSER

MINE MAP FOR
F B E COAL COMPANY, INC.
"PONDEROSA MINE"
WASHINGTON TWP, ARMSTRONG CO.
PENNSYLVANIA

SCALE: 1"=100'
7-8-1968

J.W. HUBBARD, R.P.E.

LEGEND
CONTEMPLATED MINING 7-9-68 to 1-9-69
SUPPORT AREA
PROTECTED STRUCTURE
MINING COMPLETED AREA

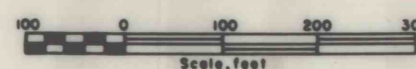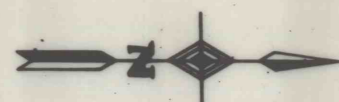

2

