


MTW-112

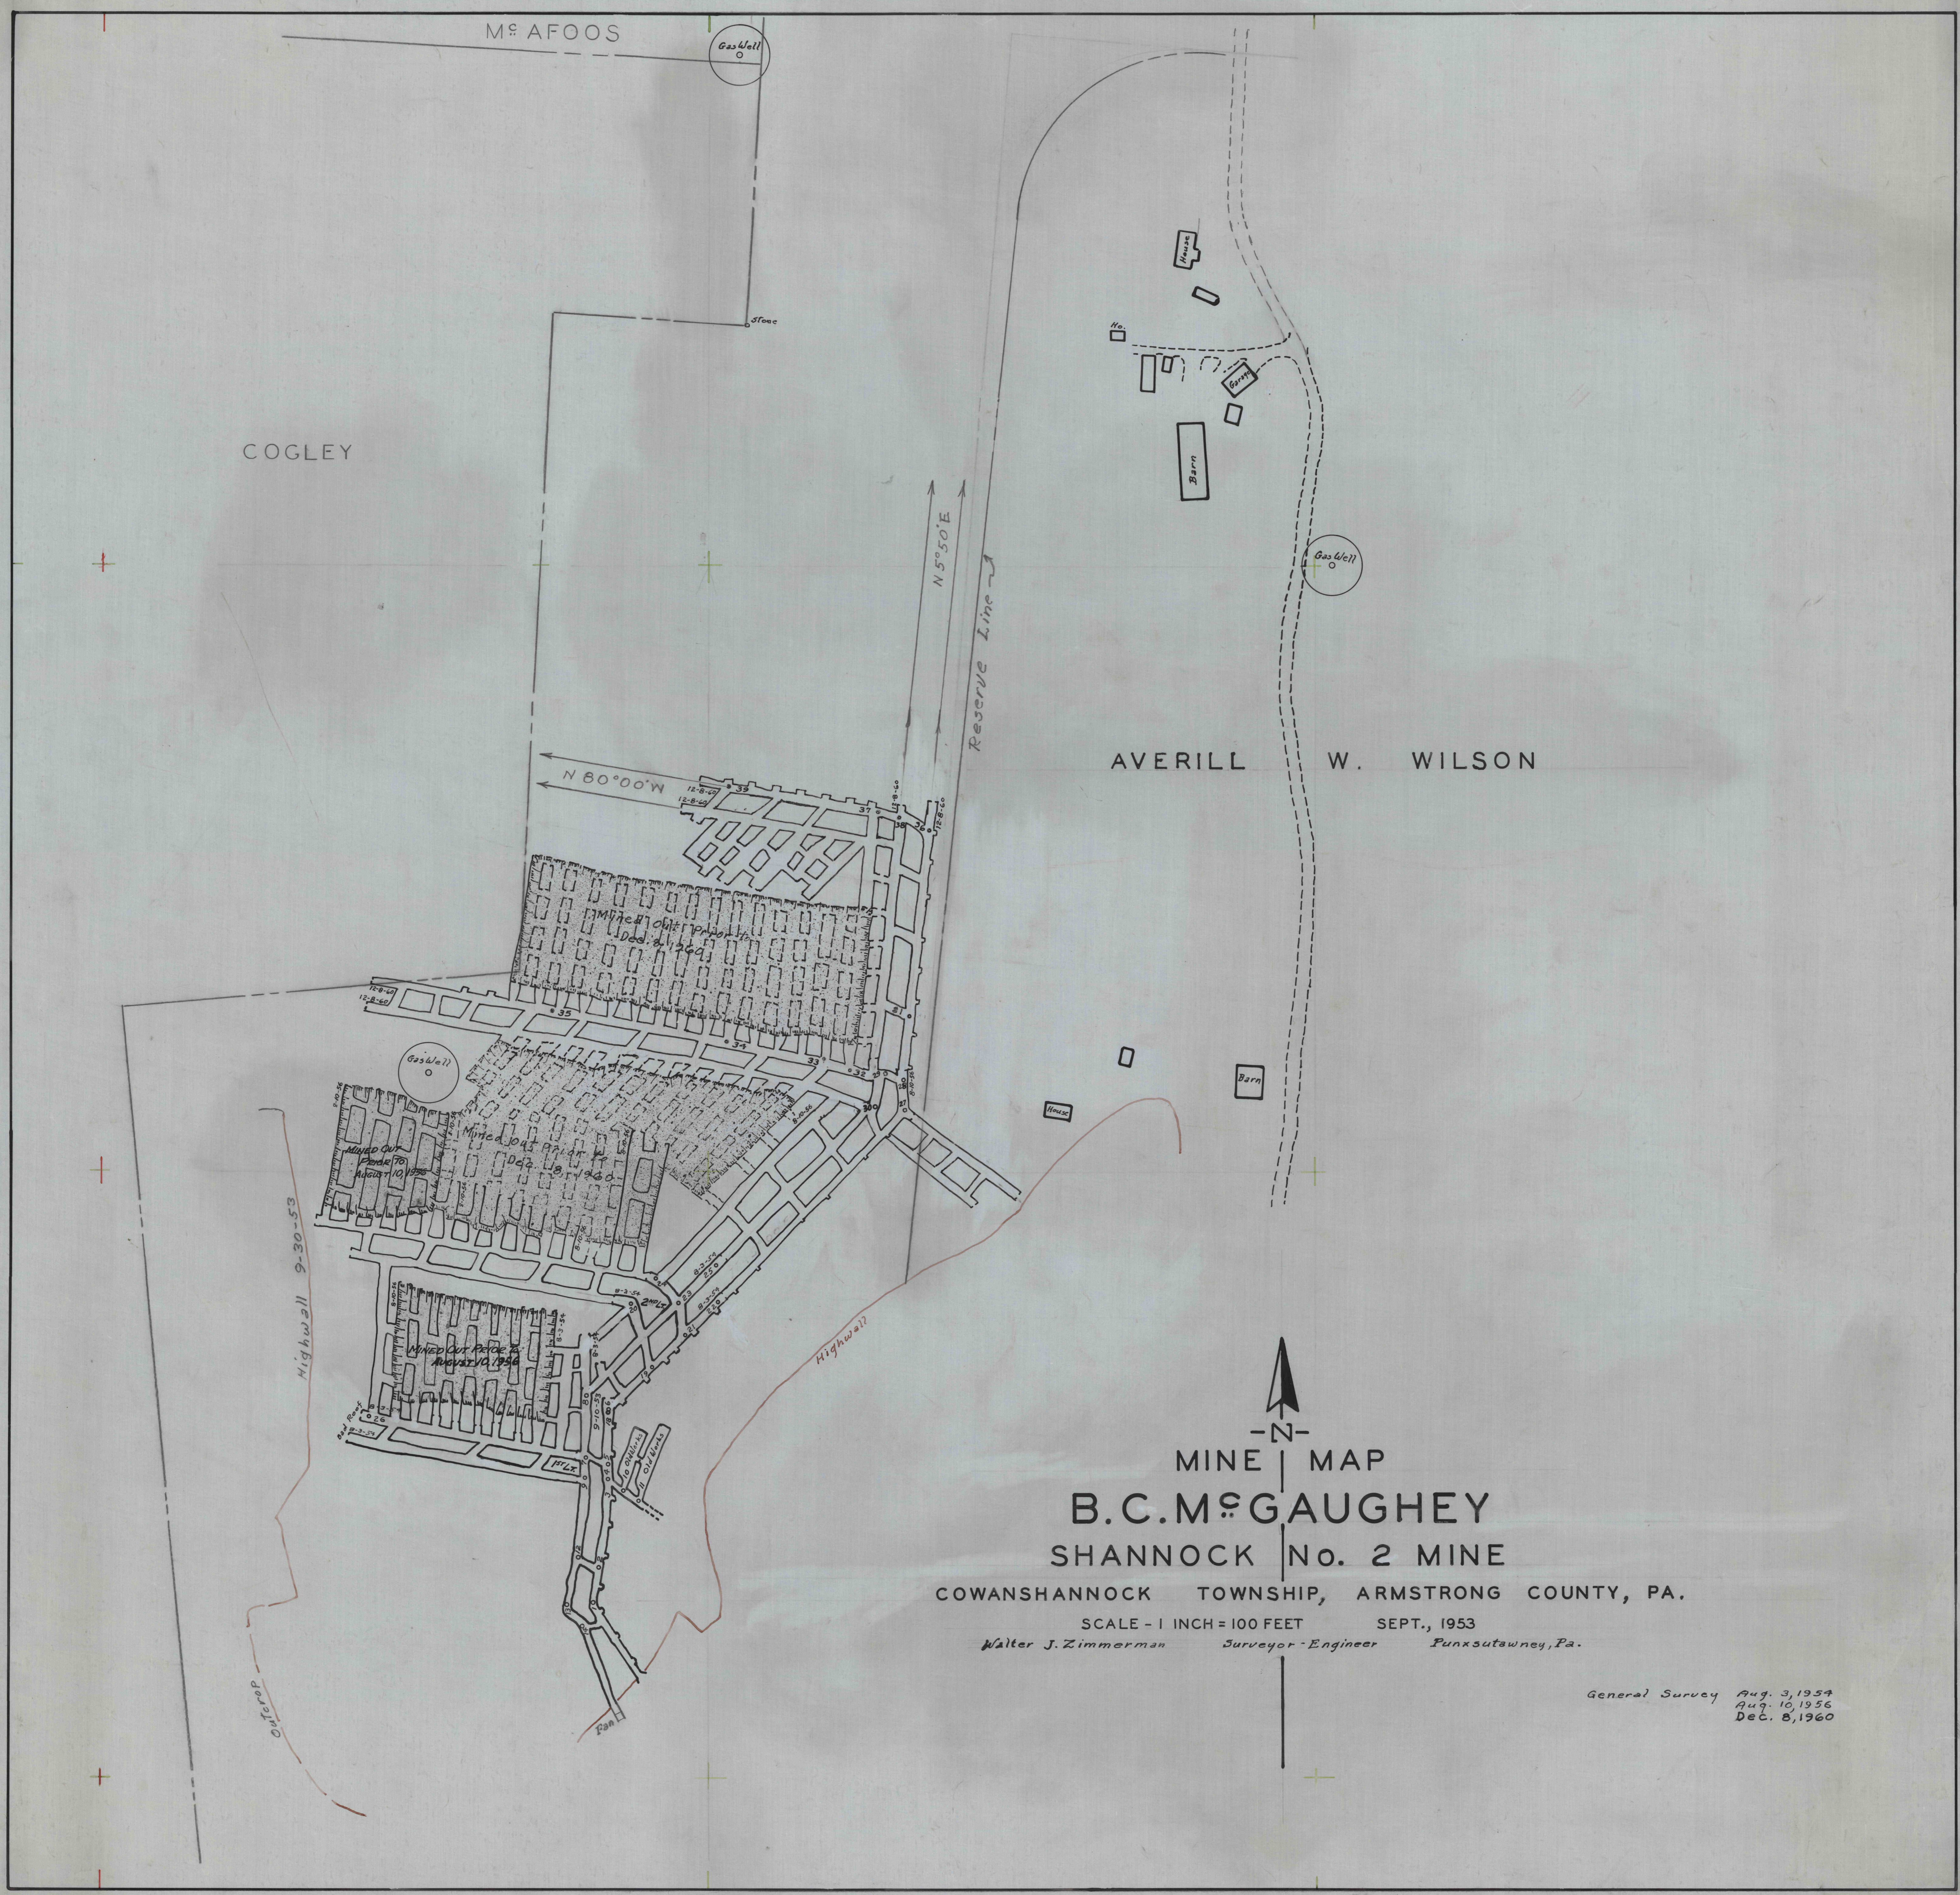

MINE MAP
B.C.M. GAUGHEY
 SHANNOCK No. 2 MINE

COWANSHANNOCK TOWNSHIP, ARMSTRONG COUNTY, PA.

SCALE - 1 INCH = 100 FEET SEPT., 1953

Walter J. Zimmerman Surveyor-Engineer Punxsutawney, Pa.

General Survey Aug. 3, 1954
 Aug. 10, 1955
 Dec. 8, 1960

396
398
102

111

COE218