


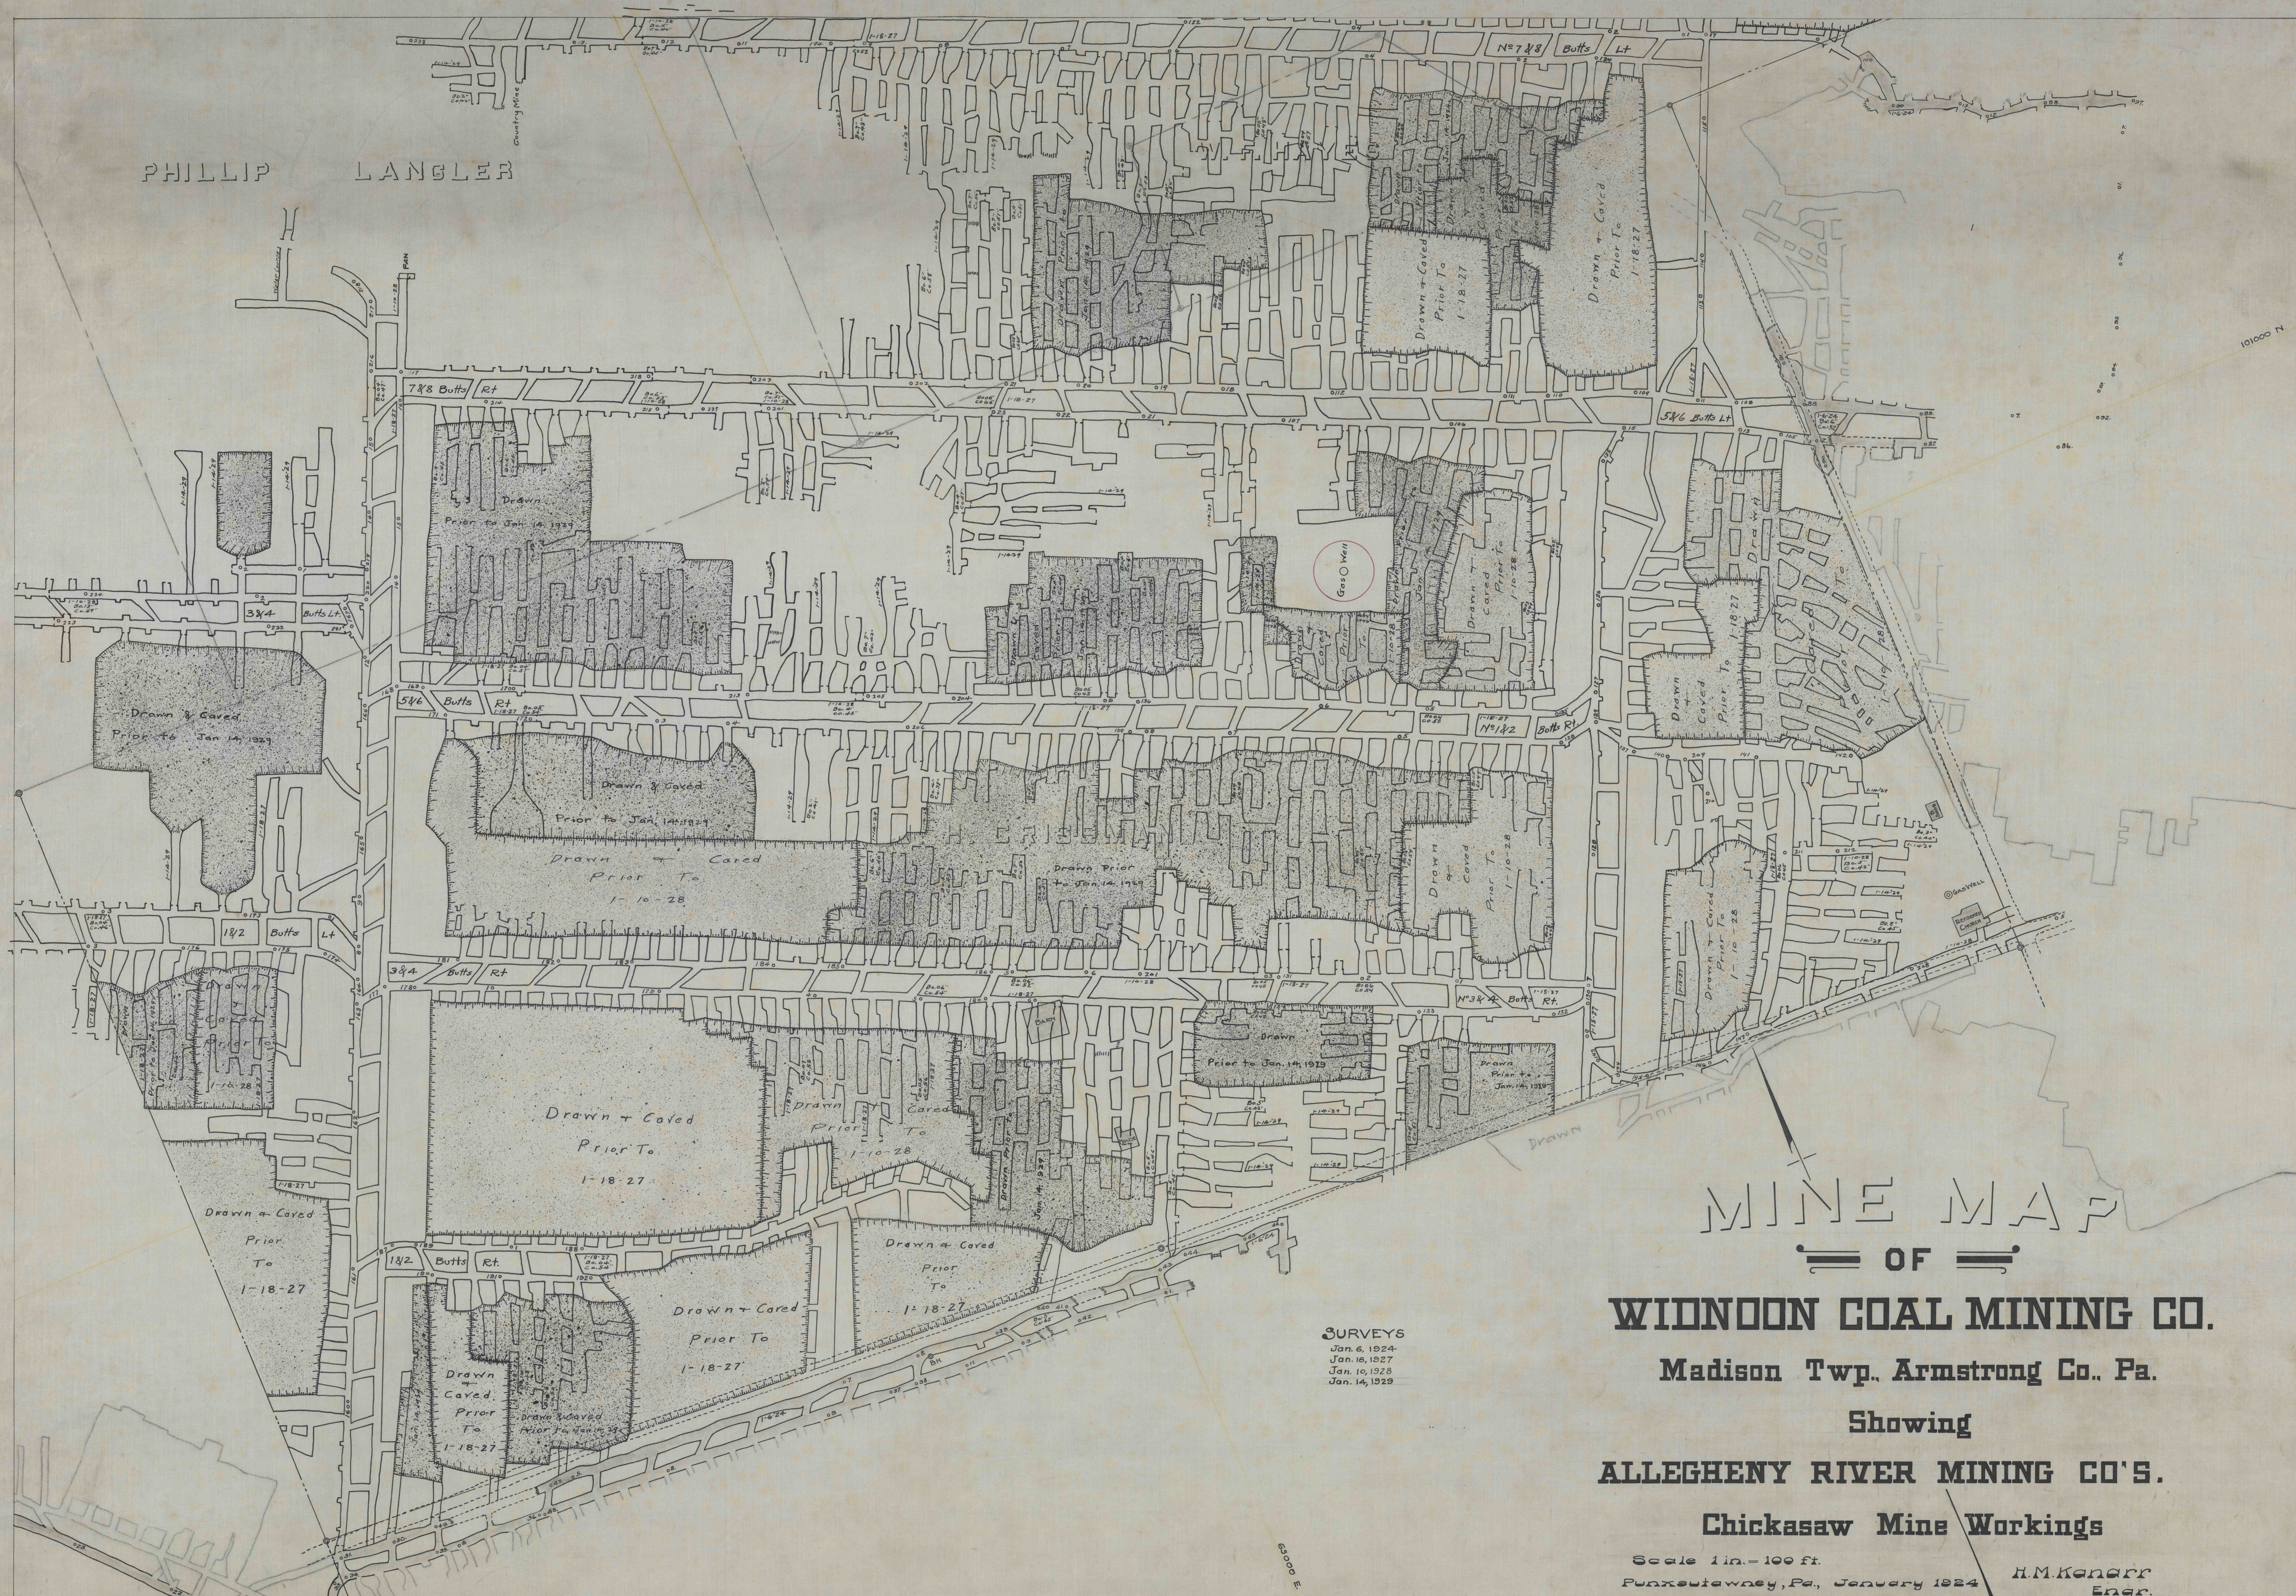

PHILLIP LANTLER

MINE MAP OF

WIDNOON COAL MINING CO.

Madison Twp., Armstrong Co., Pa.

Showing

ALLEGHENY RIVER MINING CO'S.

Chickasaw Mine Workings

Scale 1 in. = 100 ft.
Punxsutawney, Pa., January 1924

H.M. Kenarr
Engr.

SURVEYS
Jan. 6, 1924
Jan. 10, 1927
Jan. 10, 1928
Jan. 14, 1929