


FAN DATA: S/N 6206
 JEFFREY AERODYNE JR. 5ft.
 Fixed Pitch Blade Setting
 563 RPM
 15 Hp
 480 V.A.C.
 .3 W.G.

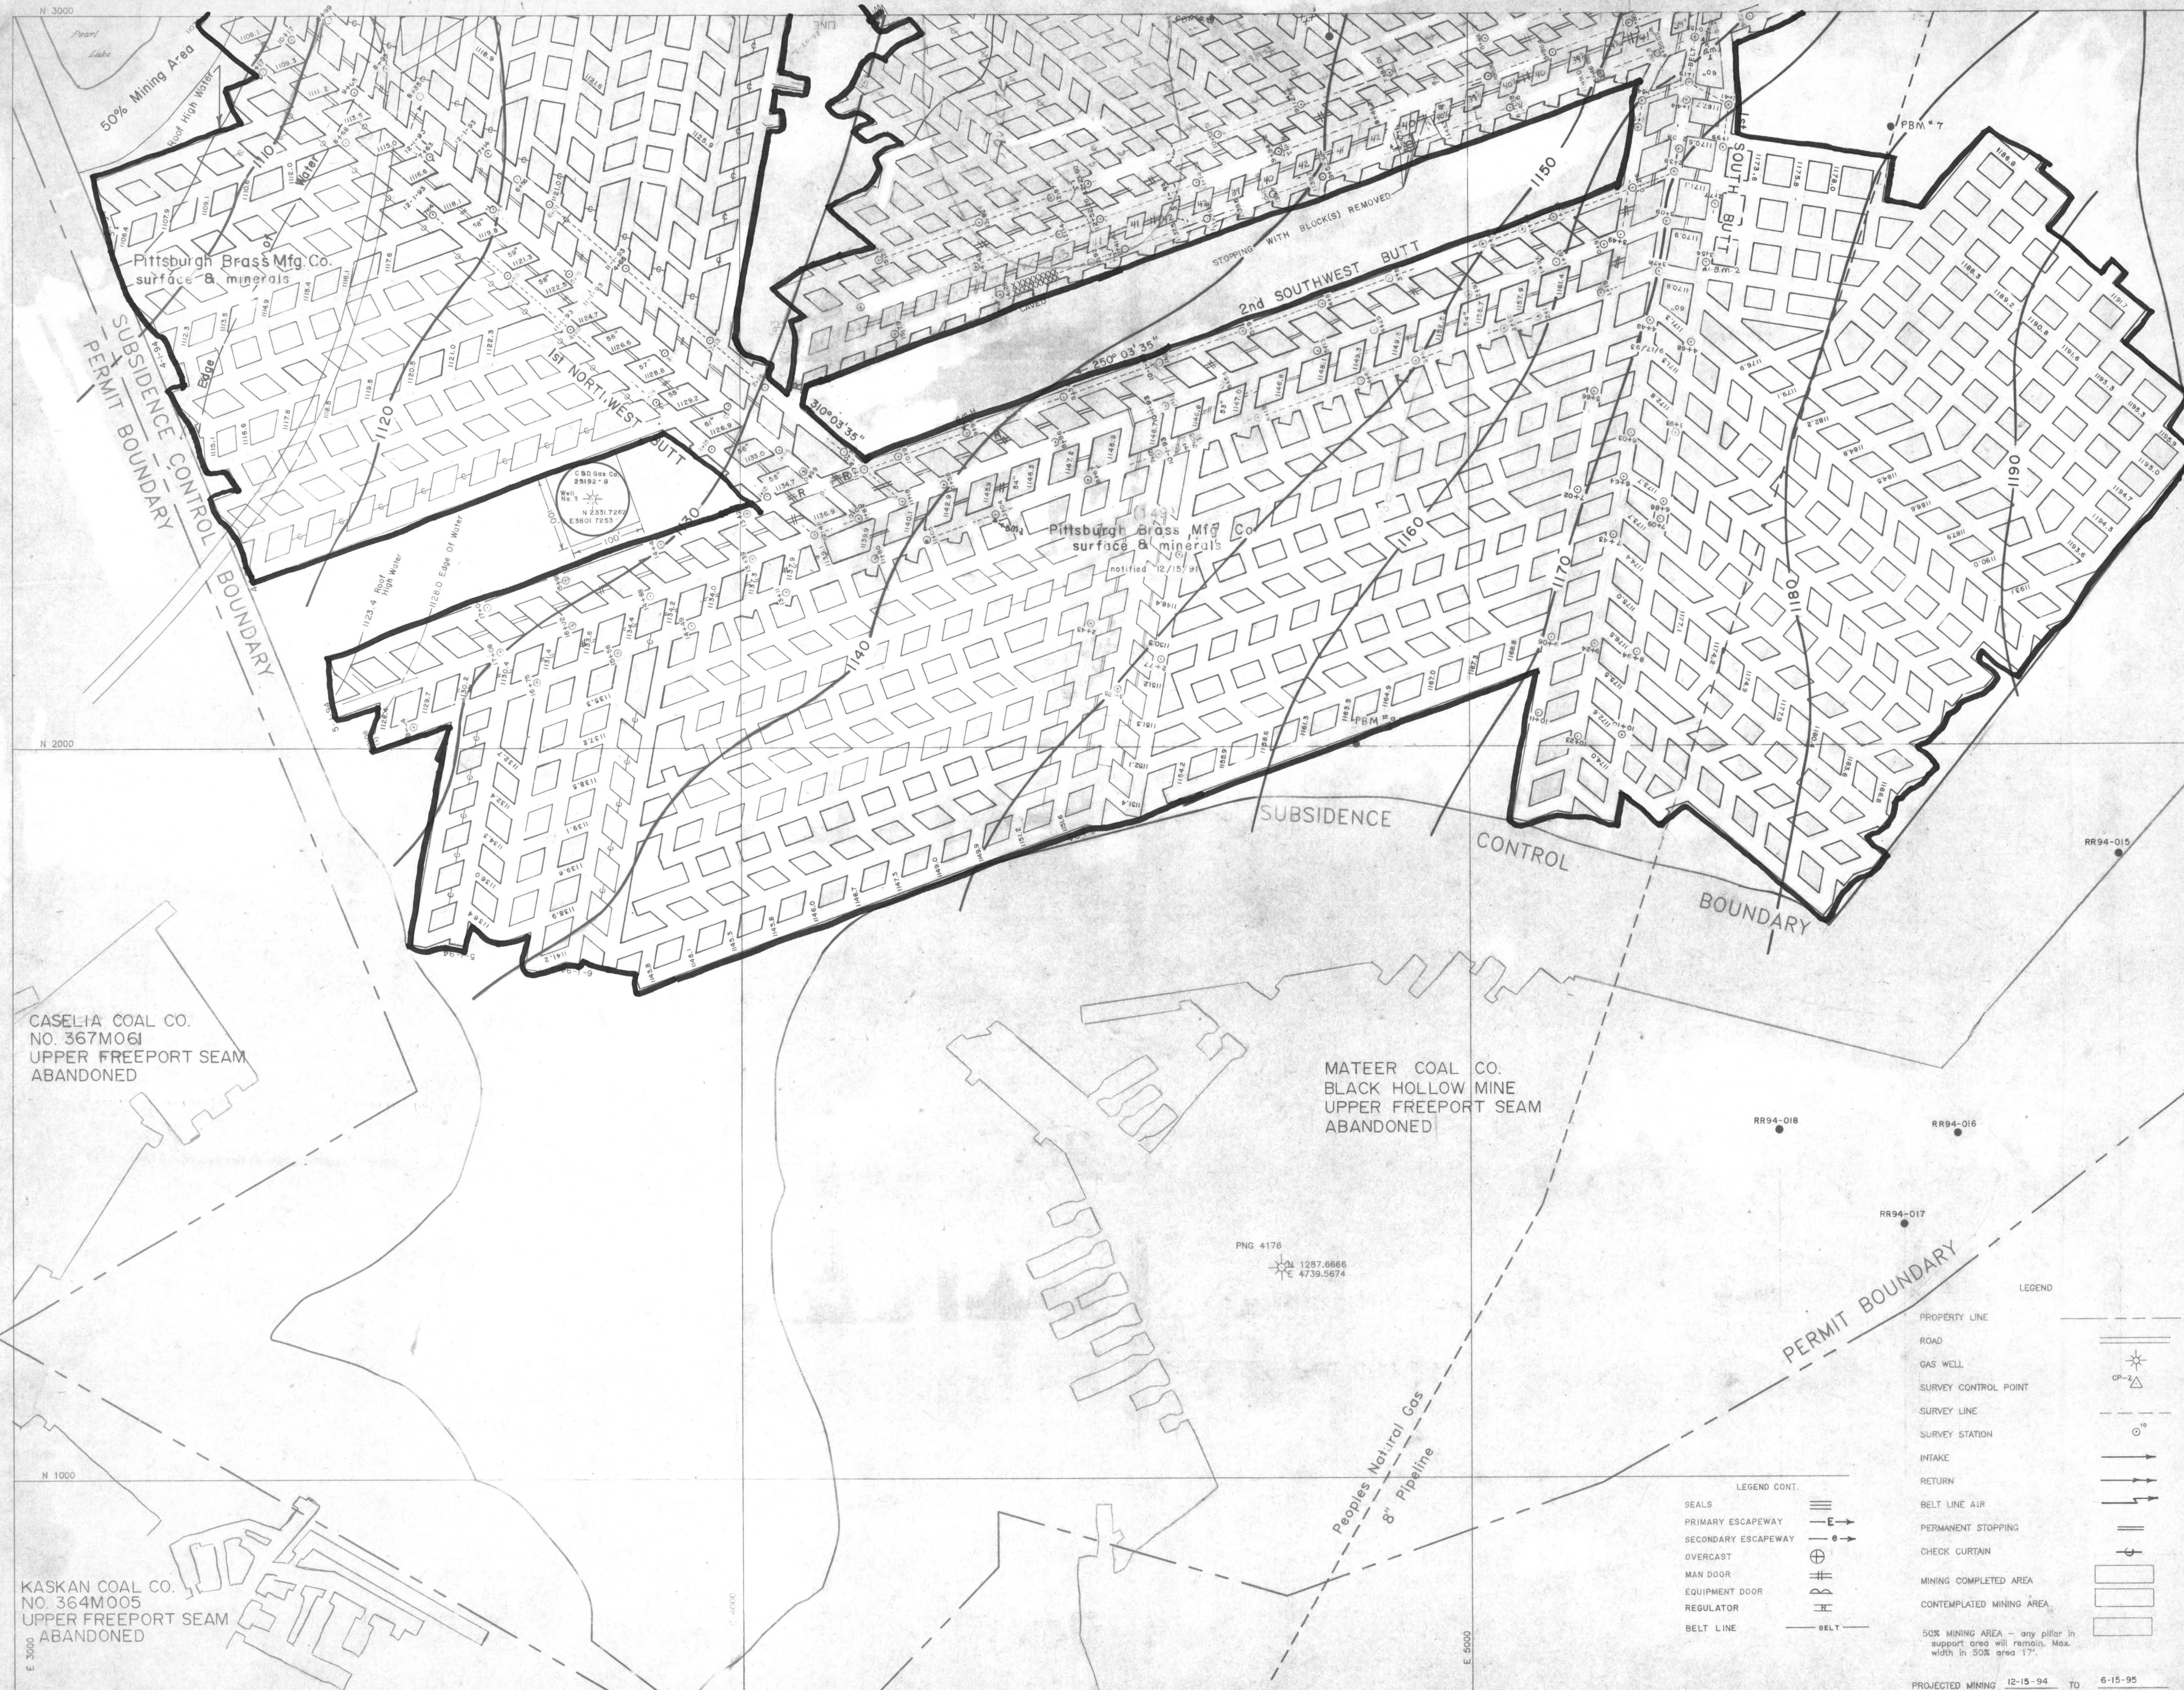

CASELIA COAL CO.
 NO. 367M061
 UPPER FREEPORT SEAM
 ABANDONED


MATEER COAL CO.
 BLACK HOLLOW MINE
 UPPER FREEPORT SEAM
 ABANDONED

KASKAN COAL CO.
 NO. 364M005
 UPPER FREEPORT SEAM
 ABANDONED

PERMIT BOUNDARY

- LEGEND
- PROPERTY LINE
 - ROAD
 - GAS WELL
 - SURVEY CONTROL POINT
 - SURVEY LINE
 - SURVEY STATION
 - INTAKE
 - RETURN
 - BELT LINE AIR
 - PERMANENT STOPPING
 - CHECK CURTAIN
 - MINING COMPLETED AREA
 - CONTEMPLATED MINING AREA

- LEGEND CONT.
- SEALS
 - PRIMARY ESCAPEWAY
 - SECONDARY ESCAPEWAY
 - OVERCAST
 - MAN DOOR
 - EQUIPMENT DOOR
 - REGULATOR
 - BELT LINE

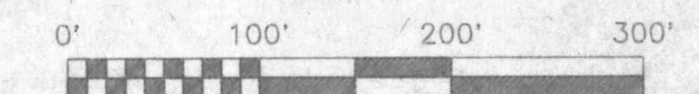

ROSEBUD MINING COMPANY	
ROARING RUN MINE	
KISKIMINETAS TWP. ARMSTRONG CO.	
UPPER FREEPORT COAL SEAM	
SHEET #2	
REVISIONS	BY
	DRAWN BY KB
	CHECKED BY SH
	DATE 12/15/94
	SCALE 1"=100'

Prepared by:
VAPCO ENGINEERING
 P.O. Box 119 and 210, Punxsutawney, PA 15767

PROJECTED MINING 12-15-94 TO 6-15-95