


ERIOR 1,520,000

COMMONWEALTH OF PENNSYLVANIA  
DEPARTMENT OF ENVIRONMENTAL RESOURCES  
TOPOGRAPHIC AND GEOLOGIC SURVEY

5165 III NW  
(WHITESBURG)

629 KITTANNING 15 MI. MATEER 1.3 MI. 630 27'30" 631 8 MI. TO U.S. 422 25' 634 154000

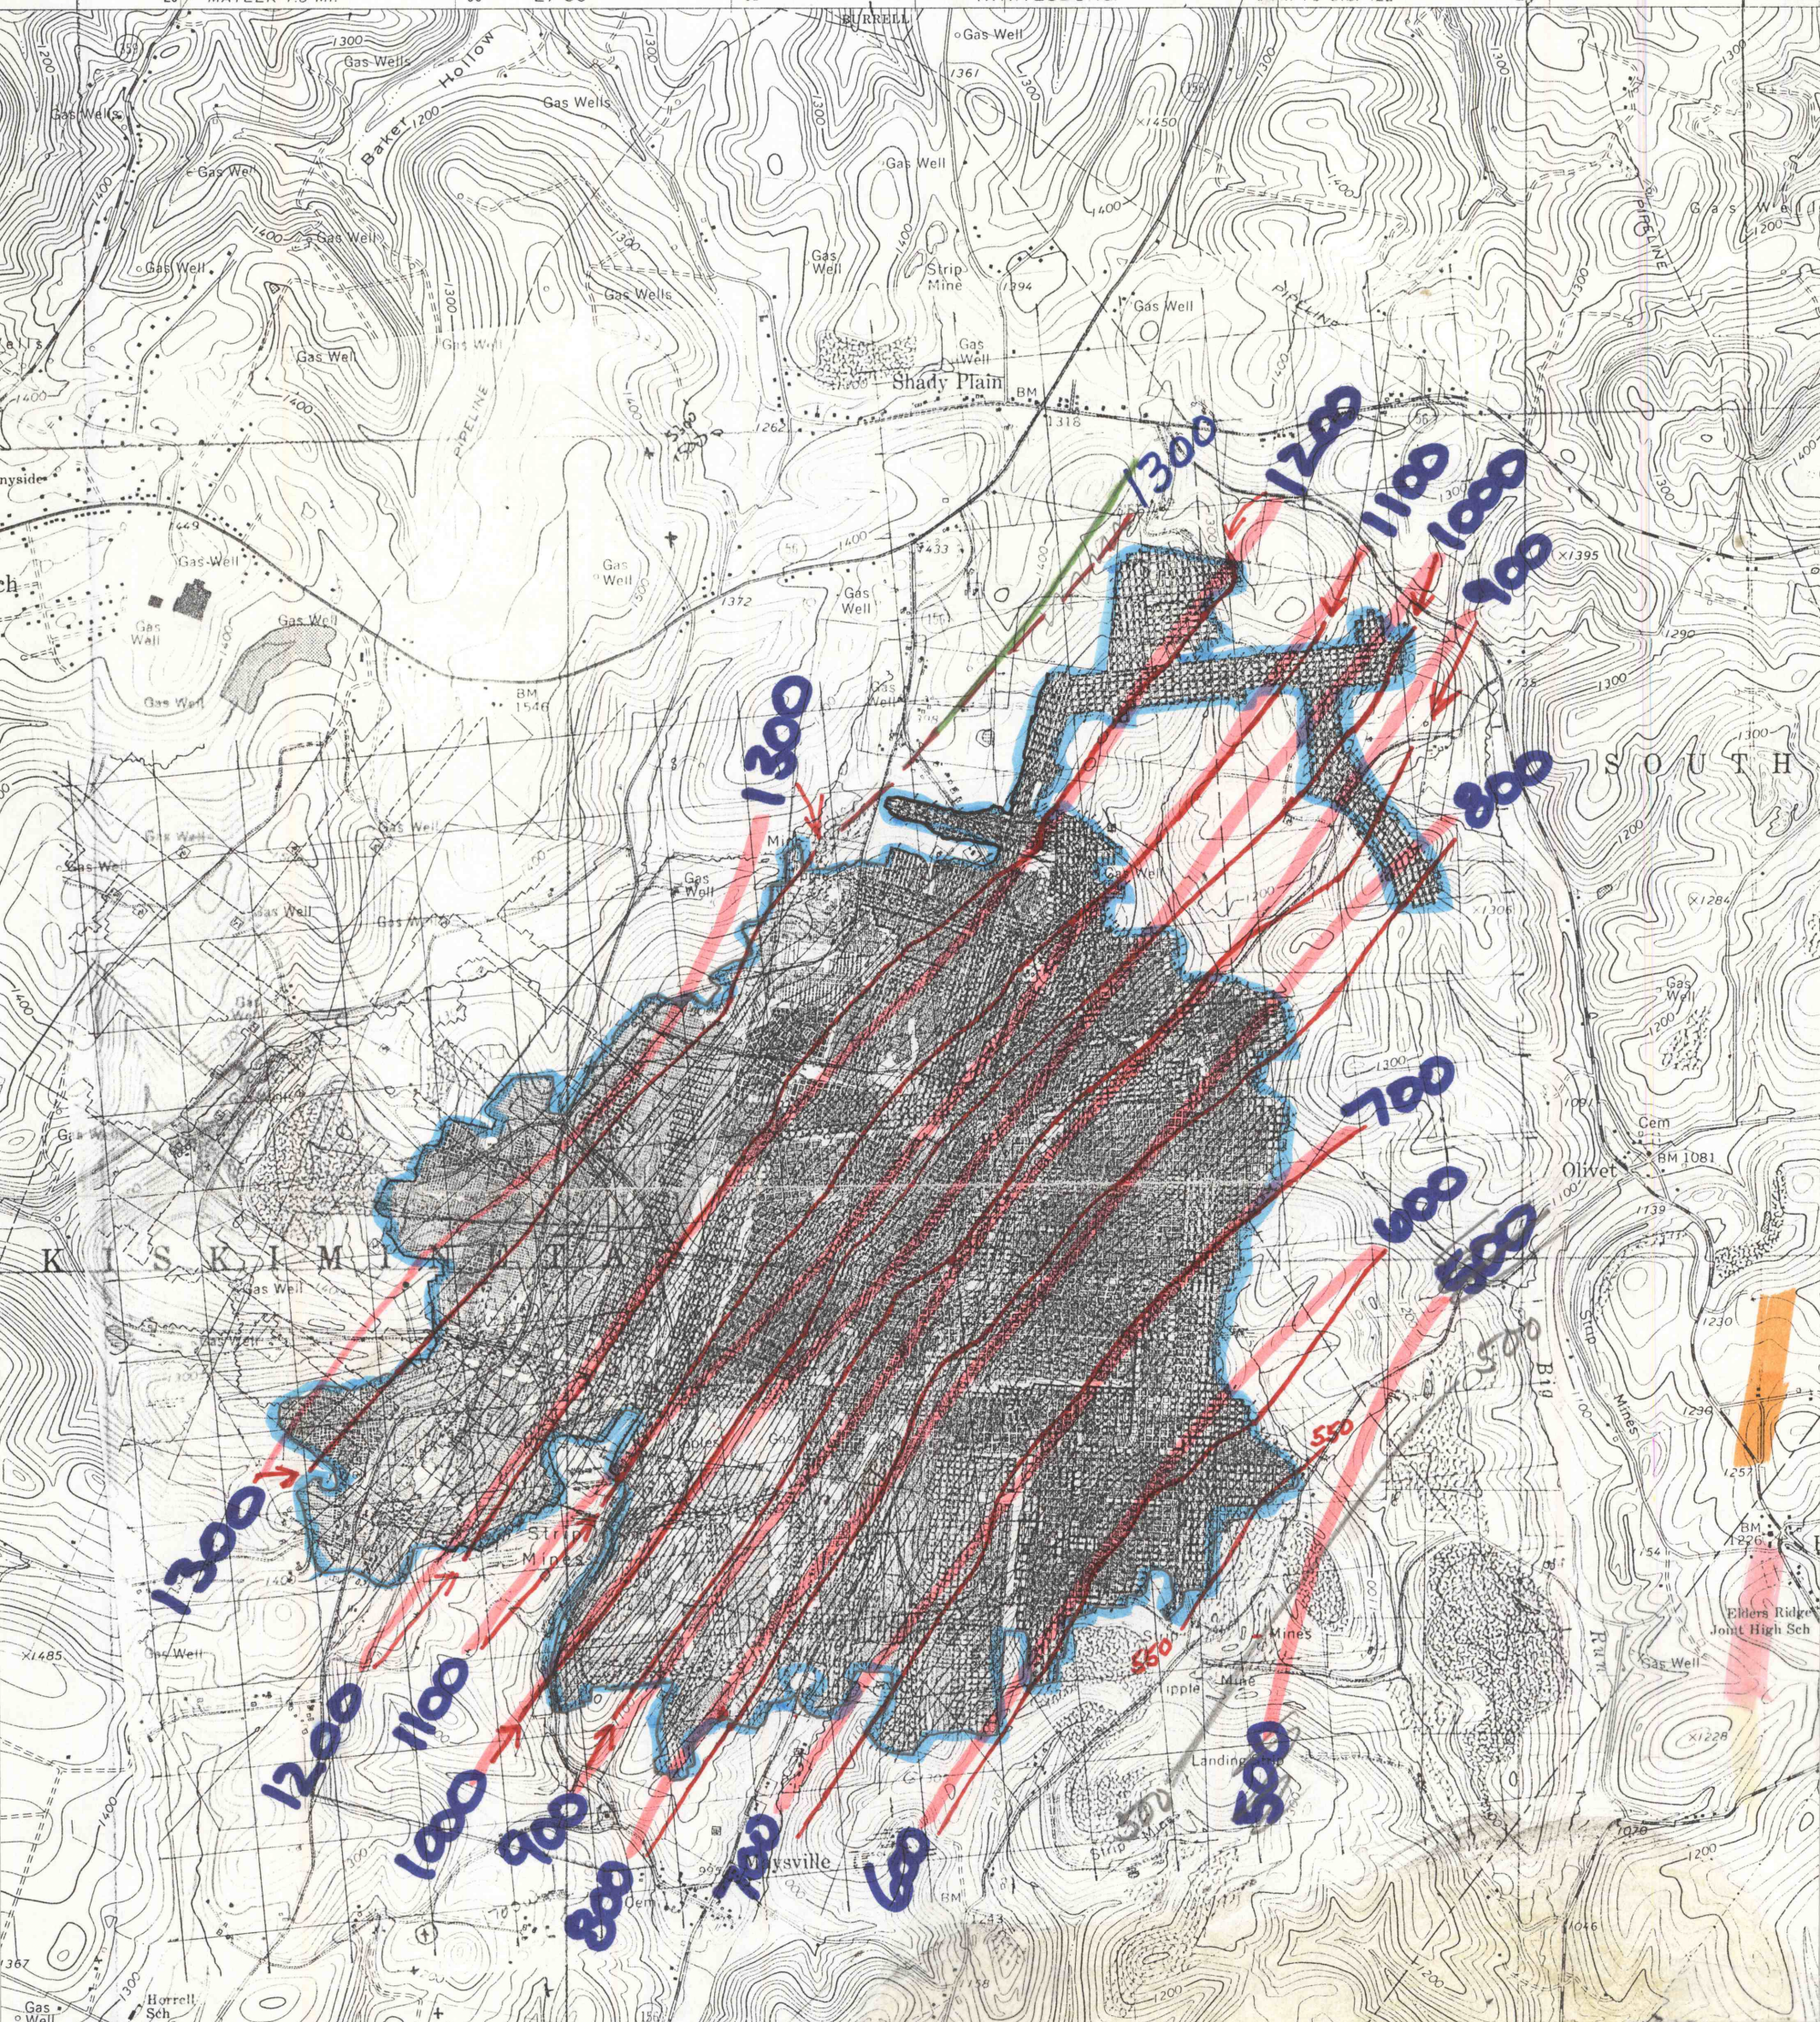

**CANTERBURY COAL COMPANY**  
**DAVID MINE**  
 (UPPER FREEPORT SEAM)  
 (AVERAGE HEIGHT = 9')

C-5 wrong  
 C-9  
 C-31  
 C-29  
 C-19  
 C-7  
 C-28  
 C-15

A551  
 A553

1"=2000'

(AVONMORE, PA QUADRANGLE - 1964 version)

**EXTENT OF MINING (COMPLETED MARCH 1995)**  
**COAL CONTOUR LINES (STRUCTURE)**