
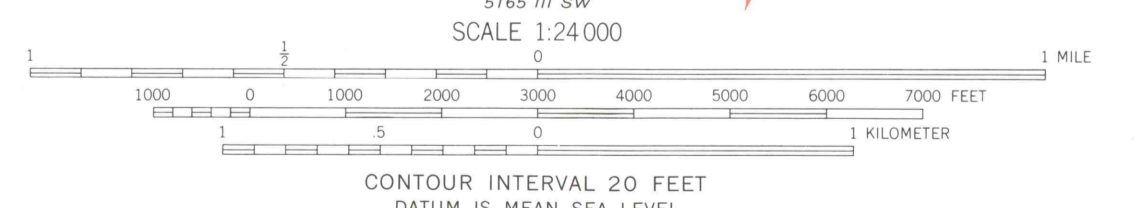


Mapped, edited, and published by the Geological Survey  
Control by USGS and USC&GS  
Topography by photogrammetric methods from aerial photographs taken 1962 and 1963. Field checked 1964  
Polyconic projection. 1927 North American datum  
10,000-foot grid based on Pennsylvania coordinate system, south zone  
1000-meter Universal Transverse Mercator grid ticks, zone 17, shown in blue  
Fine red dashed lines indicate selected fence and field lines where generally visible on aerial photographs. This information is unchecked  
Areas covered by dashed light-blue pattern are subject to controlled inundation

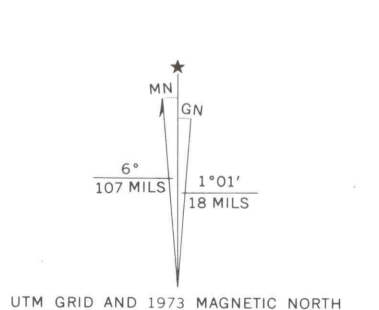

THIS MAP COMPLIES WITH NATIONAL MAP ACCURACY STANDARDS  
FOR SALE BY U.S. GEOLOGICAL SURVEY, WASHINGTON, D. C. 20242  
A FOLDER DESCRIBING TOPOGRAPHIC MAPS AND SYMBOLS IS AVAILABLE ON REQUEST

Revisions shown in purple compiled in cooperation with State of Pennsylvania agencies from aerial photographs taken 1973. This information not field checked

WHITESBURG, PA.  
N4037.5—W7922.5/7.5  
1964  
PHOTOREVISED 1973  
AMS 5165 III NW—SERIES V831

SOUTH BEND ?  
SEVEN SISTERS  
LOC. FROM  
BOS II MEMORY  
40° 38' 10" N  
79° 24' 35" W  
40° 38' 16" N  
79° 24' 50" W  
From mine  
40° 37' 30" N  
79° 22' 30" W  
permit.