


NANLEE MINE

FRAZER MINE




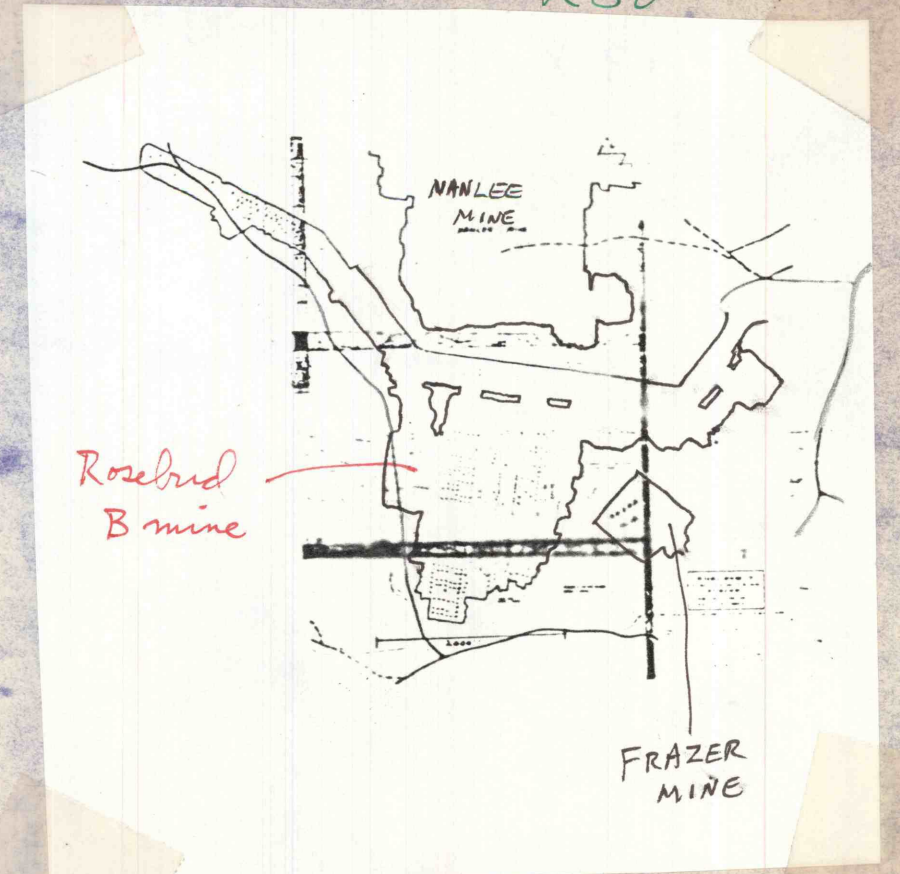

X.50

