


W.M. RIMER

GEORGE LORENZ

M. L. LORENZ

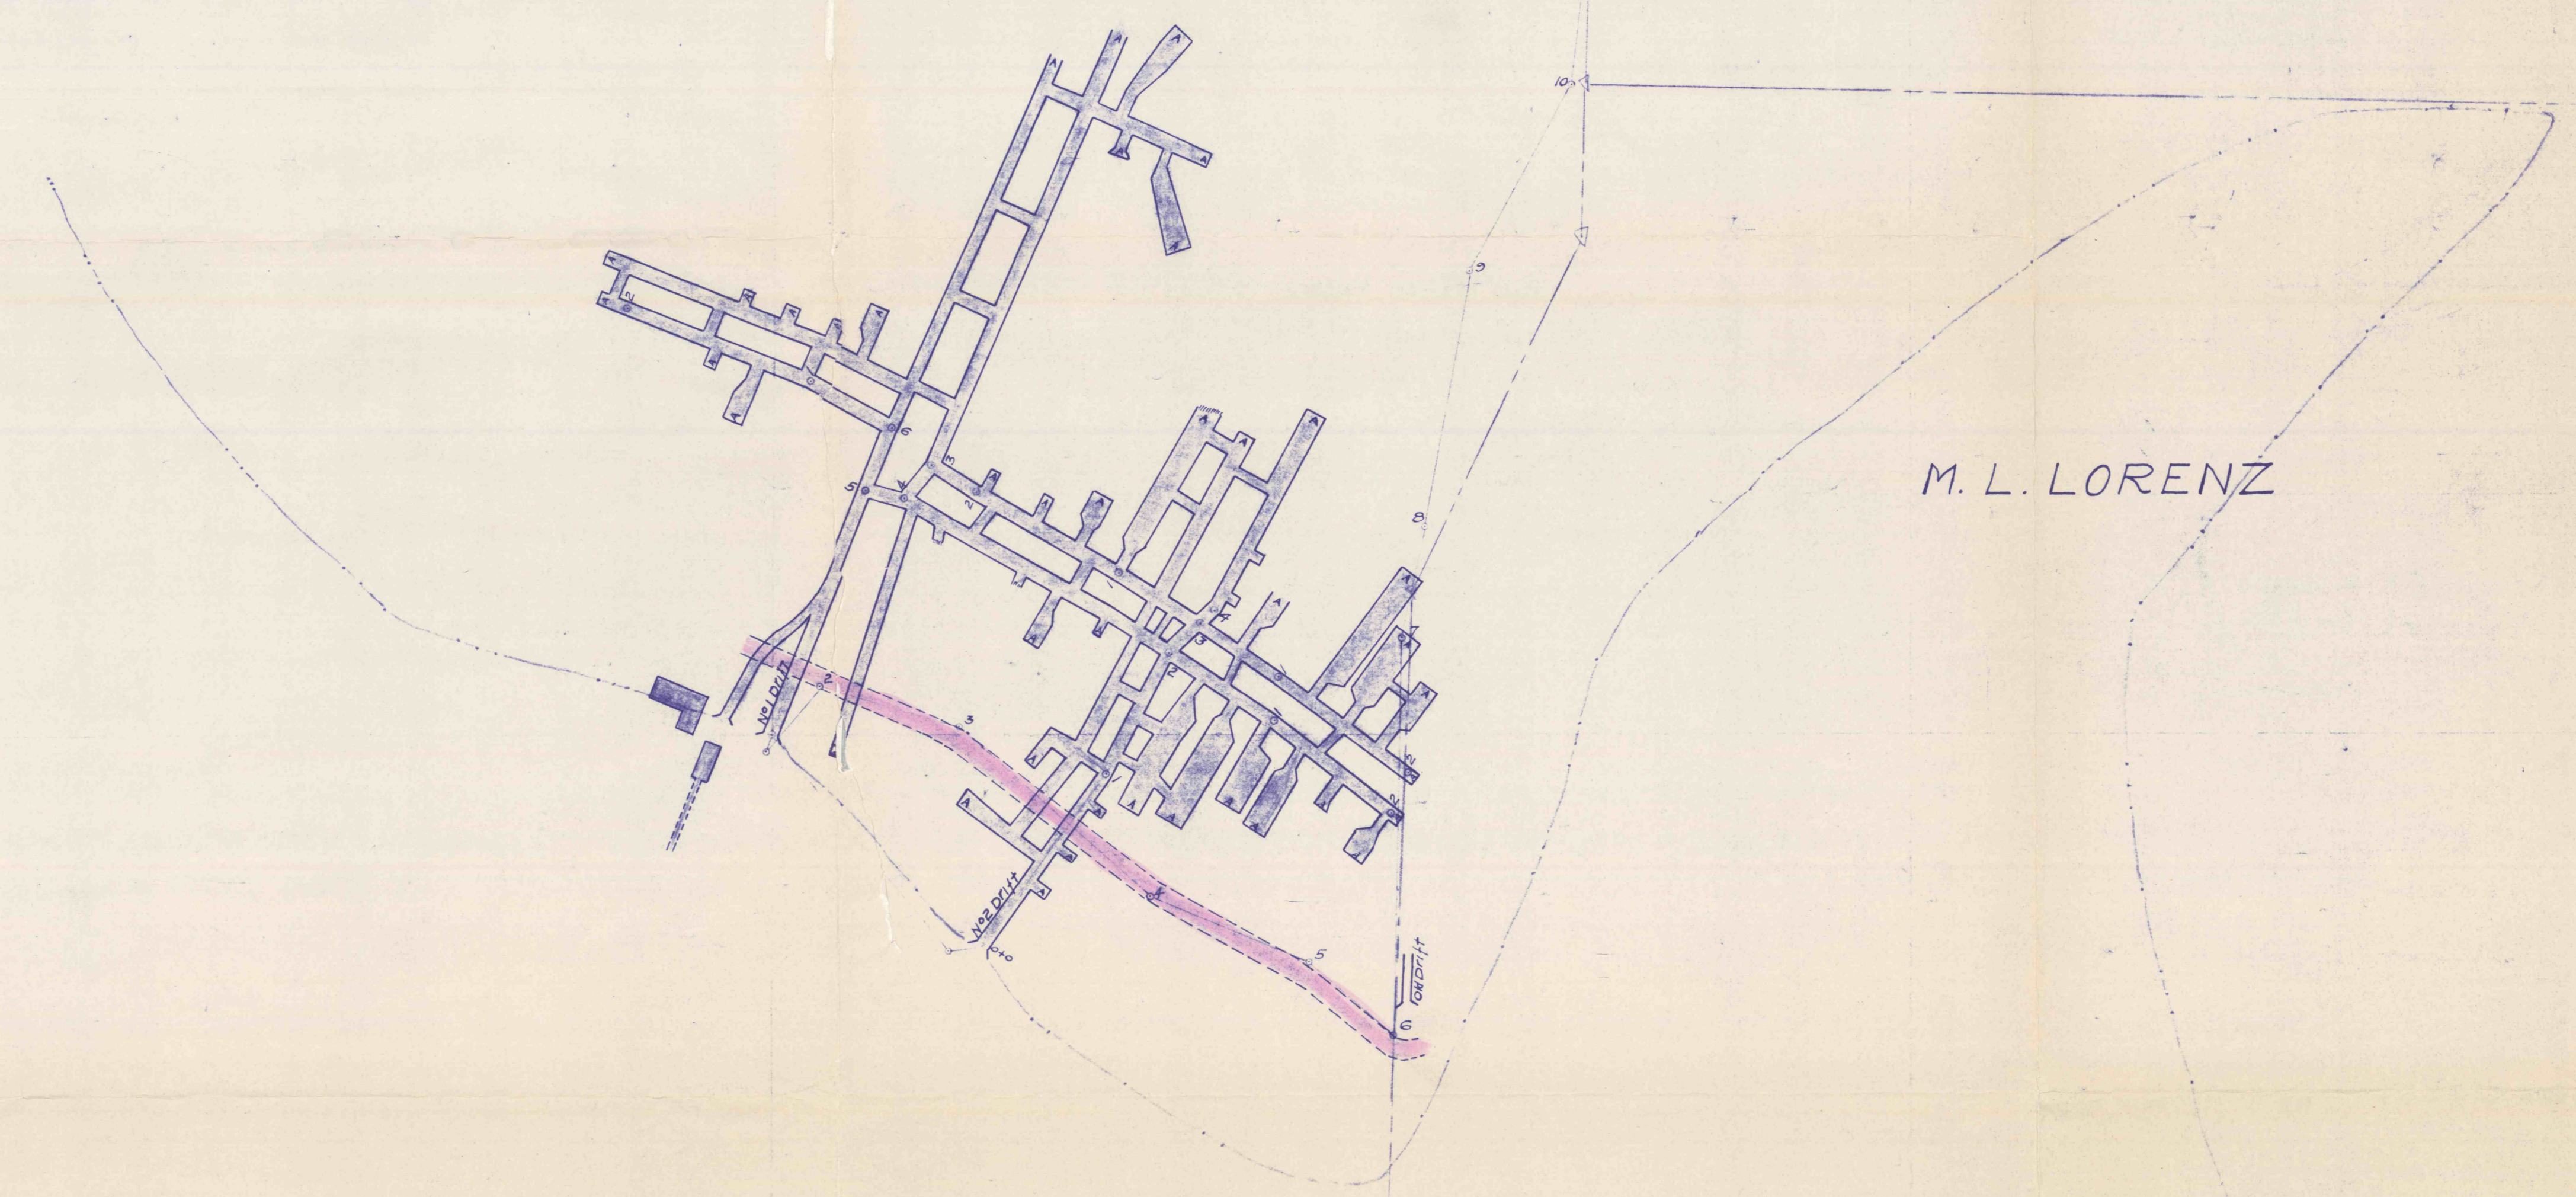

SURVEY LEGEND
X NOV 26, 1922

MINE WORKINGS OF THE
BEACON HILL COAL CO.
 RIMERTON PA. — ARMSTRONG CO.
 SCALE 1" = 100'
 HERBERT & HENDERSON ENGR'S KITTANNING PA.
 NOVEMBER — 1922

EAST BRADY 7 1/2'
 approx location
 AG 3-95
 can't locate
 4/2/90 AG

NTM
 758
 11/1/22