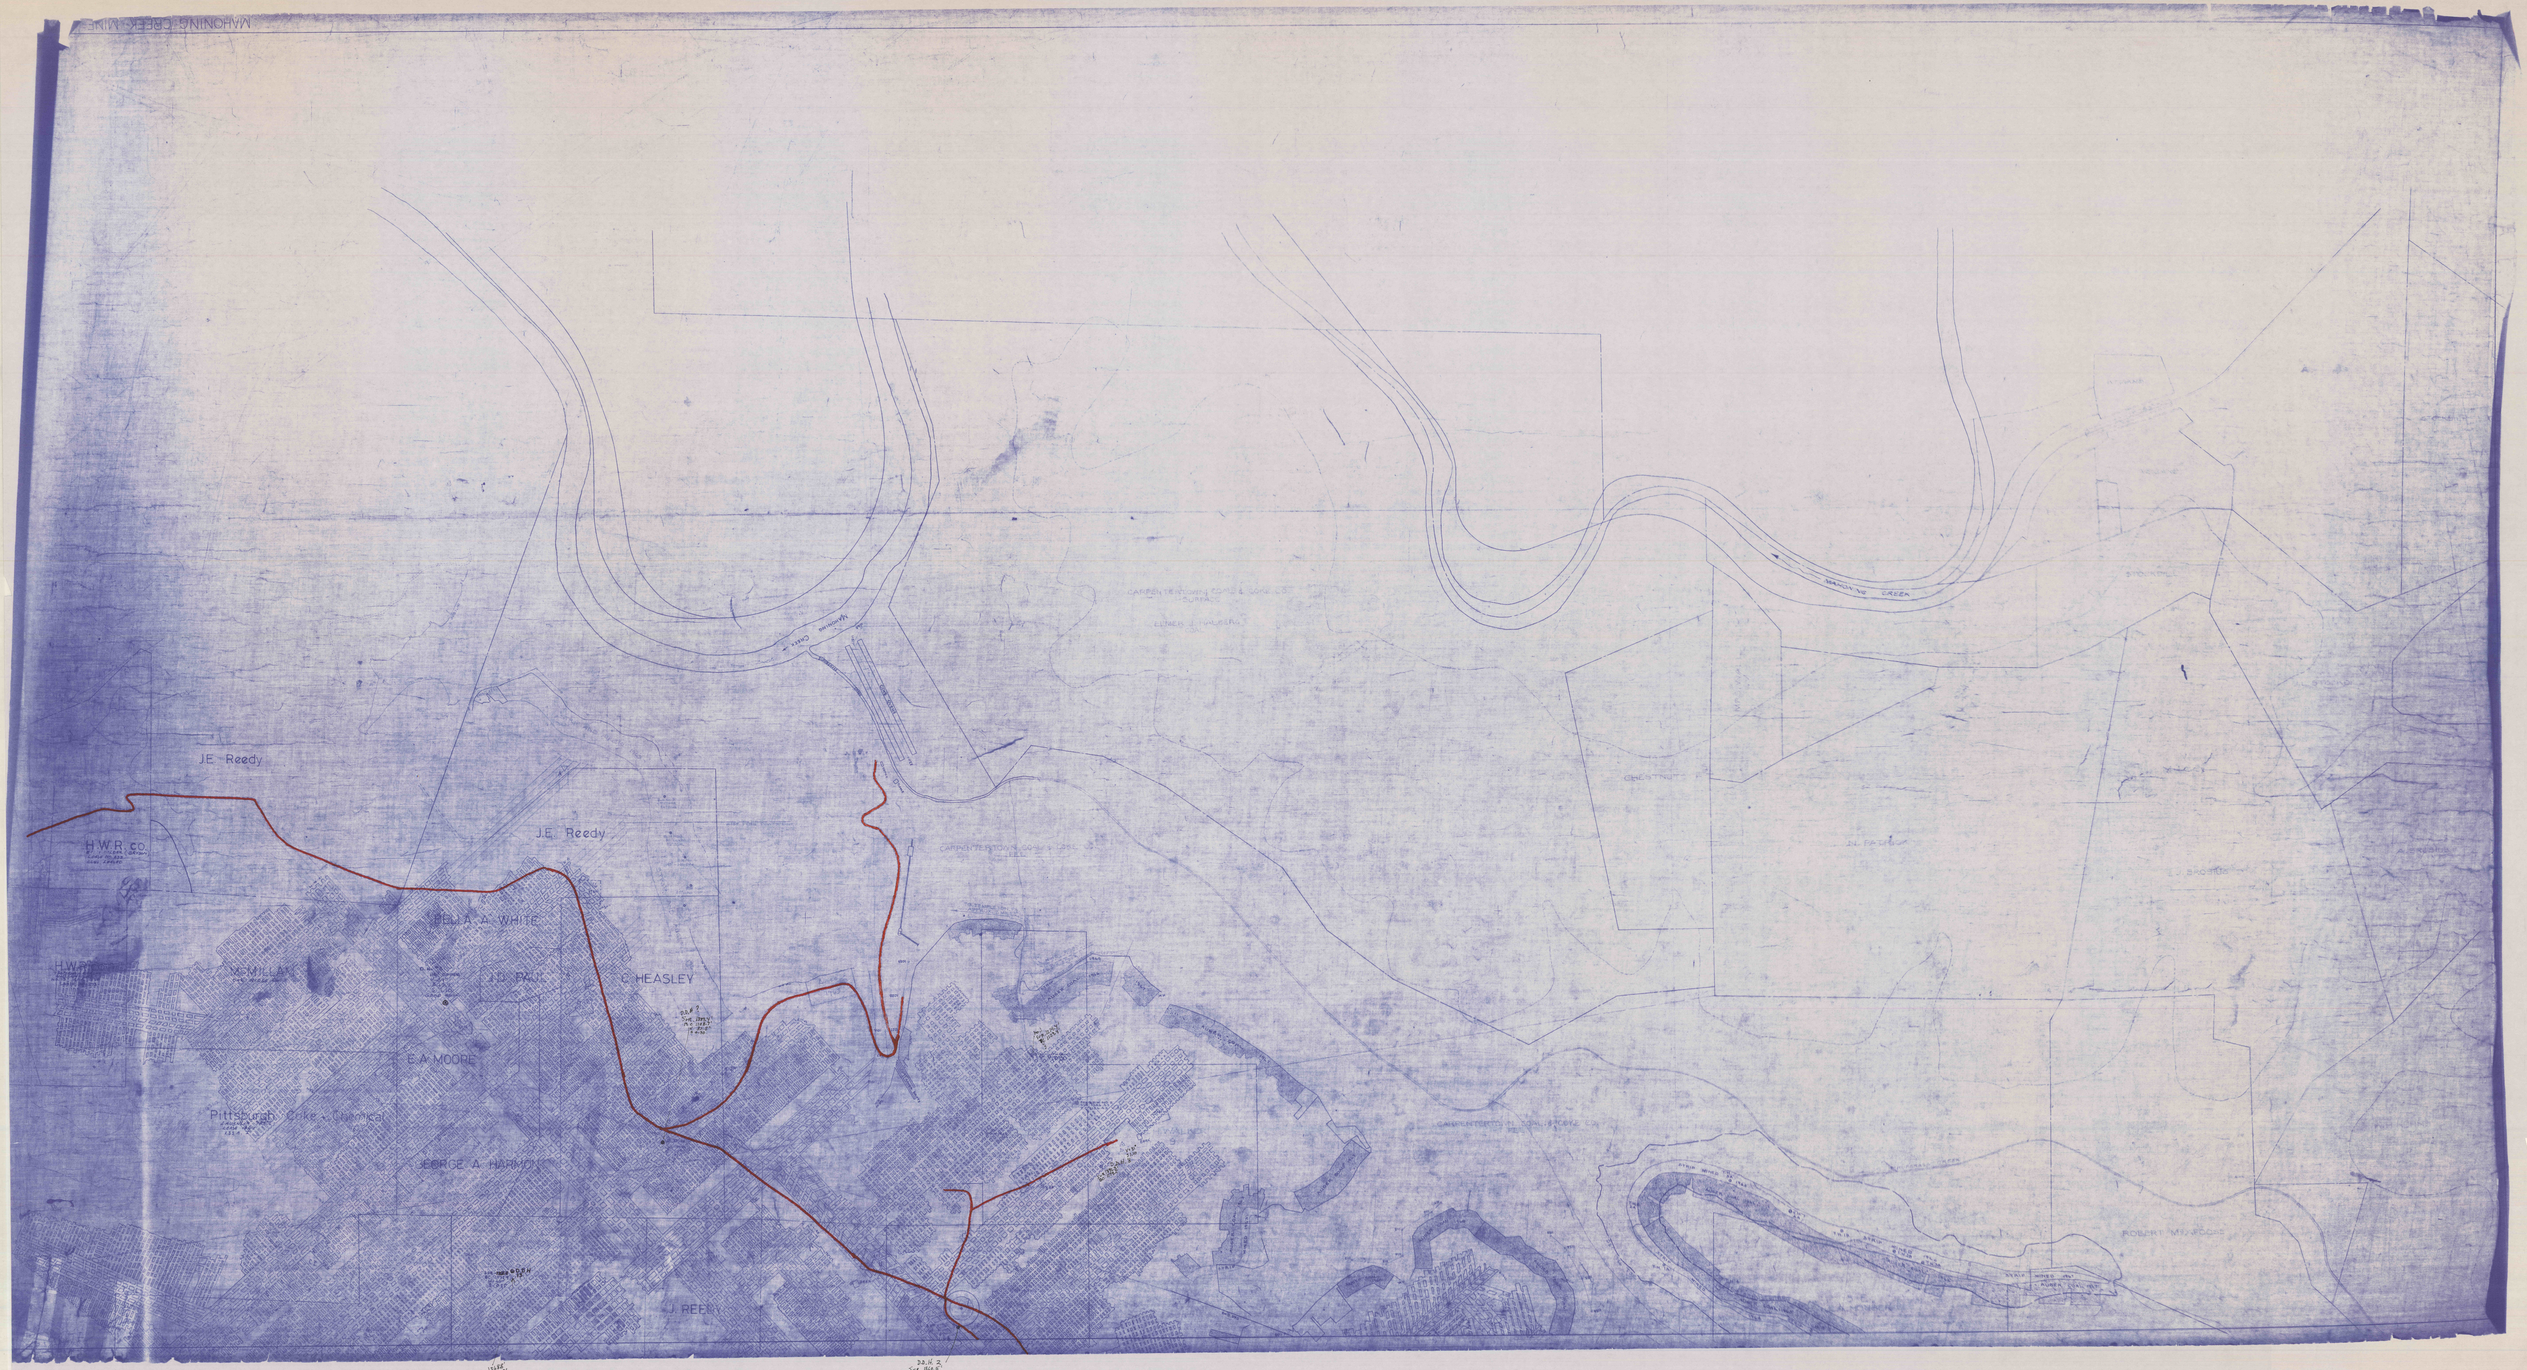
MAHONING CREEK
J.E. Reedy
H.W.R. CO.
J.E. Reedy
HELLA A. WHITE
McMILLAN
J.D. PAUL
C. HEASLEY
E.A. MOORE
Pittsburgh Coke & Chemical
GEORGE A. HARMON
J. REEDY
CARPENTERTOWN COAL & COKE CO.
ROBERT MILWOOD