

F. 1934

To MONTICELLO

The "Six Foot Area"

APPROXIMATE

APPROXIMATE

VEIN

FREEPORT

BONNER
(Royalty)


HEIRS.

J. B. RUFFNER

LOCATION

OUTCROP

UPPER

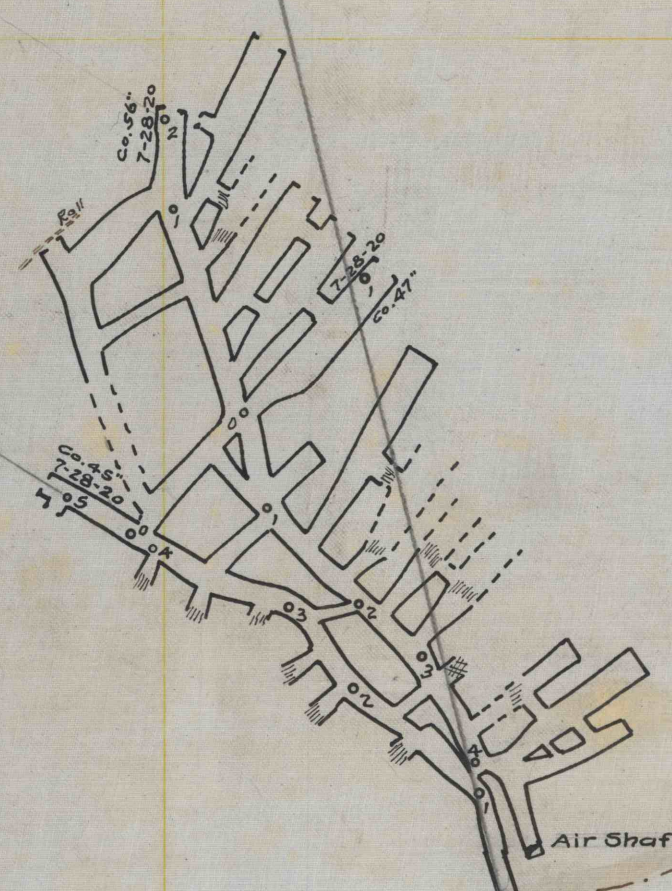

JAS. S. TOY
5 A.
(owned in fee)

B. R. & P. RY.

L.K. Vein openings.

To W. MORGENTHAU

Zone N.

Scale E