



2000'

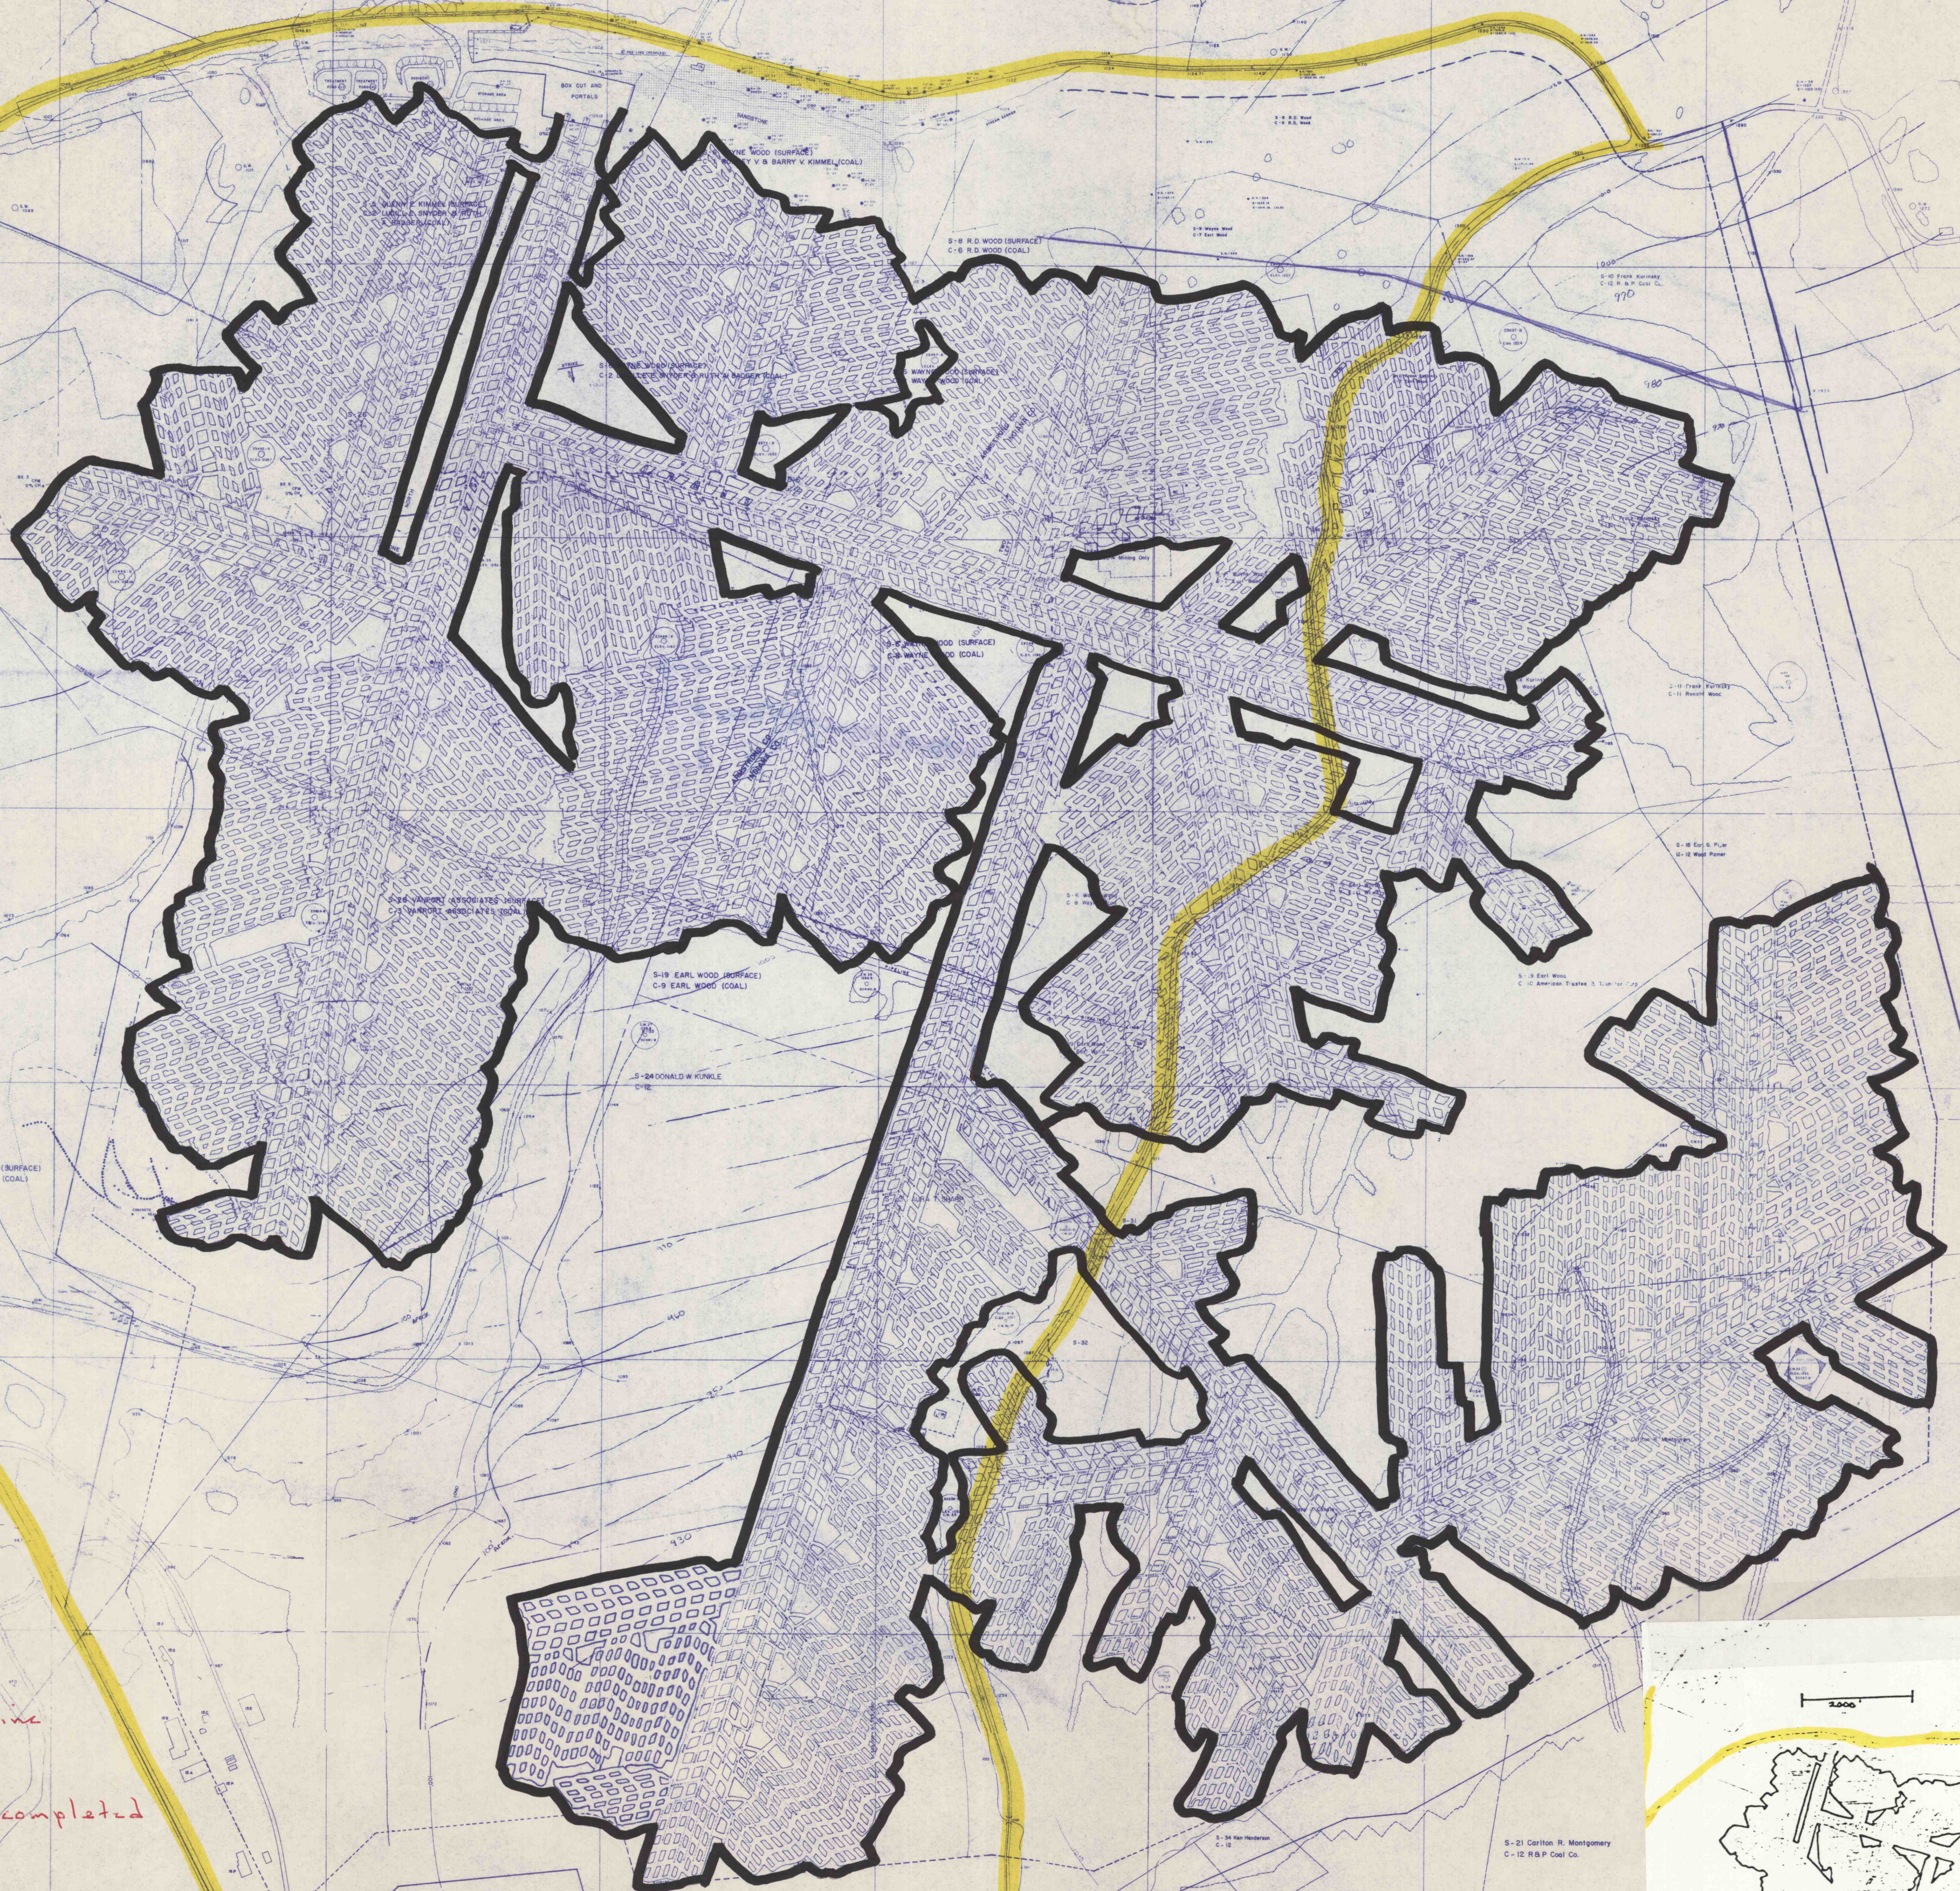

Dormac No. 1 Deep Mine  
Scale: 1" = 400'  
Final Map - Site is completed  
ELBERTON QUAD.  
E. Seam

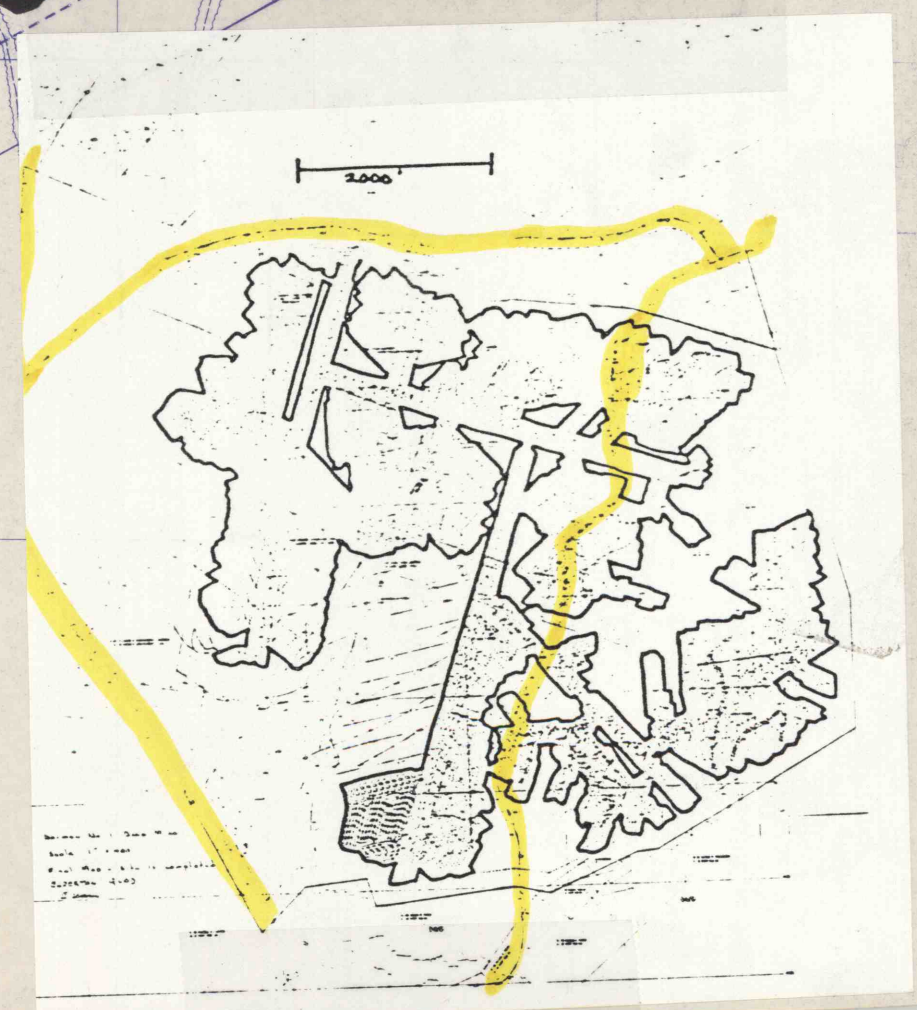

S-25 RUSSELL E. LAWTON  
C-12 R&P Coal Co.

S-04 David W. Kunkle  
C-12 R&P Coal Co.

S-22 Anthony J. Condo  
C-12 R&P Coal Co.

S-21 Carlton R. Montgomery  
C-12 R&P Coal Co.

S-28 William S. Rife  
C-12 R&P Coal Co.