


# EMILIE NO 4 UPPER FREEPORT COAL

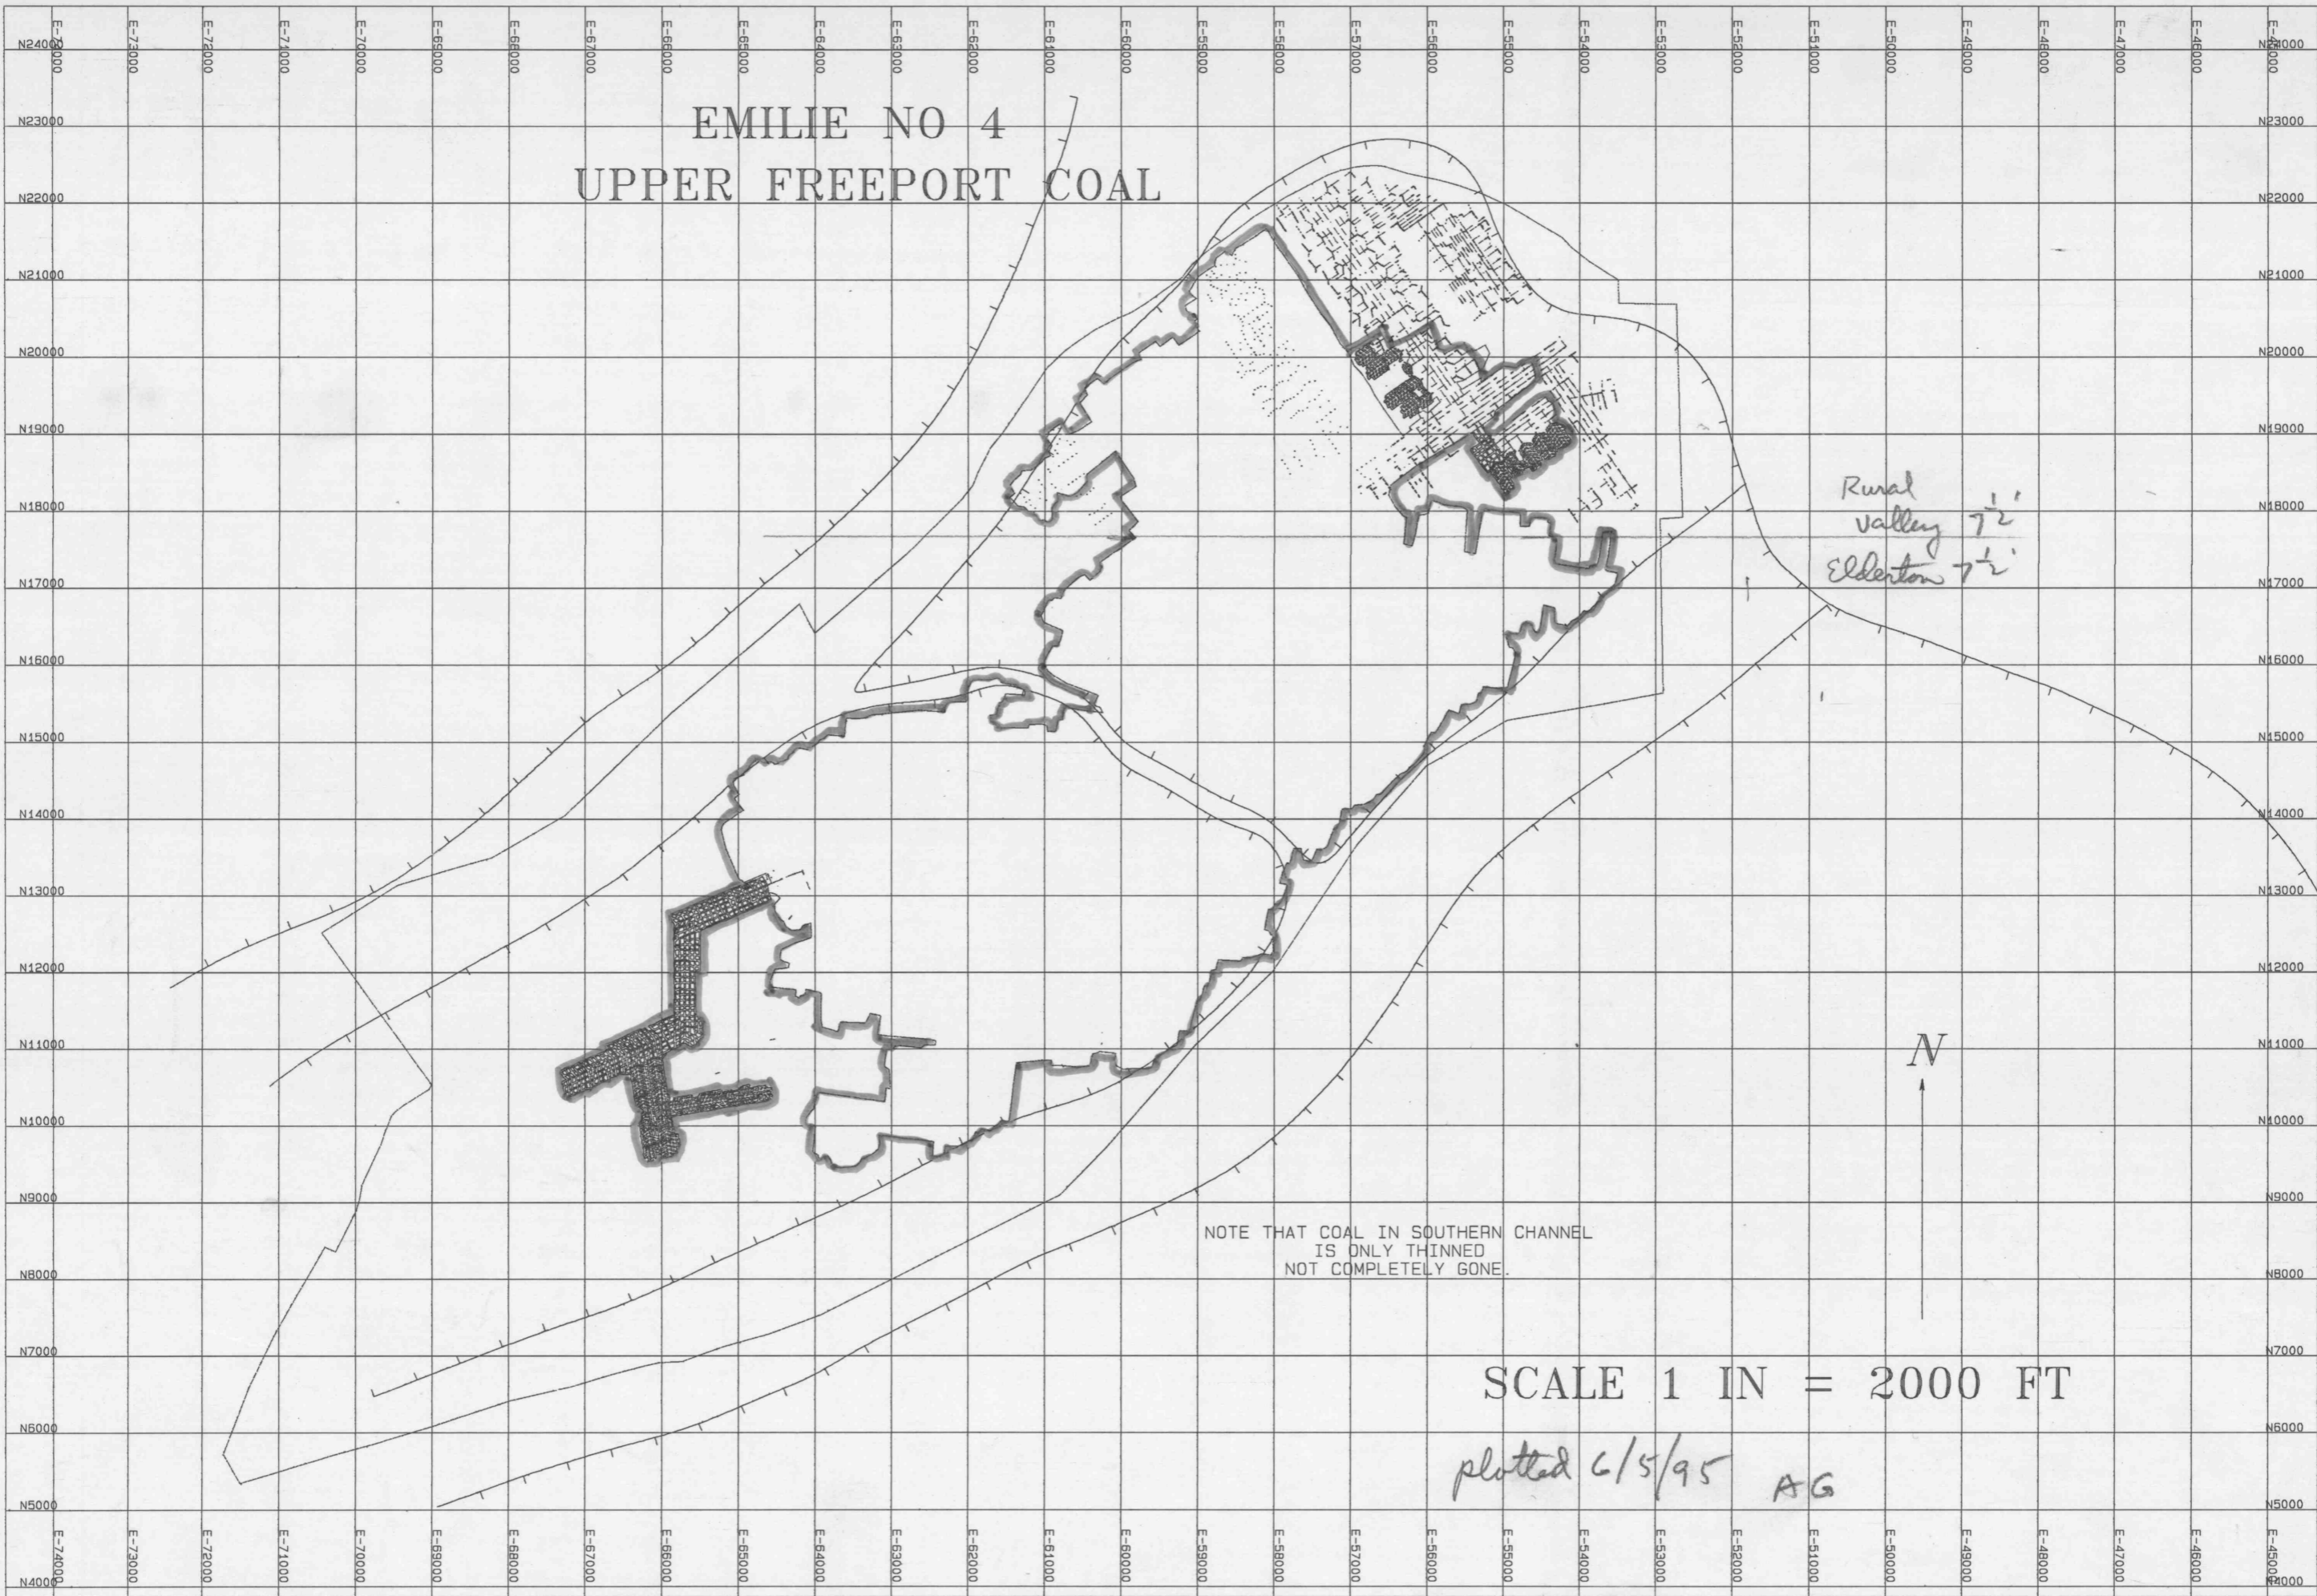

NOTE THAT COAL IN SOUTHERN CHANNEL  
IS ONLY THINNED  
NOT COMPLETELY GONE.

SCALE 1 IN = 2000 FT

*plotted 6/5/95 AG*

*Rural Valley 7 1/2  
Elderton 7 1/2*