


PORTAL

MARGARET NO. 11 #2 MINE

SCALE 1" : 400'

MARGARET #11 NO. 2

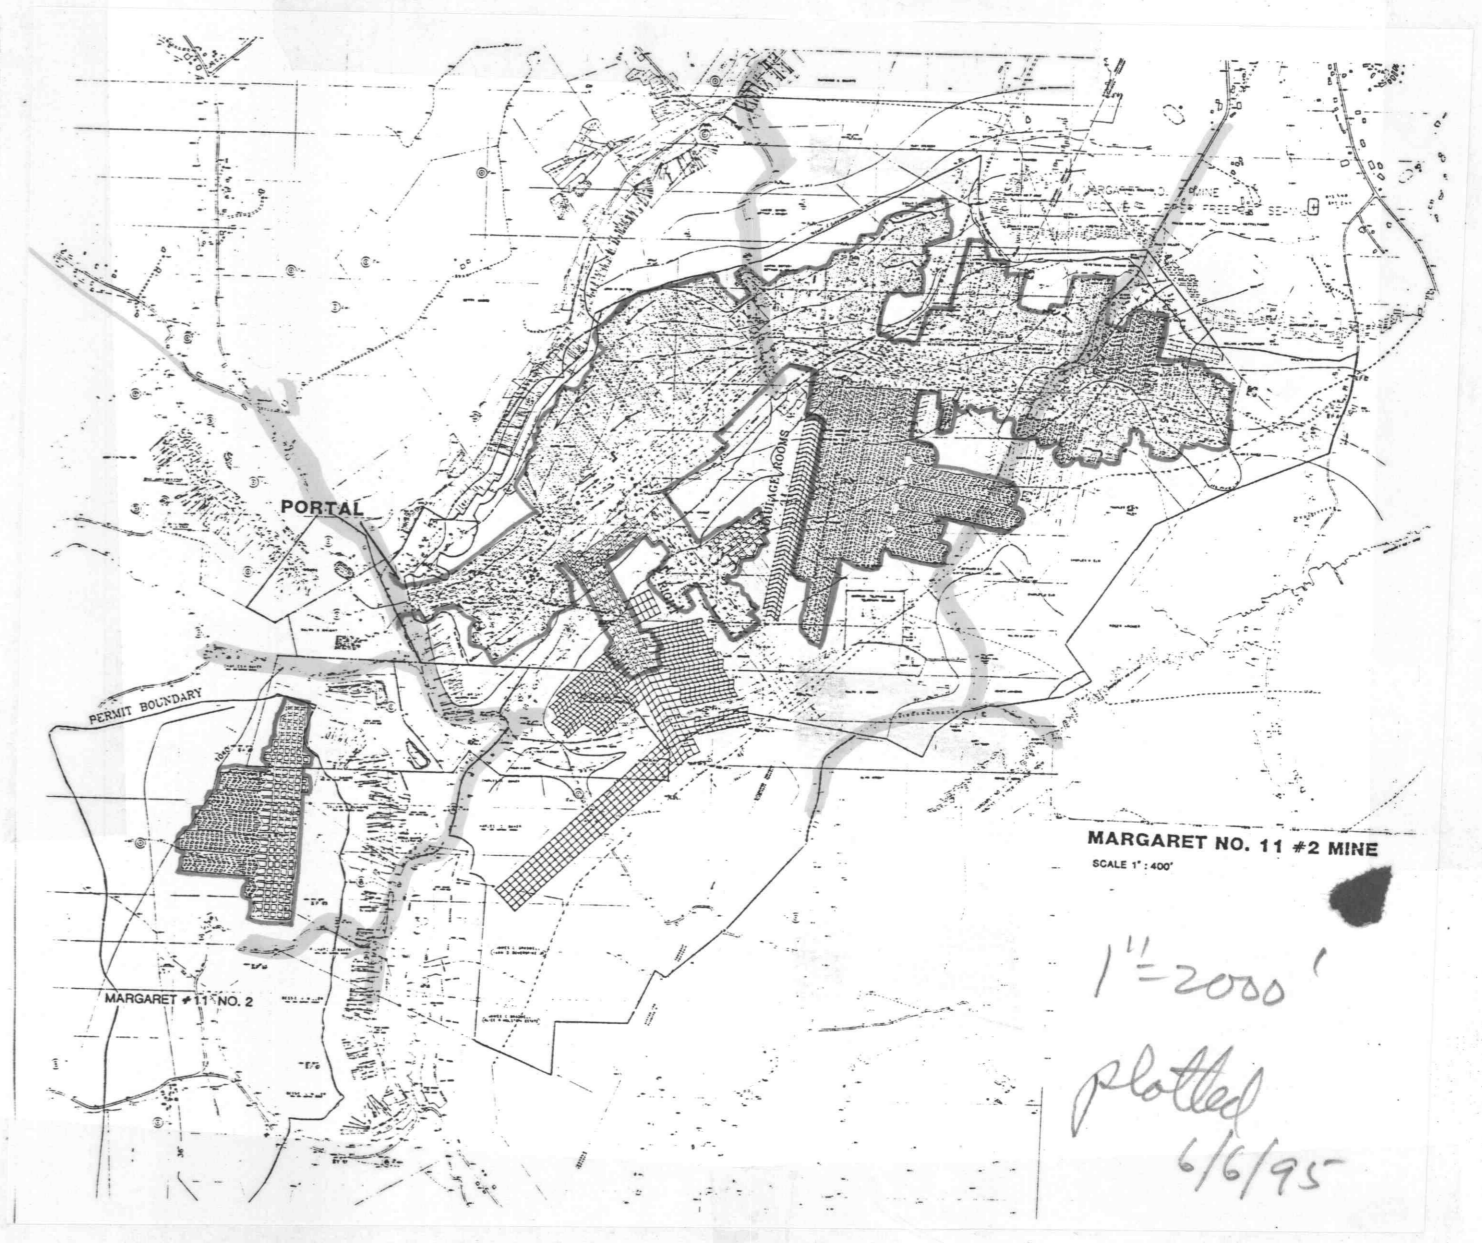

MARGARET NO. 11 #2 MINE
SCALE 1" = 2000'
plotted
6/6/95