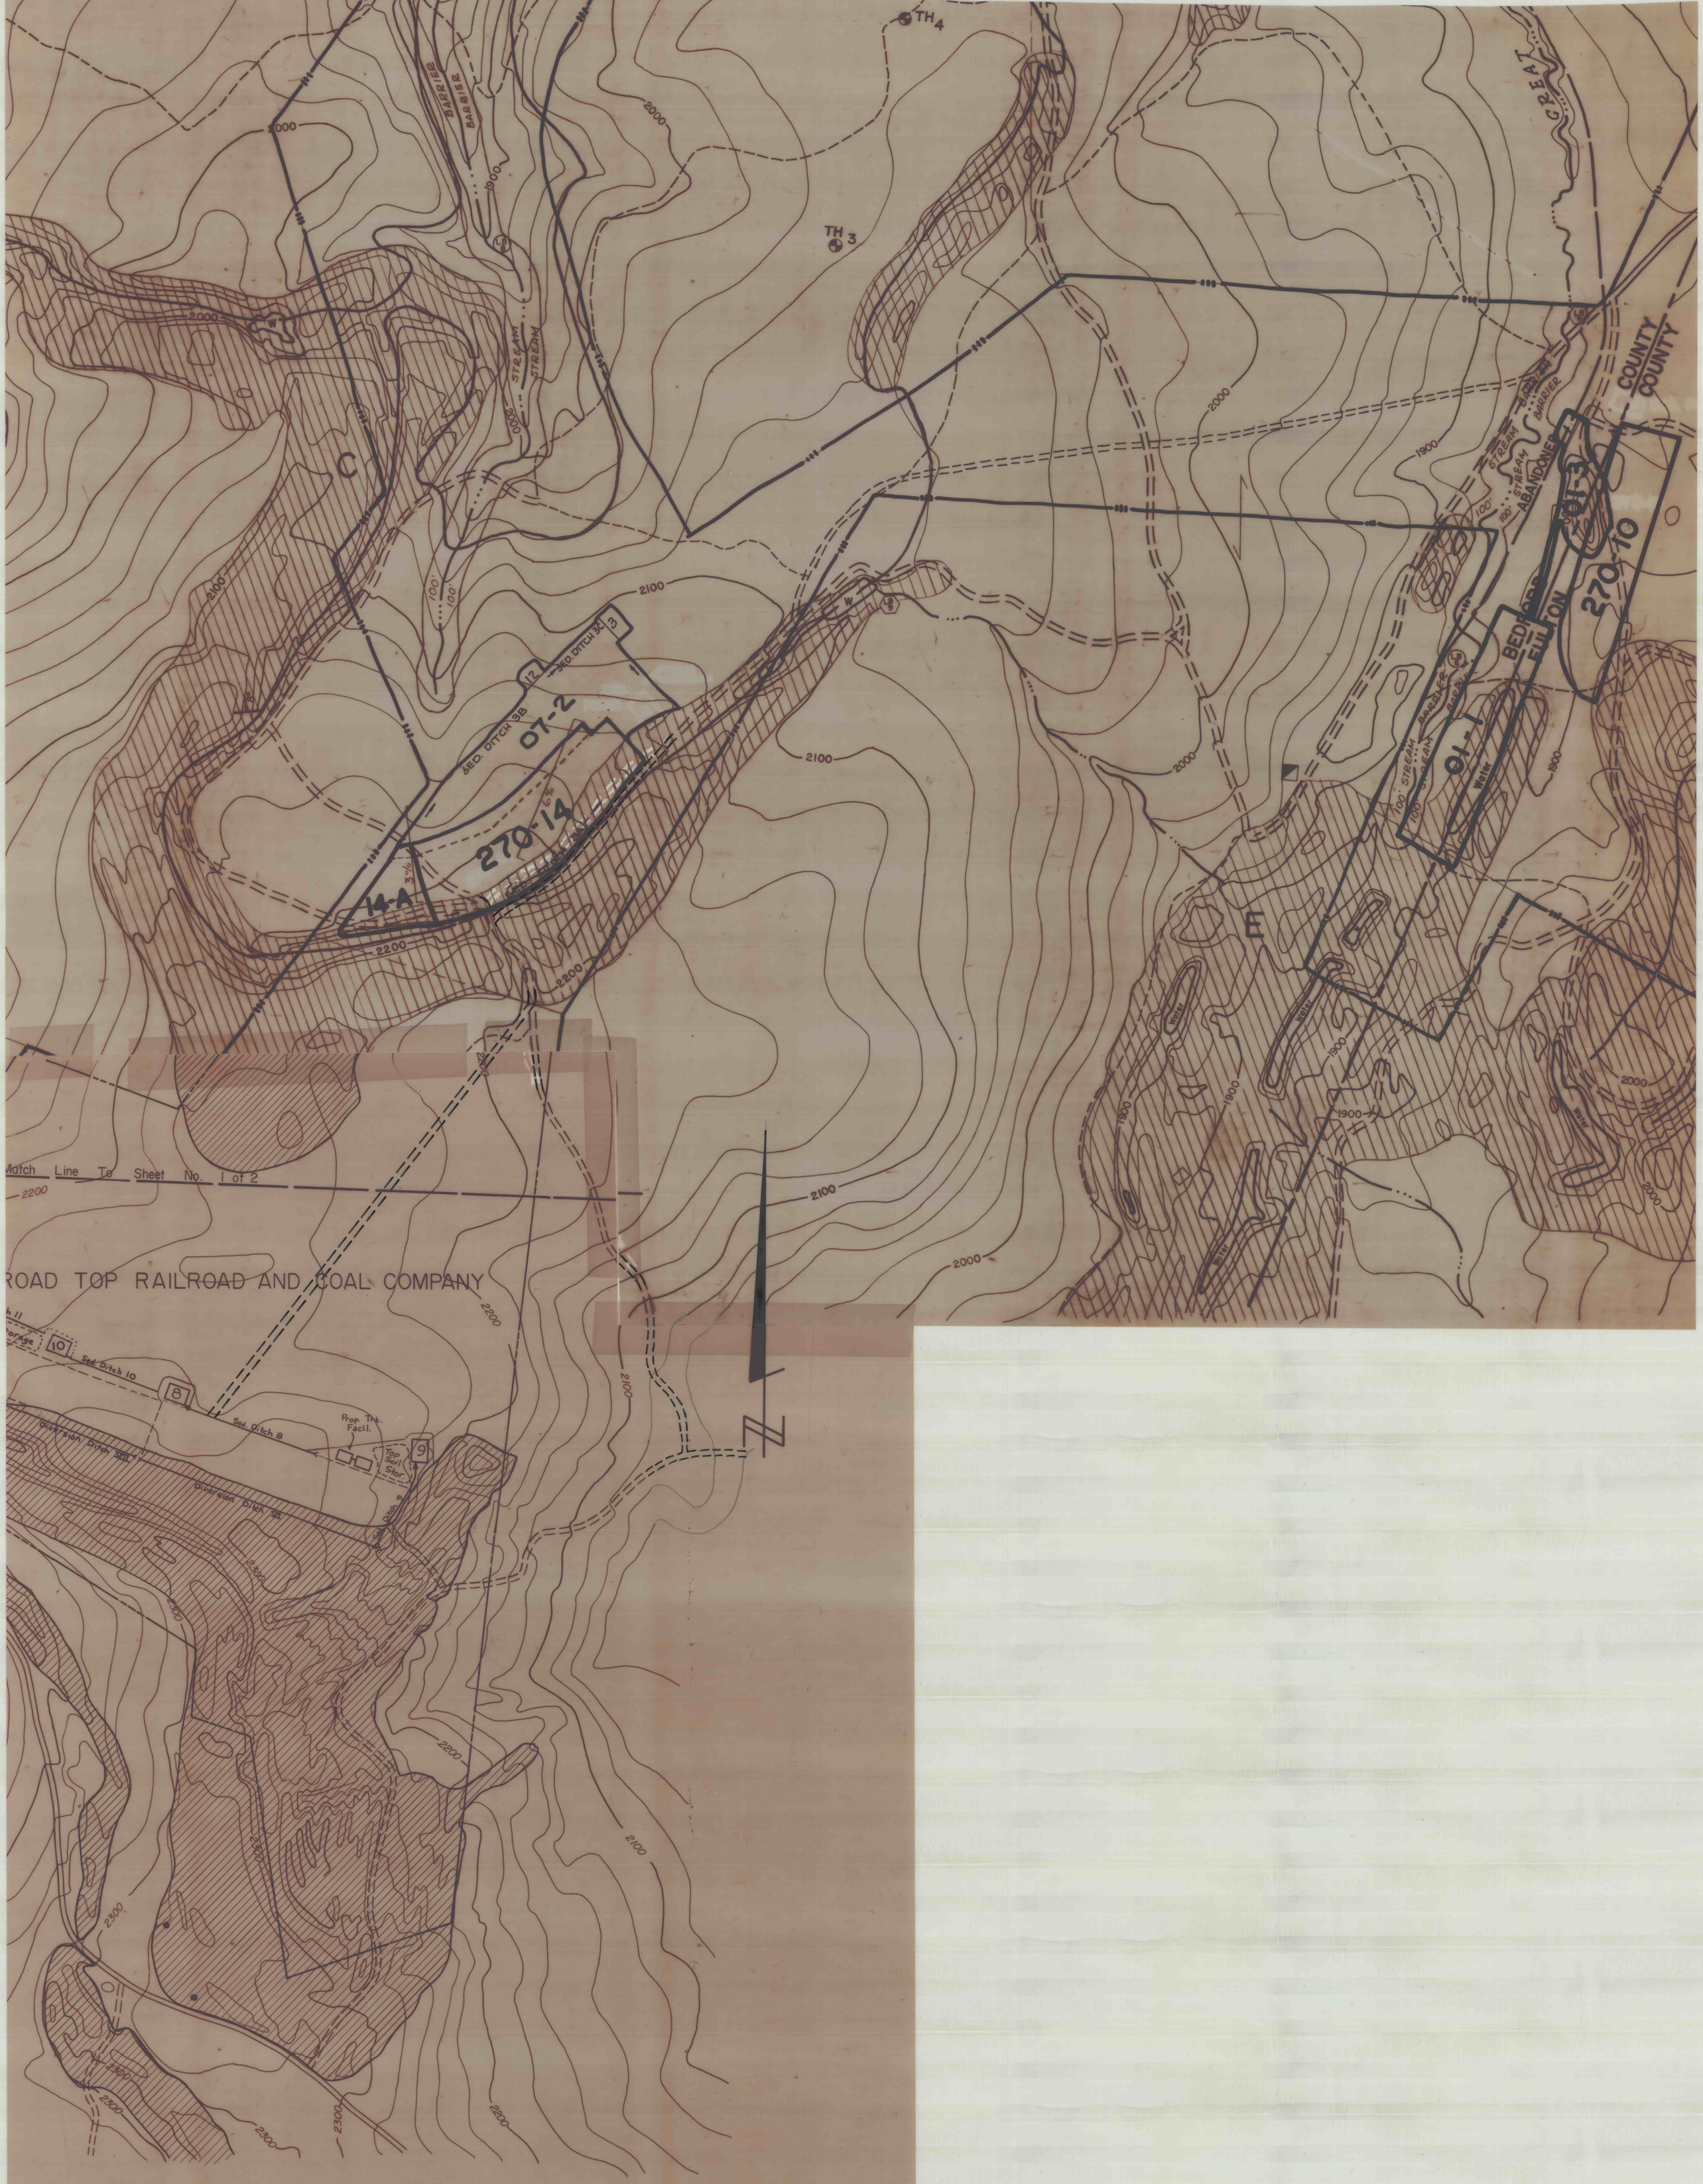

EXHIBIT - IV

9-2-83
2-3-83
Rev. 3-30-82

MP 100270-4274SM12-04-0

g Area

port Area

10.3 Ac. Prop. Mining Area

5.9 Ac. Prop. Support Area

16.2 Ac. TOTAL

L & B COAL COMPANY

BITUMINOUS COAL STRIPPING OPERATION

SITUATE

BROAD TOP TWP., BEDFORD CO., WELLS TWP., FULTON CO.

&

WOOD TWP., HUNTINGDON CO., PENNSYLVANIA

MAY, 1981

SCALE	GWIN, DOBSON & FOREMAN, INC.	SHEET NO.
1"=400'	CONSULTING ENGINEERS ALTOONA · PENNSYLVANIA	2 of 2