


LIST OF NUMBERED MINES ON MAP.

- |                                    |   |  |  |
|------------------------------------|---|--|--|
| 1. GORDON MINE.                    | 26. KEMMAN MINE.                                  | 51. ROBERTSDALE MINE, NO. 1.                 | 76. MT. EQUITY MINE, NO. 1.                  |
| 2. OLD CUMBERLAND MINE.            | 27. DIVAL SLOPE.                                  | 52. ROBERTSDALE MINE, NO. 2.                 | 77. ROCK BAR MINE, BARNETT.                  |
| 3. OLD PROSPECT MINE.              | 28. OLD DUFFY SHAFT.                              | 53. ROBERTSDALE MINE, NO. 3.                 | 78. ROCK BAR MINE, KELLY.                    |
| 4. MILLER MINES, FULTON NO. 1.     | 29. OLD WHITON MINE AND CUNARD SHAFT.             | 54. WOODVALE SHAFT.                          | 79. JUSTH MINE.                              |
| 5. MILLER MINES, BARNETT NO. 1.    | 30. ILLINOIS MINE, NO. 1.                         | 55. WILLIAM ALLOWAY MINE.                    | 80. OLD PARROTT MINE.                        |
| 6. MILLER MINES, BARNETT NO. 2.    | 31. ILLINOIS MINE, NO. 2.                         | 56. OLD HAMILTON & HORTON MINE.              | 81. DURHAM MINE, NO. 1.                      |
| 7. MILLER MINES, BARNETT NO. 3.    | 32. ILLINOIS MINE, NO. 3.                         | 57. A. J. WISHART MINE.                      | 82. YANKES GULF OPENING TO DIVAL SLOPE MINE. |
| 8. OLD HOWE MINE.                  | 33. CRESCENT MINE, NO. 1.                         | 58. MT. EQUITY MINE, NO. 2.                  |  |
| 9. MELROSE MINES, NO. 1.           | 34. CRESCENT MINE, NO. 2.                         | 59. ROCK BAR MINE, KELLY.                    |  |
| 10. MELROSE MINES, MITCHELL.       | 35. CRESCENT MINE, NO. 3.                         | 60. JUSTH MINE.                              |  |
| 11. MELROSE MINES, NO. 1.          | 36. OLD SCOTT SHAFT.                              | 61. OLD PARROTT MINE.                        |  |
| 12. BENEDICT MINES, HOLLYHOCK.     | 37. DELAWARE MINE, NO. 1.                         | 62. DURHAM MINE, NO. 2.                      |  |
| 13. BENEDICT MINES, BARNETT NO. 1. | 38. DELAWARE MINE, NO. 2.                         | 63. YANKES GULF OPENING TO DIVAL SLOPE MINE. |  |
| 14. BENEDICT MINES, BARNETT NO. 2. | 39. DELAWARE MINE, NO. 3.                         | 64. PHIPPS MINE.                             |  |
| 15. BENEDICT MINES, GOOGOOD.       | 40. DELAWARE MINE, NO. 4.                         |  |  |
| 16. BENEDICT MINES, FULTON NO. 1.  | 41. HIGHLAND MINE, NO. 1.                         |  |  |
| 17. BENEDICT MINES, FULTON NO. 2.  | 42. THE OLD BEE HIVE MINE.                        |  |  |
| 18. BENEDICT MINES, BARNETT NO. 3. | 43. BACON MINE, NO. 1.                            |  |  |
|                                    | 44. BACON MINE, NO. 2.                            |  |  |
|                                    | 45. CUBA MINE.                                    |  |  |
|                                    | 46. BARTLE MINE, NO. 1.                           |  |  |
|                                    | 47. CUBA MINE.                                    |  |  |
|                                    | 48. PEARUT MINE.                                  |  |  |
|                                    | 49. SHERREYS RUN MINE, PLANE.                     |  |  |
|                                    | 50. SHERREYS RUN MINE, NEW PLANE (ROCK ADIT).     |  |  |
|                                    | 51. ALBERT FIGARD MINE.                           |  |  |
|                                    | 52. CAMBRIA MINE, NO. 1.                          |  |  |
|                                    | 53. OLD ZETH & DODSON MINE, KELLY.                |  |  |
|                                    | 54. OLD ZETH & DODSON MINE, ROCK ADIT TO KELLY.   |  |  |
|                                    | 55. OLD ZETH & DODSON MINE, ROCK ADIT TO BARNETT. |  |  |
|                                    | 56. A. KAWWAY TO CAMBRIA MINE, NO. 1.             |  |  |
|                                    | 57. OLD SLOPE TO CAMBRIA MINE, NO. 1.             |  |  |
|                                    | 58. CAMBRIA MINE, NO. 2.                          |  |  |
|                                    | 59. OLD CRESCENT MINE.                            |  |  |
|                                    | 60. OLD CHEVINGTON MINE, NO. 4.                   |  |  |
|                                    | 61. NEW CHEVINGTON MINE.                          |  |  |
|                                    | 62. CAMBRIA MINE, NO. 3.                          |  |  |
|                                    | 63. OLD CUMBERLAND MINE.                          |  |  |
|                                    | 64. CHEVINGTON MINE, NO. 3.                       |  |  |
|                                    | 65. GLENDALE MINE, NO. 1.                         |  |  |

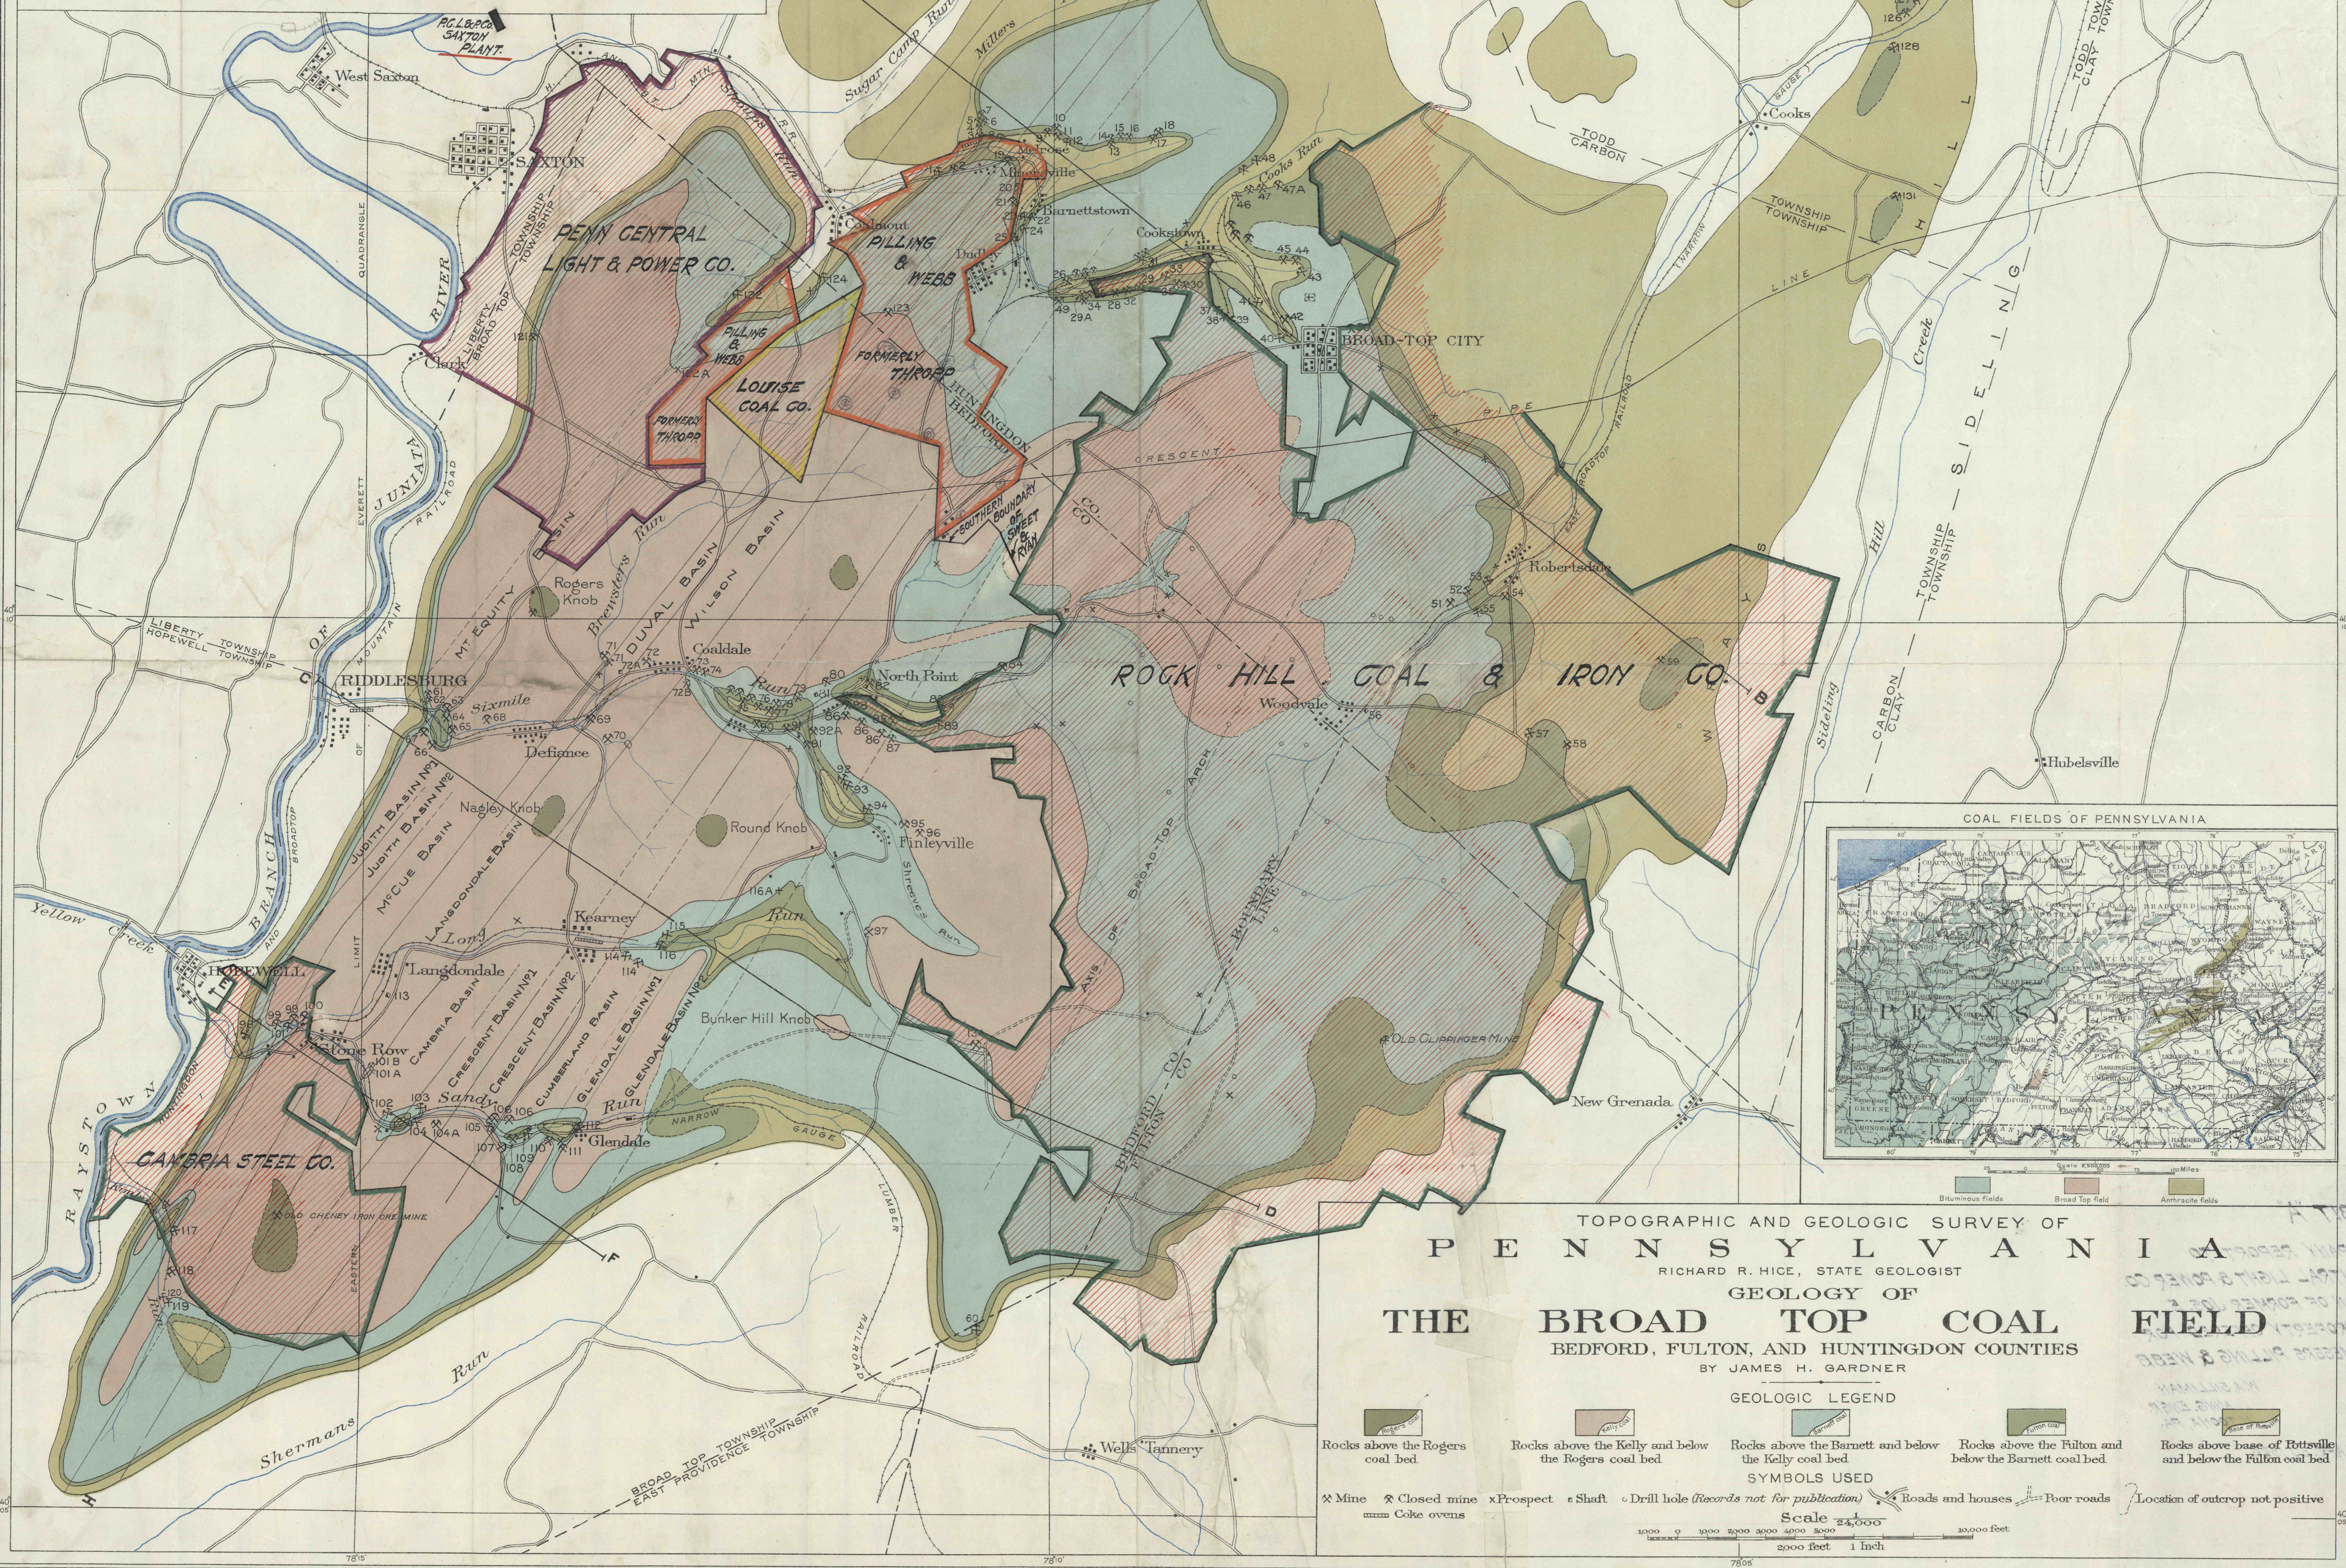

TOPOGRAPHIC AND GEOLOGIC SURVEY OF  
**PENNSYLVANIA**  
 RICHARD R. HICE, STATE GEOLOGIST  
 GEOLOGY OF  
**THE BROAD TOP COAL FIELD**  
 BEDFORD, FULTON, AND HUNTINGDON COUNTIES  
 BY JAMES H. GARDNER

**GEOLOGIC LEGEND**

--	--	--	--	--

**SYMBOLS USED**

--	--	--	--	--	--	--	--

**Scale**  
