

JAS. M. McINTYRE & CO.


OWNED AS  
DOTTED OUT  
GROUND BY  
REAL RESIDENT

200' SCALE MAP OF BUNKER HILL COAL LANDS

PROPERTY LINES AS SHOWN ON

PUBLIC ROAD

PROPERTY LINES AS SHOWN ON

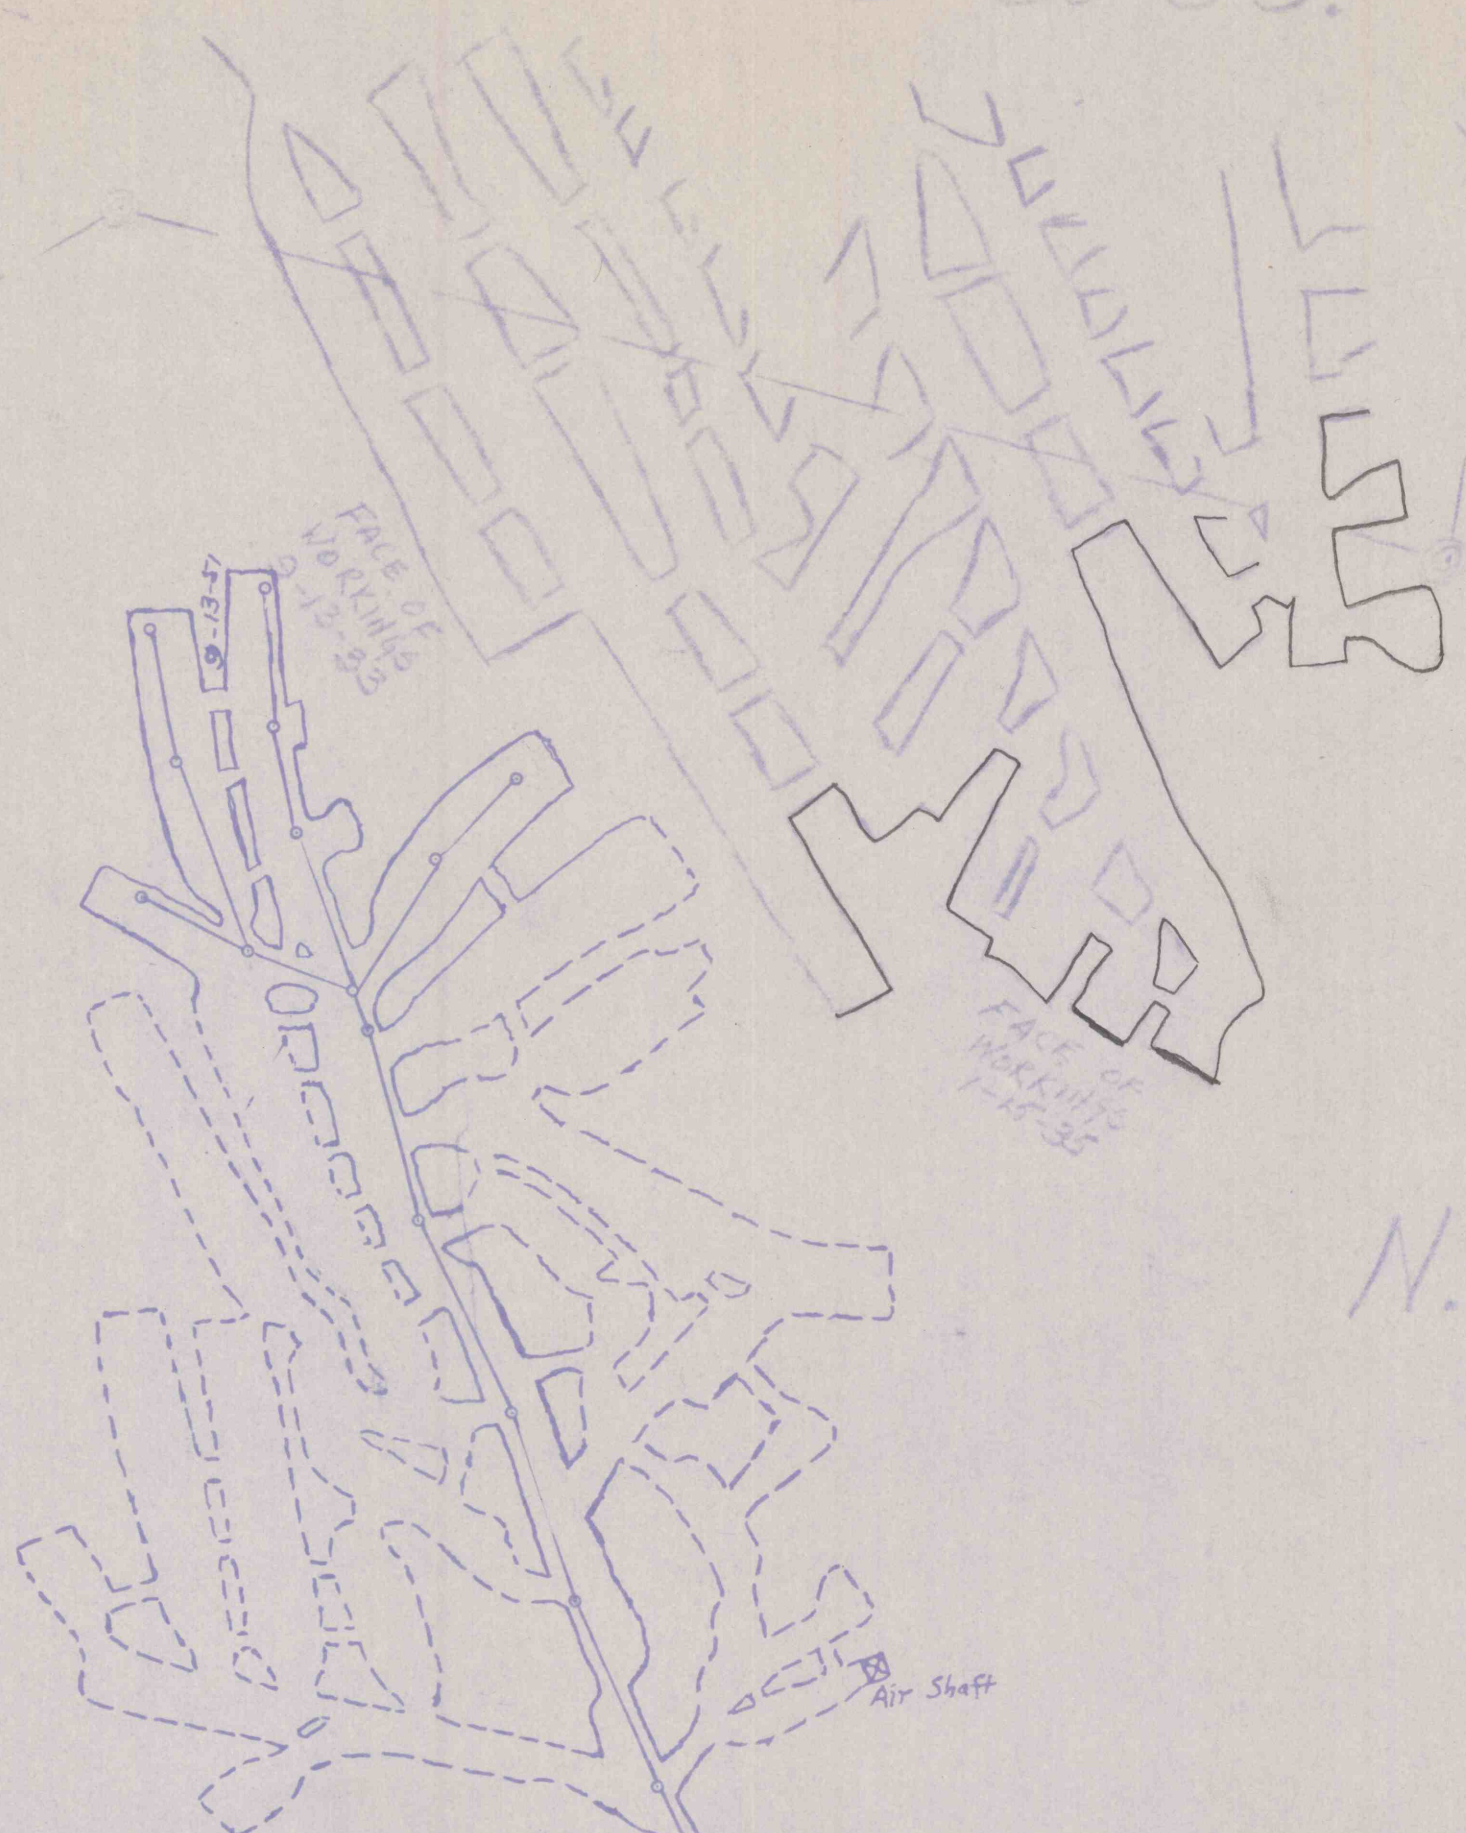

N.P.

ZETH

Print of Himes Mines shows long rooms, dotted-Not surveyed, which mined out this territory south of McINTYRE'S 2nd Right Heading

Note - Between these LINES Barnett Seam apparently worked out by Himes No. 1 and No. 2 drifts, but the workings of these Mines shown on Print marked Revised July 29, 1944 can not be made to fit after repeated attempts to do so.




FACE OF WORKINGS 5-17-34  
HIMES No. 1  
HEADING

FACE OF WORKINGS 5-25-41

POSSIBLE NORTH LINE OF HIMES  
CUT THRU

POSSIBLE SOUTH LINE OF HIMES No. 1

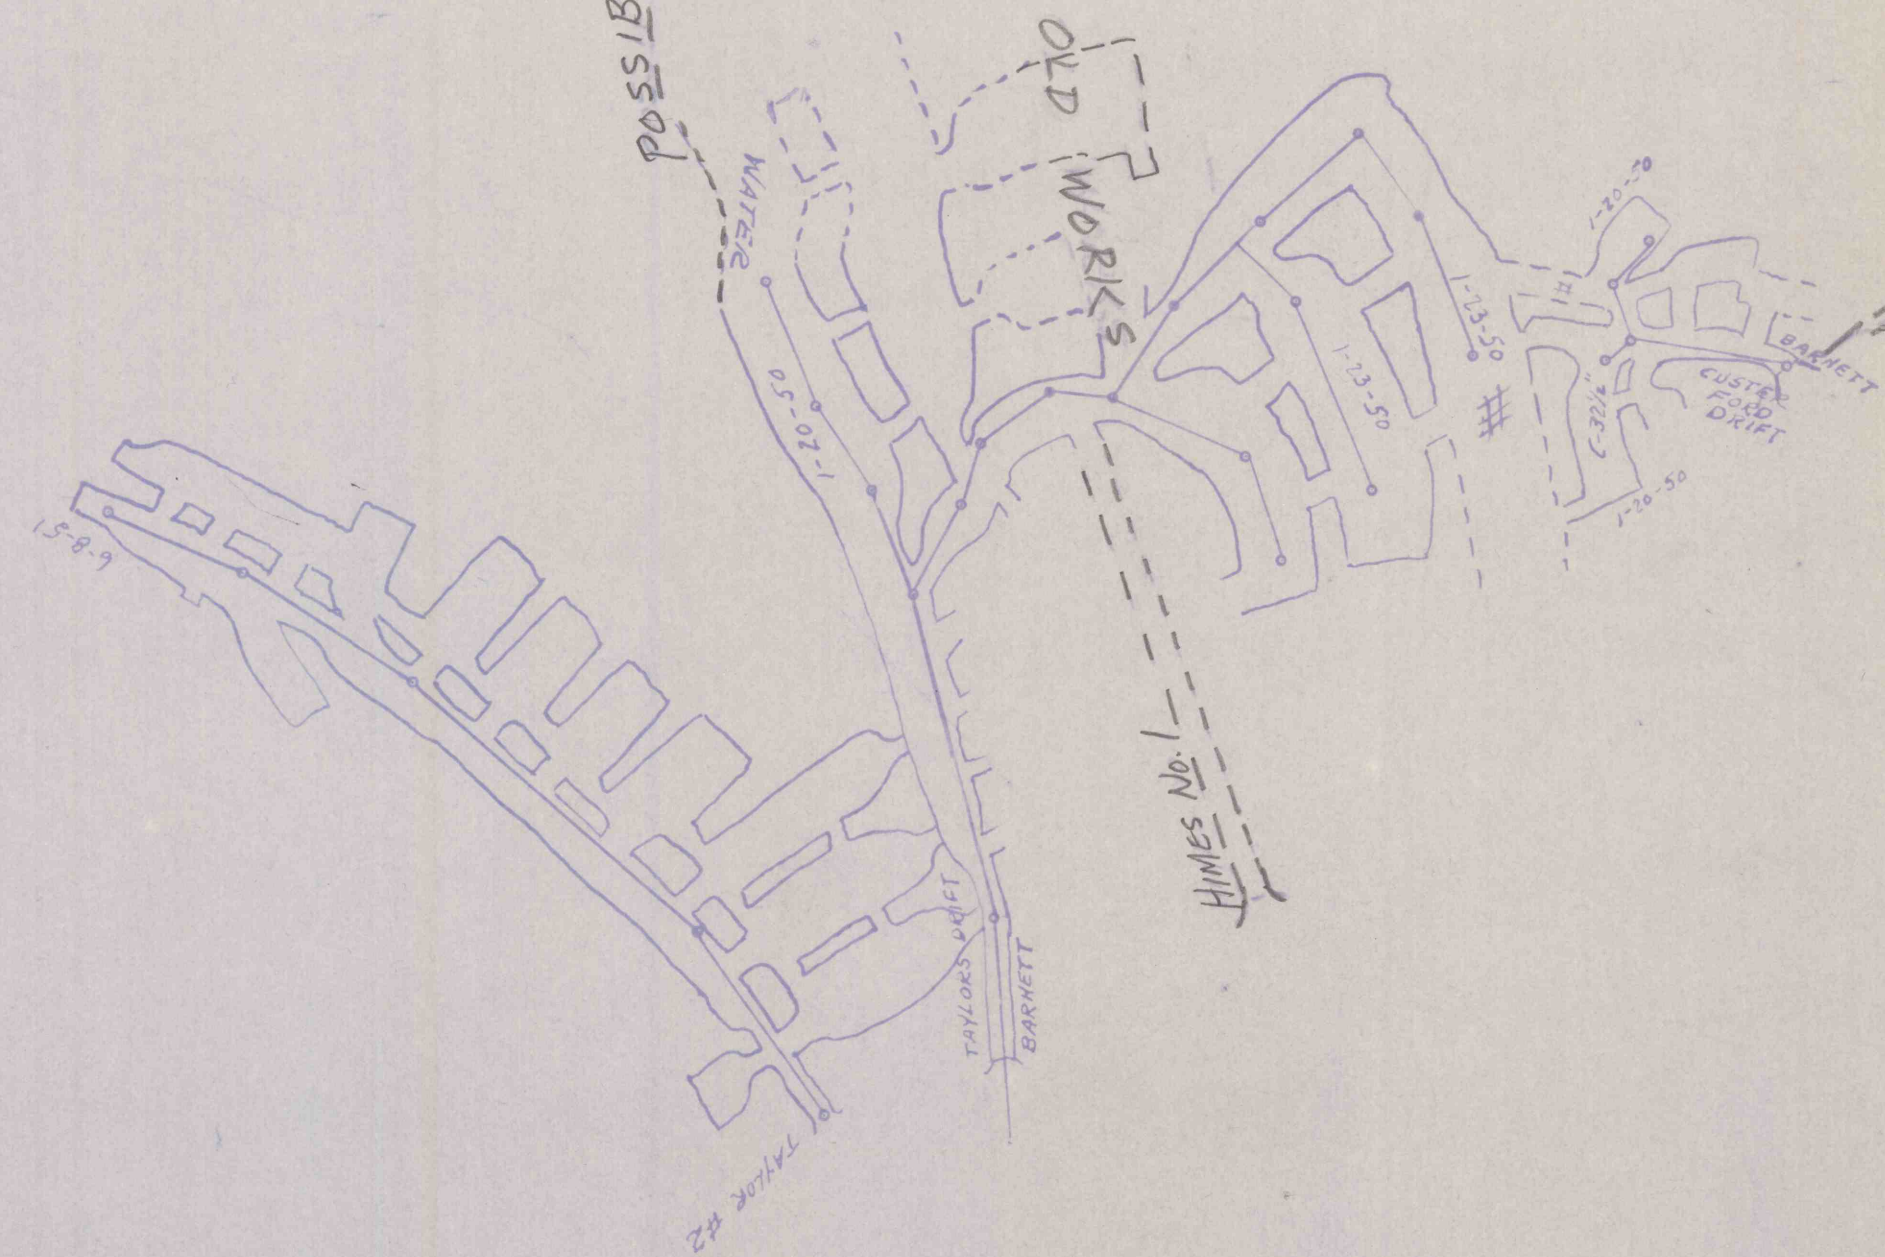

HIGH WALL