

352083

MICHAEL SIPES TRACT

MANWAY
15832

JOHN CESSNA TRACT

MANWAY

13906
KELLY
SEAM

13957

13926

13336

15003

MAP

CUMBERLAND MINE

SITUATE


SANDY RUN BEDFORD COUNTY PENNA.

SCALE: 1"=100' WOMELSDORF, DUNKLE & CUSTER, ENGRS.
PHILIPSBURG, PA.

REVISED TO MAY 19 1898

COPIED NOV. 24, 1925 BY W.A. SILLIMAN, ENGR.
ALTOONA, PA.

JOHN CHEVINGTON TRACT

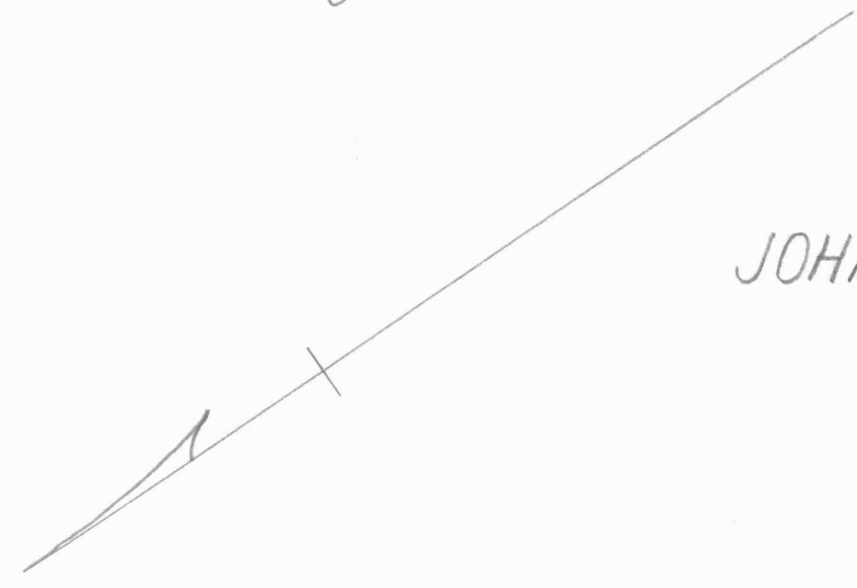

10 # 9AM