


MC-7

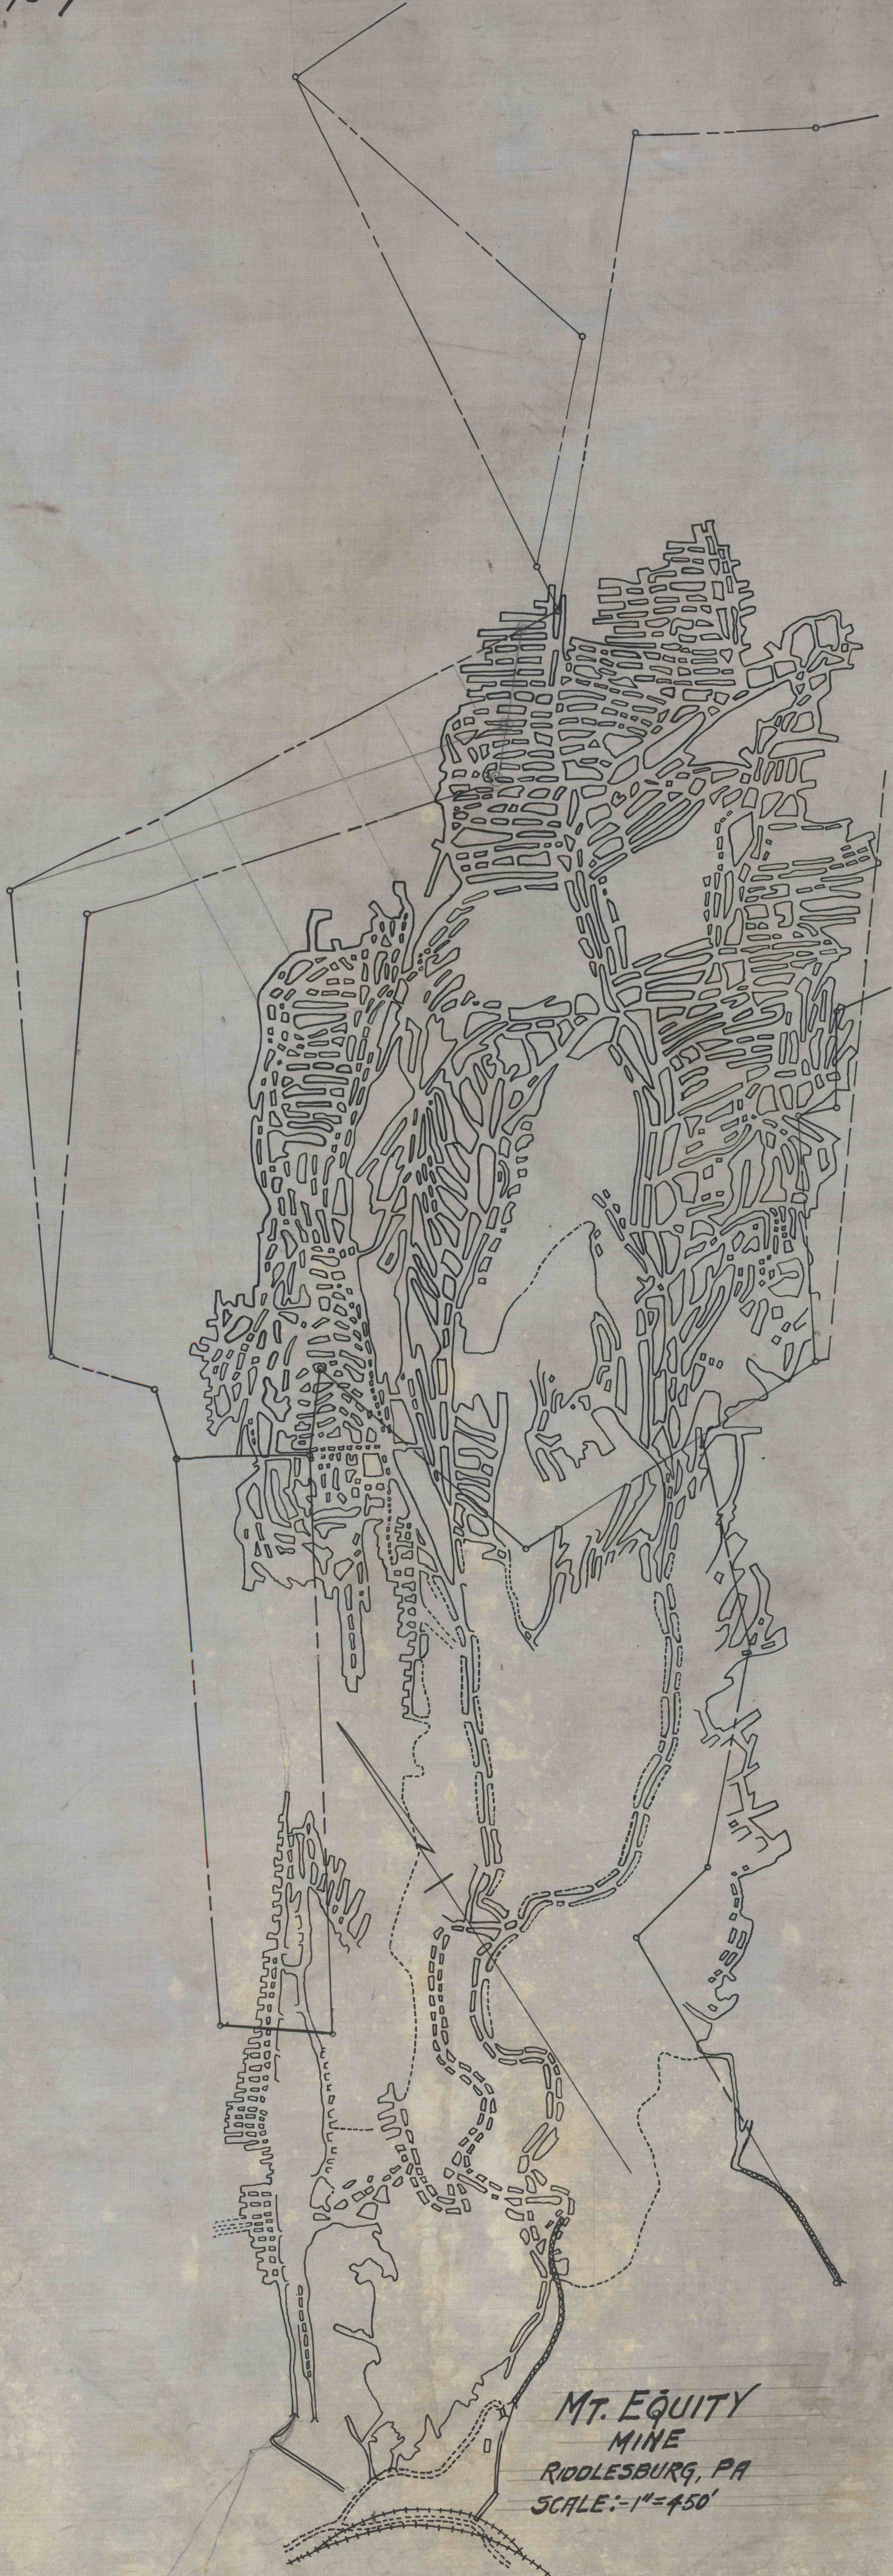

MT. EQUITY  
MINE  
RIDLESBURG, PA  
SCALE: -1"=450'

FILE MC-7