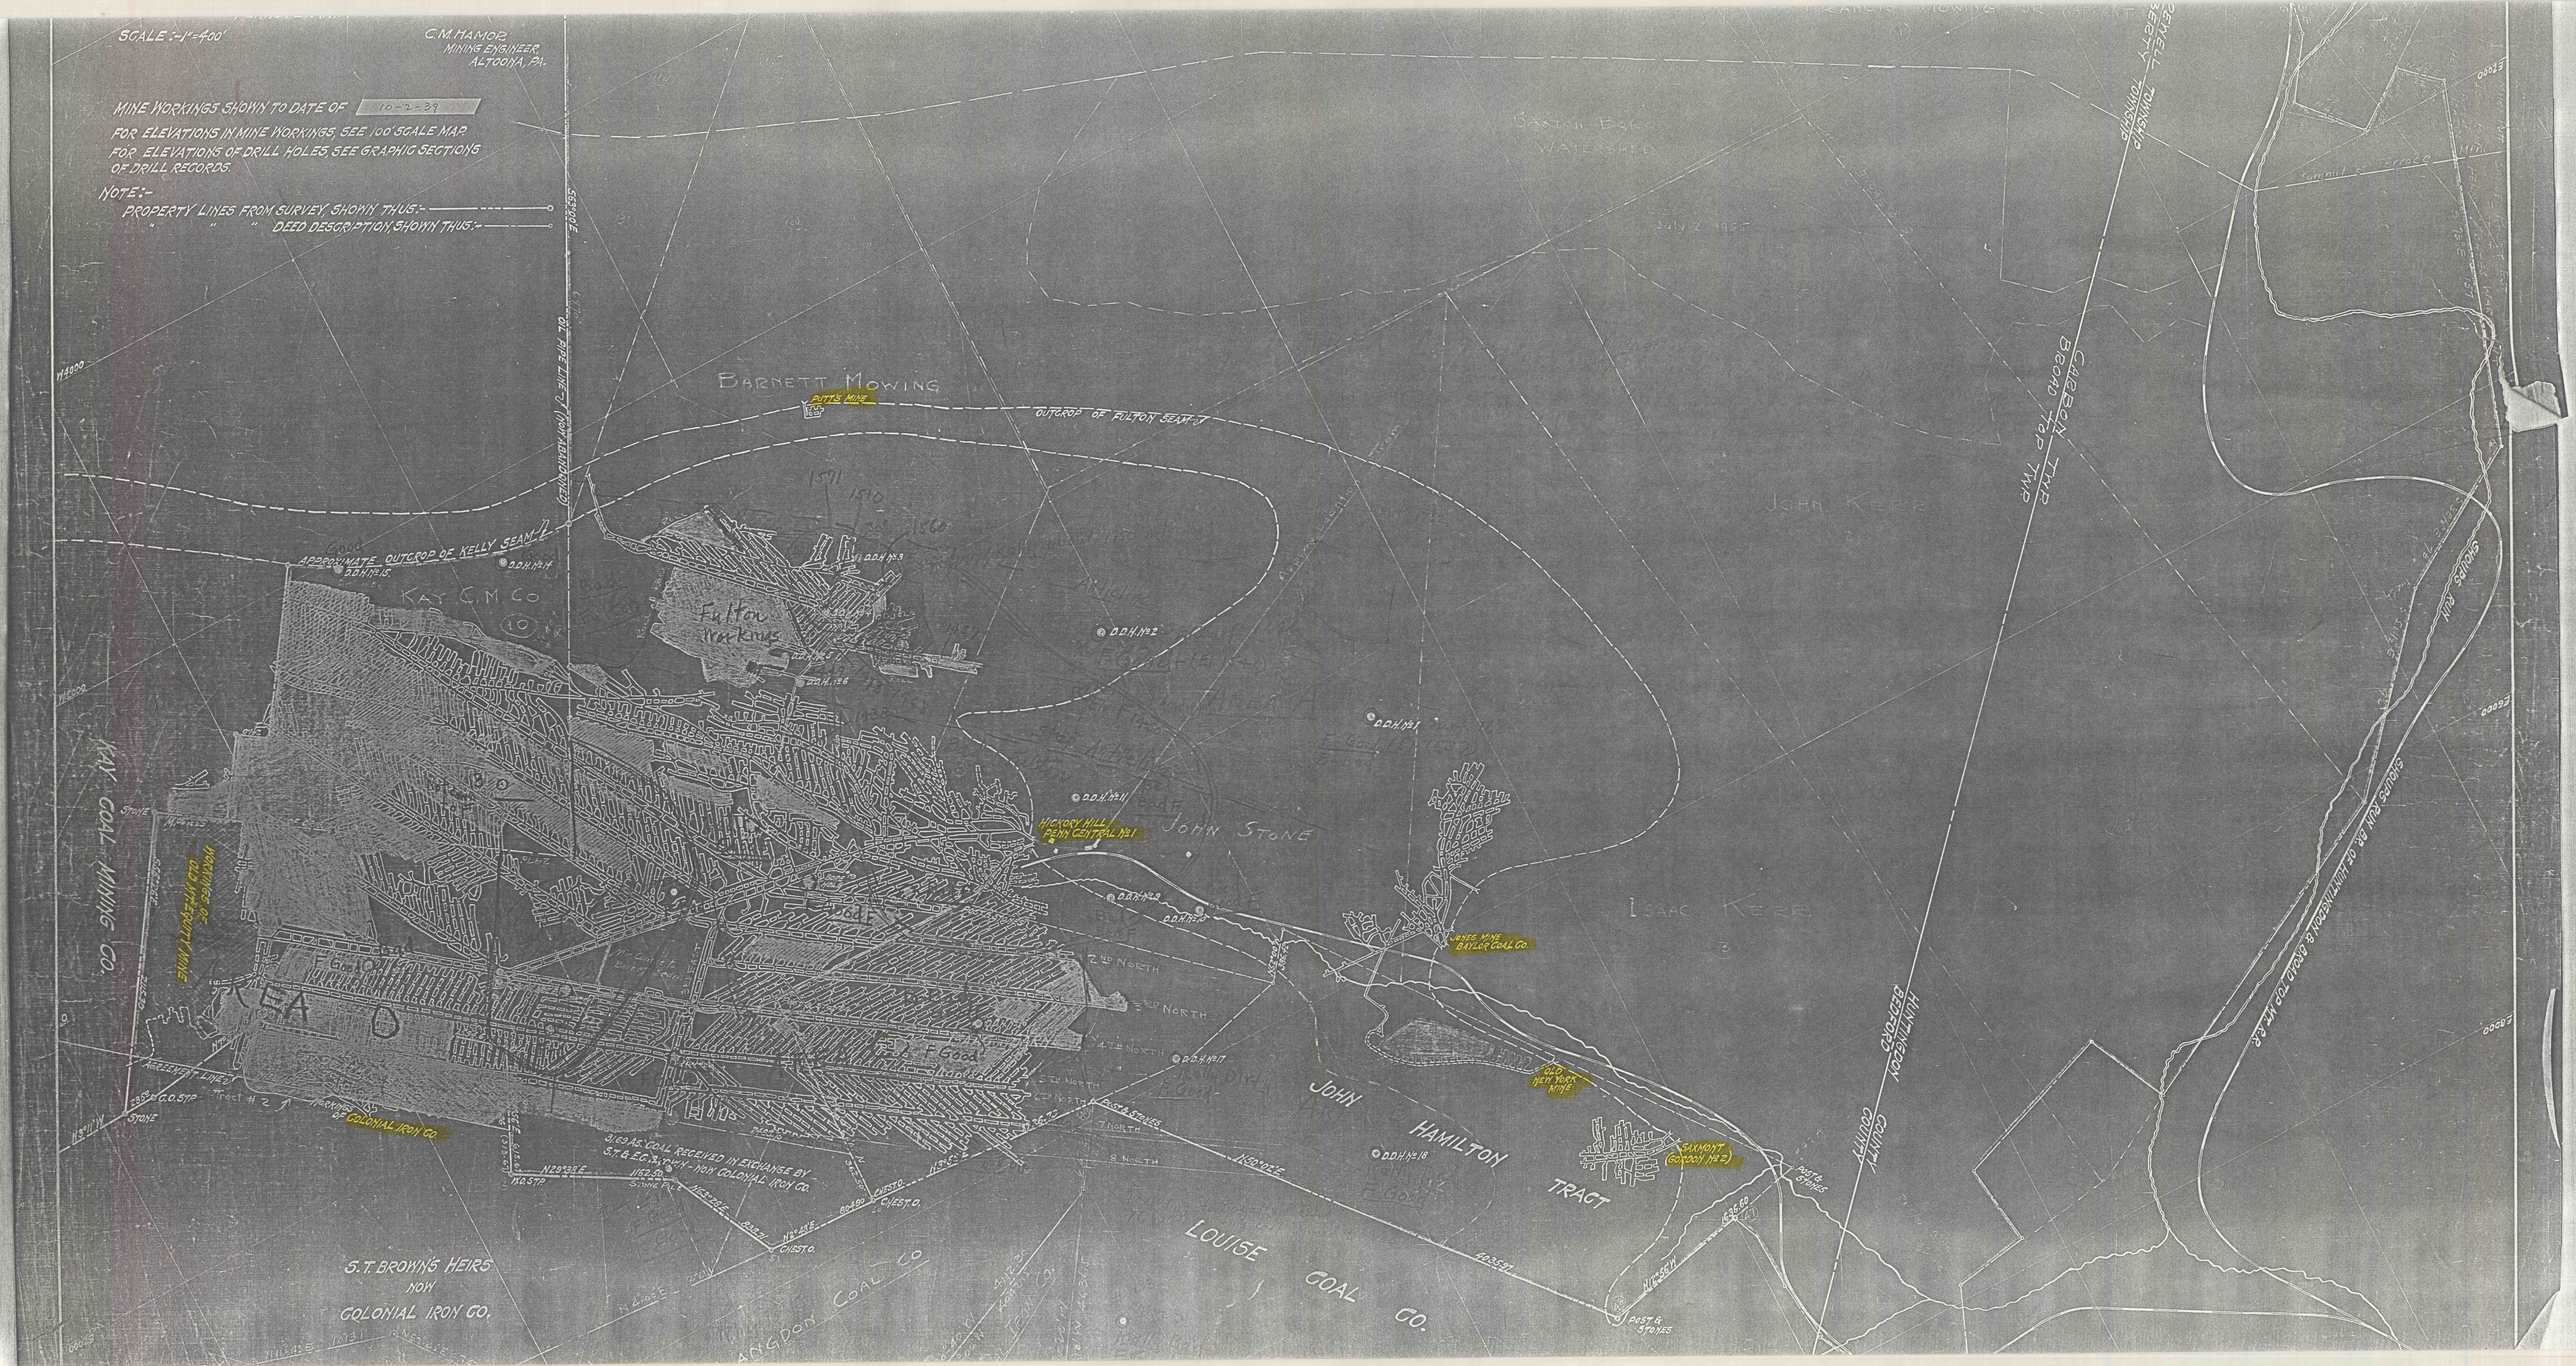
SCALE :- 1" = 400'
C.M. HAMOR
MINING ENGINEER,
ALTOONA, PA.
MINE WORKINGS SHOWN TO DATE OF 10-2-39
FOR ELEVATIONS IN MINE WORKINGS, SEE 100' SCALE MAP
FOR ELEVATIONS OF DRILL HOLES, SEE GRAPHIC SECTIONS
OF DRILL RECORDS.
NOTE:-
PROPERTY LINES FROM SURVEY, SHOWN THUS:-
" " " DEED DESCRIPTION, SHOWN THUS:-
BARNETT MOWING
PUTT'S MINE
OUTCROP OF FULTON SEAM
APPROXIMATE OUTCROP OF KELLY SEAM
D.D.H. No. 15
D.D.H. No. 14
D.D.H. No. 13
D.D.H. No. 12
D.D.H. No. 11
D.D.H. No. 9
D.D.H. No. 8
D.D.H. No. 7
D.D.H. No. 6
D.D.H. No. 17
D.D.H. No. 18
KAY C.M. CO
Fulton workings
F. Good
HICKORY MILL / PENN CENTRAL No. 1
JOHN STONE
ISAAC KERR
JOHN HAMILTON TRACT
OLD NEW YORK MINE
SUMMIT (COLONY No. 2)
GREES MINE BAYLER COAL CO.
KAY COAL MINING CO.
MOUNTAIN CO. COAL MINE
AREA D
Tract # 2
COLONIAL IRON CO.
169 AC. COAL RECEIVED IN EXCHANGE BY S.T. & E.C. BROWN - NOW COLONIAL IRON CO.
S.T. BROWN'S HEIRS
NOW
COLONIAL IRON CO.
LOUISE COAL CO.
ARGON COAL CO
CAMBRIA COUNTY
HUNTINGDON COUNTY
GALLITZIN TWP.
CADOGAN TWP
BROAD TOP TWP
CHILDS RUN
SHOUPS RUN
PENNSYLVANIA RAILROAD (MAIN TRACK)
POST & STONES
STONE
1571
1510
1500
1600
