


7-2W

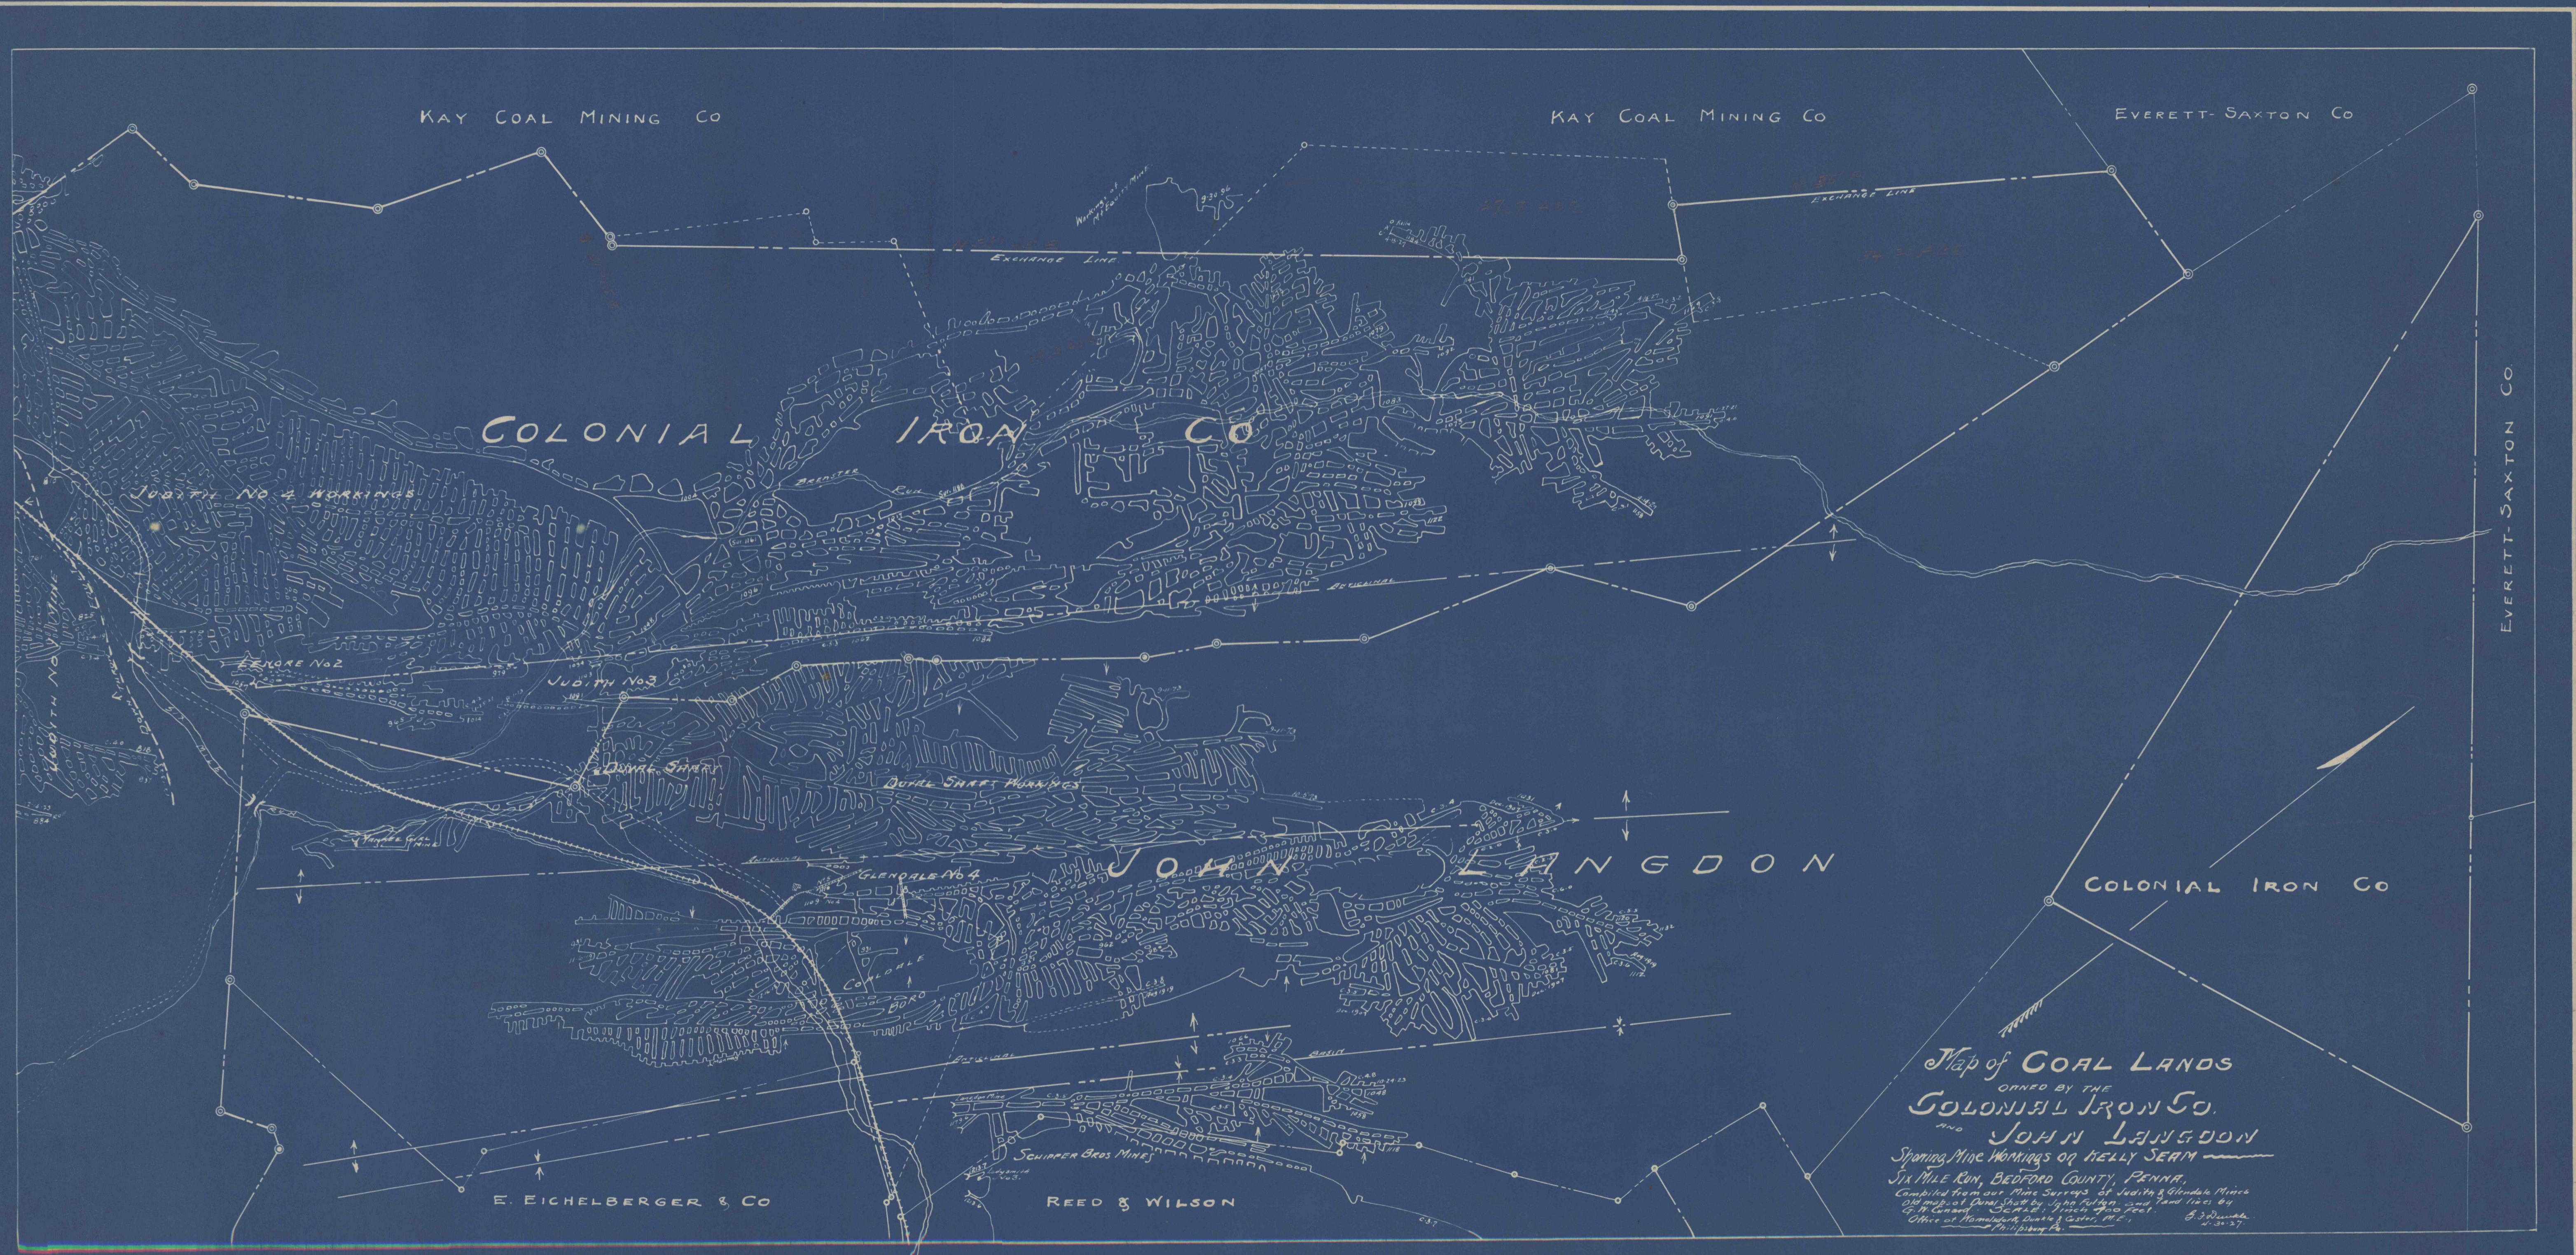

Map of COAL LANDS
 OWNED BY THE
COLONIAL IRON CO.
 AND
JOHN LANGDON
 Showing Mine Workings of BELLY SEAM
 SIX MILE RUN, BEDFORD COUNTY, PENNA.
 Compiled from our Mine Surveys of Judith & Glendale Mines

34A

MC-6