

WORKINGS IN BARNETT SEAM
OF
FOREMAN-WHITE COAL CO.
IN BROAD TOP TOWNSHIP, BEDFORD CO., PENNA.
SCALE 1"=100'

W.A. SILLIMAN
ENGINEER
ALTOONA, PA.

1946

NOW OPERATED
BY
SWEENEY COAL COMPANY

CK10-3




FOREMAN AND ZETH
FORMERLY EVERETT SARTON CO.

N.P. AND ANNA L. ZETH
FORMERLY G.P. FOREMAN

G. P. FOREMAN
FORMERLY THROPP-WOOD TRACT

N. P. AND ANNA L. ZETH
FORMERLY BUNNERS HILL COAL CO.

SIMONS & CO.

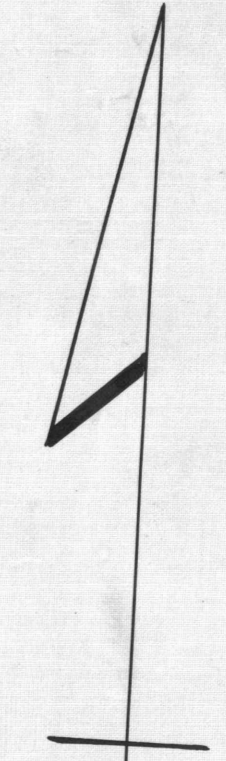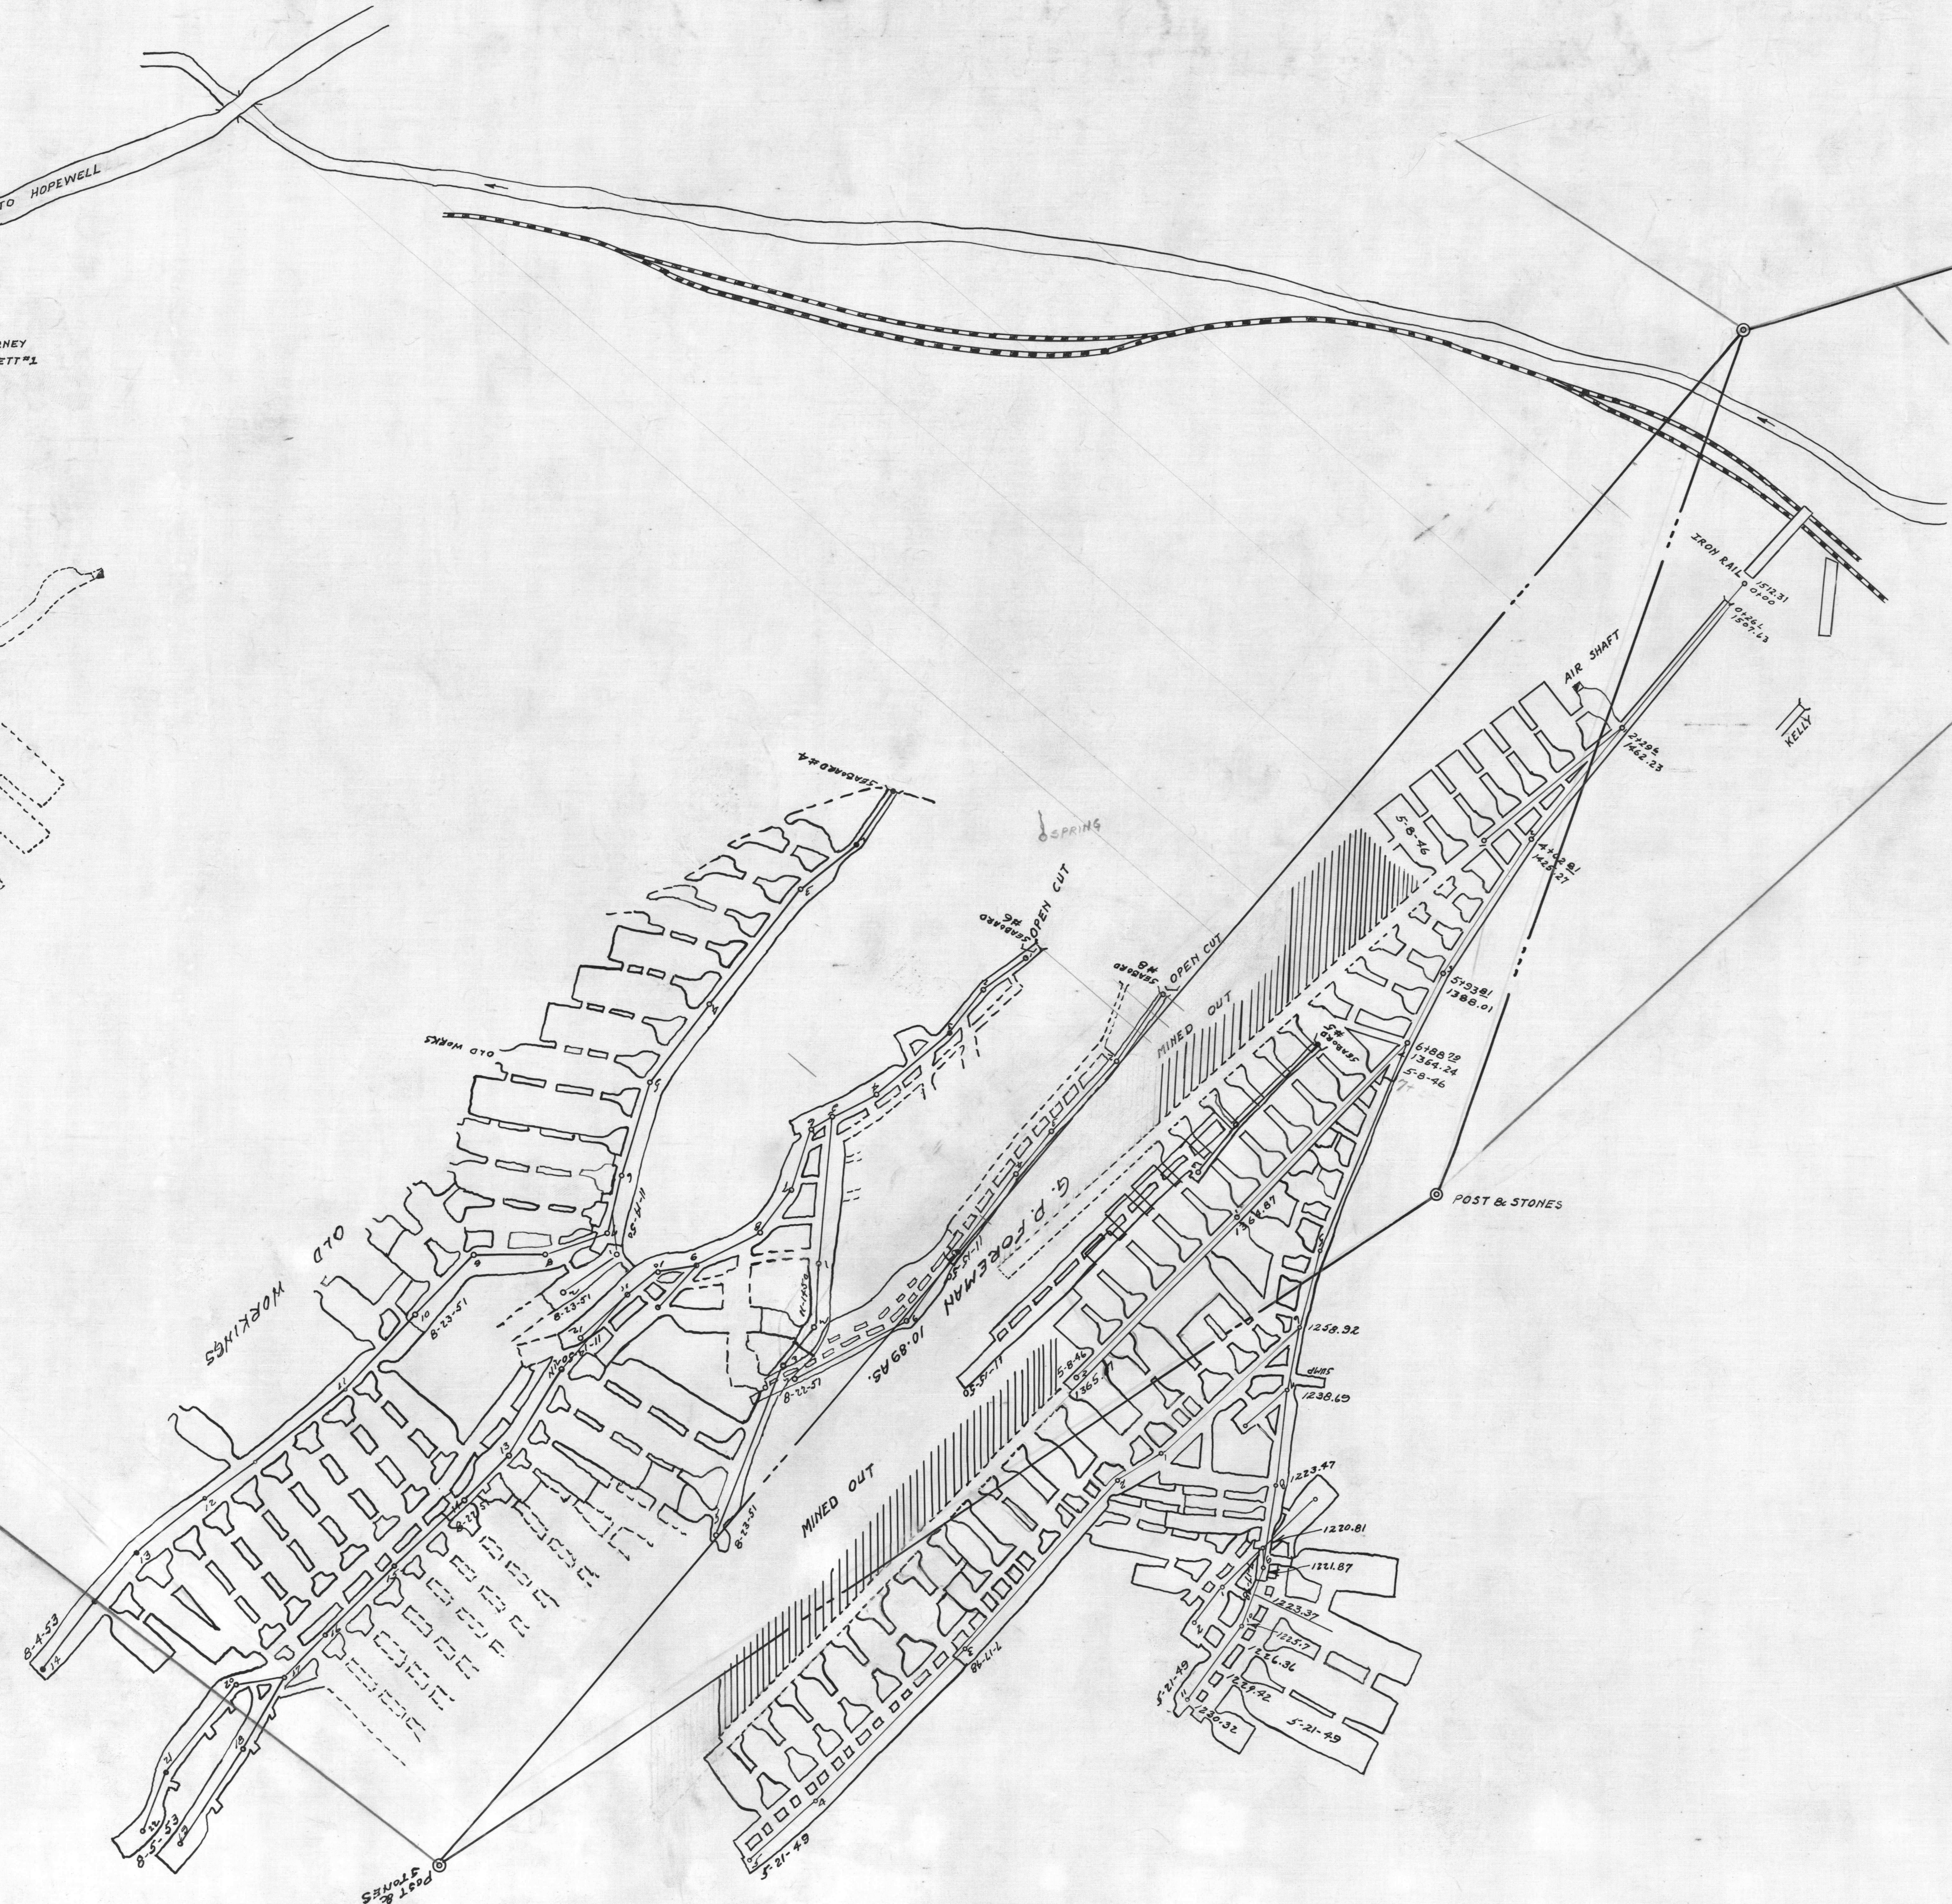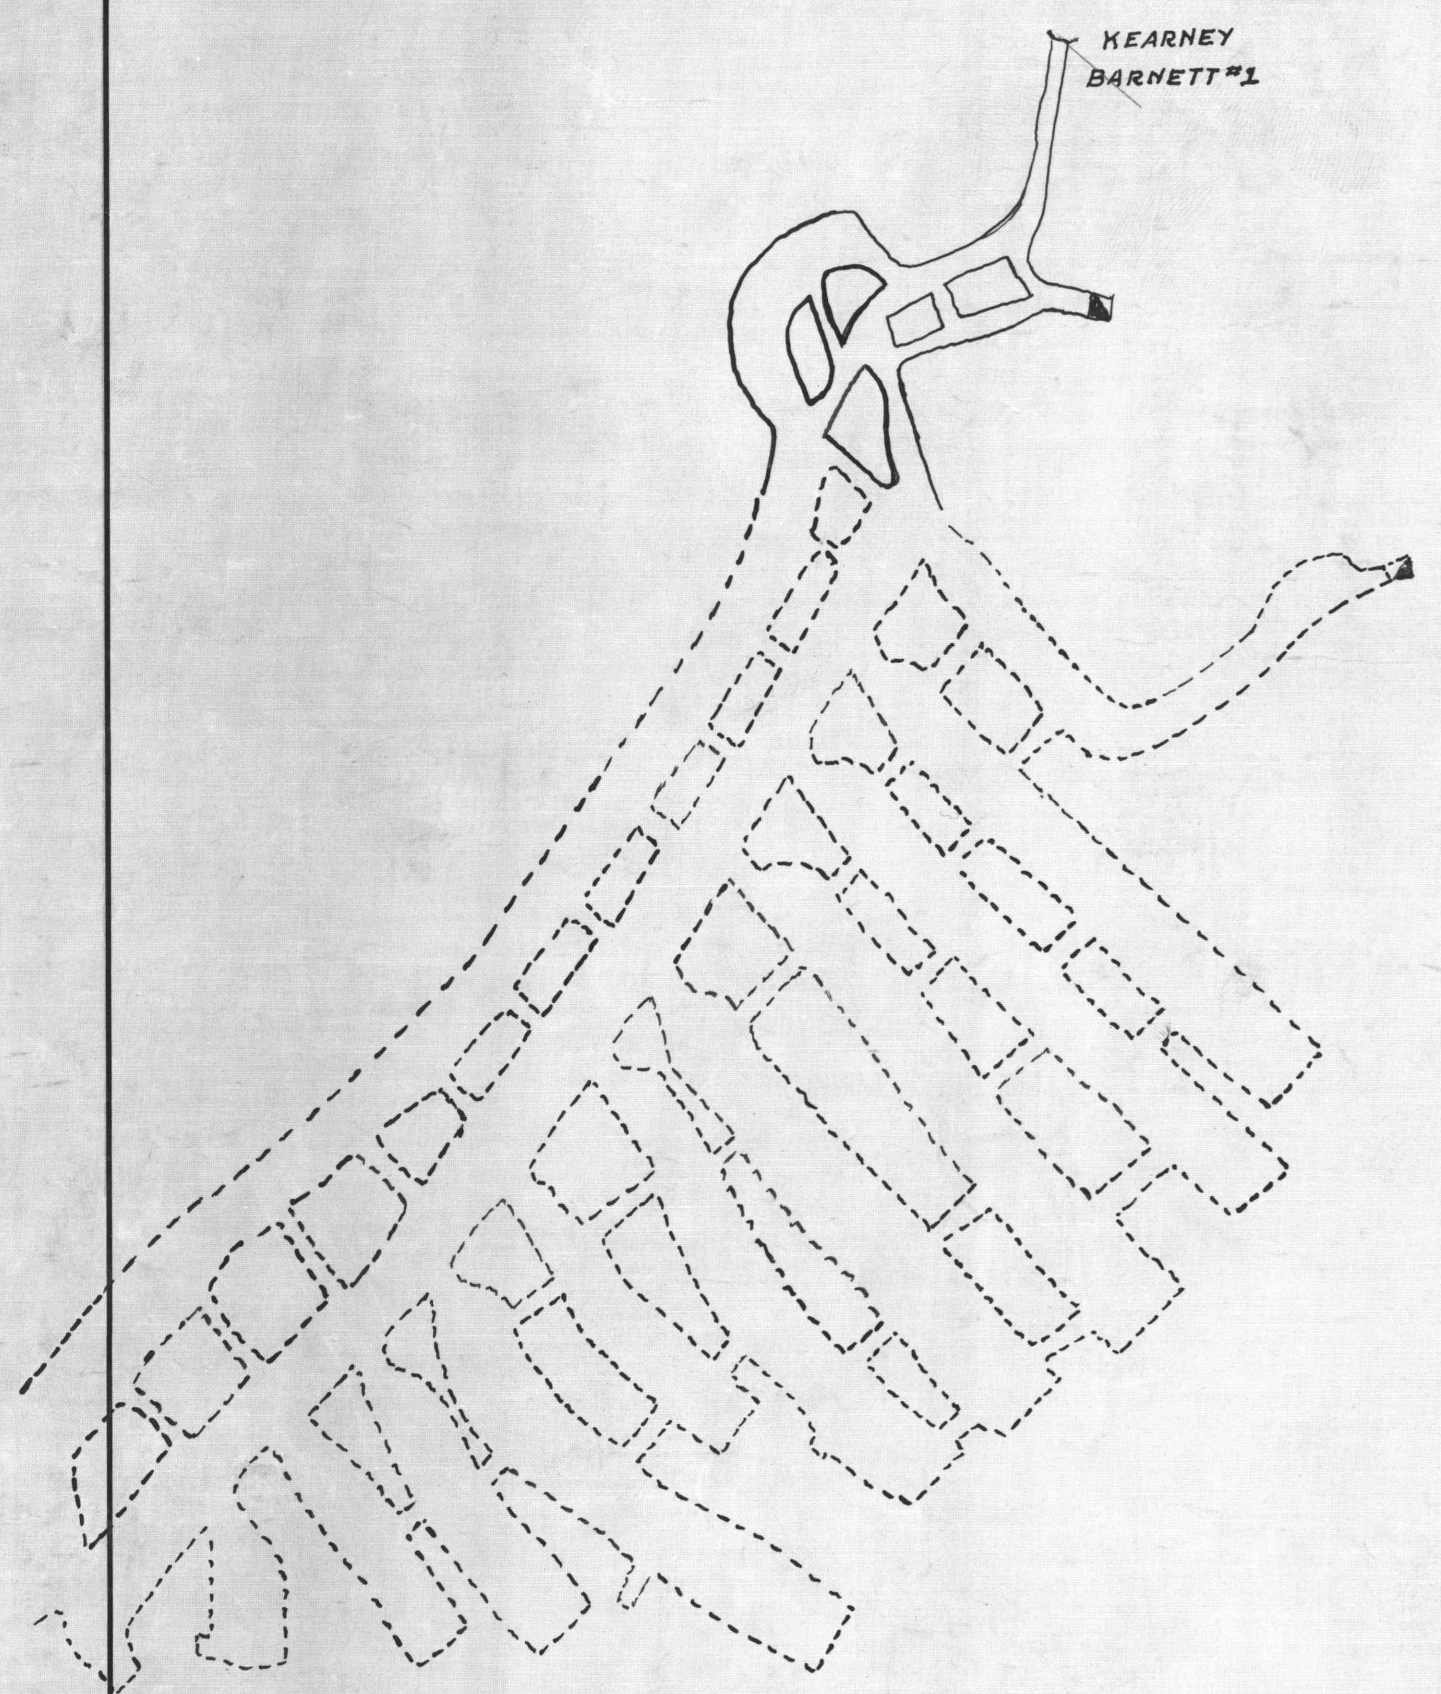

CK10-3

CK10-3