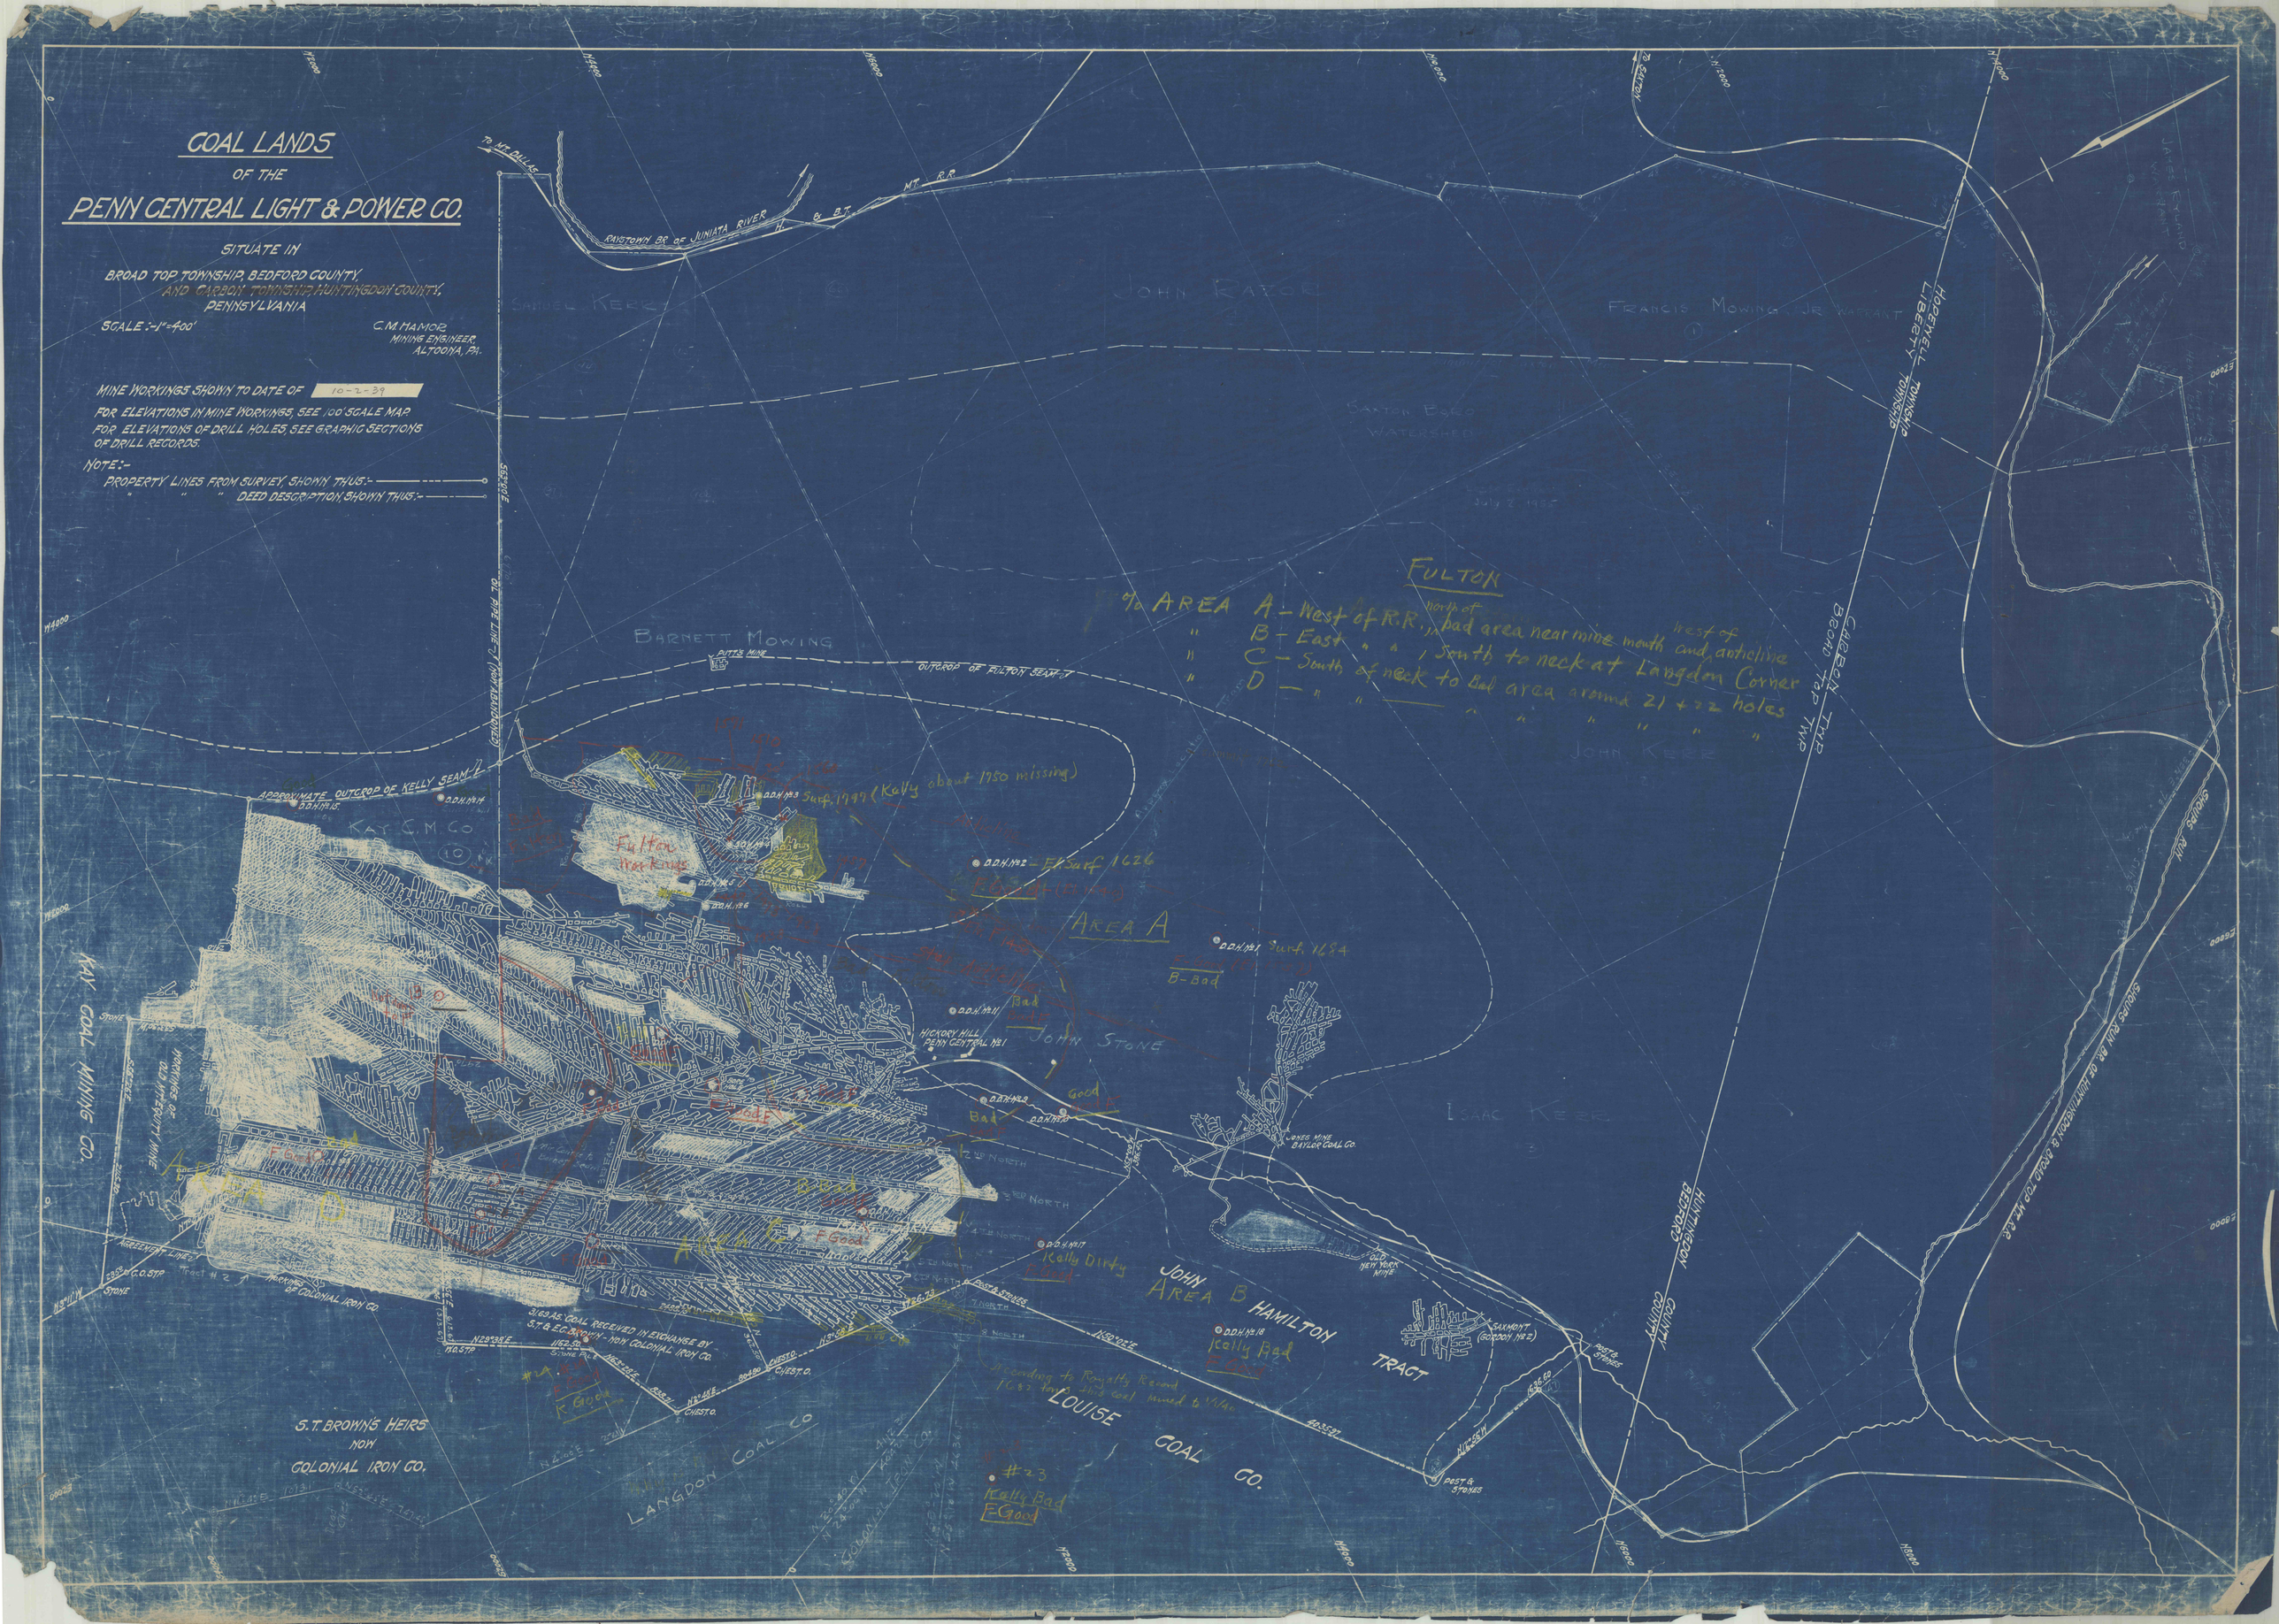
COAL LANDS
OF THE
PENN CENTRAL LIGHT & POWER CO.
SITUATE IN
BROAD TOP TOWNSHIP, BEDFORD COUNTY,
AND CARBON TOWNSHIP, HUNTINGDON COUNTY,
PENNSYLVANIA
SCALE :-1"=400'
C.M. HAMOR
MINING ENGINEER,
ALTOONA, PA.
MINE WORKINGS SHOWN TO DATE OF 10-2-39
FOR ELEVATIONS IN MINE WORKINGS, SEE 100' SCALE MAP.
FOR ELEVATIONS OF DRILL HOLES, SEE GRAPHIC SECTIONS OF DRILL RECORDS.
NOTE:-
PROPERTY LINES FROM SURVEY, SHOWN THUS:-
" " " DEED DESCRIPTION, SHOWN THUS:-
FULTON
% AREA A - West of R.R., north of bad area near mine mouth and west of anticline
" B - East " " , South to neck at Langdon Corner
" C - South of neck to Bad area around 21 + 22 holes
" D - " " " " " " "
TO MT. DALLAS
RAYSTOWN BR. OF JUNIATA RIVER
H. & B.T. MT. R.R.
JOHN RAZOR
FRANCIS MOWING JR. WARRANT
SAXTON BORO WATERSHED
HOPEWELL TOWNSHIP
LIBERTY TOWNSHIP
CARBON TWP
BROAD TOP TWP
BARNETT MOWING
PITT'S MINE
OUTCROP OF FULTON SEAM
APPROXIMATE OUTCROP OF KELLY SEAM
KAY C.M. CO
Surf. 1797 (Kelly about 1750 missing)
Fulton Workings
AREA A
Surf. 1684
B-Bad
JOHN STONE
HICKORY HILL
PENN CENTRAL No 1
JONES MINE
BAYLOR COAL CO.
ISAAC KERR
KAY COAL MINING CO.
WORKINGS OF OLD MT. EQUITY MINE
AGREEMENT LINE
WORKINGS OF COLONIAL IRON CO.
3,163 AS. COAL RECEIVED IN EXCHANGE BY S.T. & E.C. BROWN - NOW COLONIAL IRON CO.
JOHN HAMILTON TRACT
AREA B
Kelly Dirty
Kelly Bad
OLD NEW YORK MINE
SAXMONT (GORDON No 2)
LOUISE COAL CO.
S.T. BROWN'S HEIRS
NOW
COLONIAL IRON CO.
LANGDON COAL CO
#23
Kelly Bad
F-Good
HUNTINGDON COUNTY
BEDFORD COUNTY
SHOUPS RUN
SHOUPS RUN BR. OF HUNTINGDON & BROAD TOP MT. R.R.