


↑ 1B  
↓ 1C

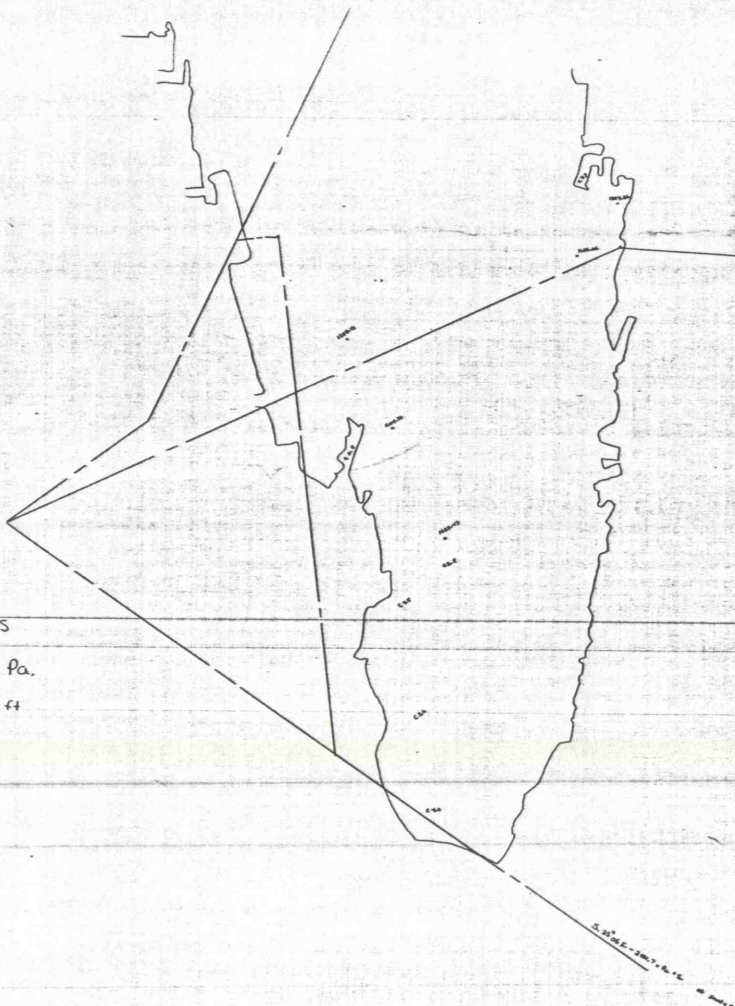

MAP OF

KEARNEY MINES

operated by  
Joseph Thropp  
Bedford County, Pa.

Scale 1 inch = 100 ft

1905

*Kearney Mines 1915  
owned by Joseph Thropp  
& Associates*

