


↑ 1B  
↓ 1C

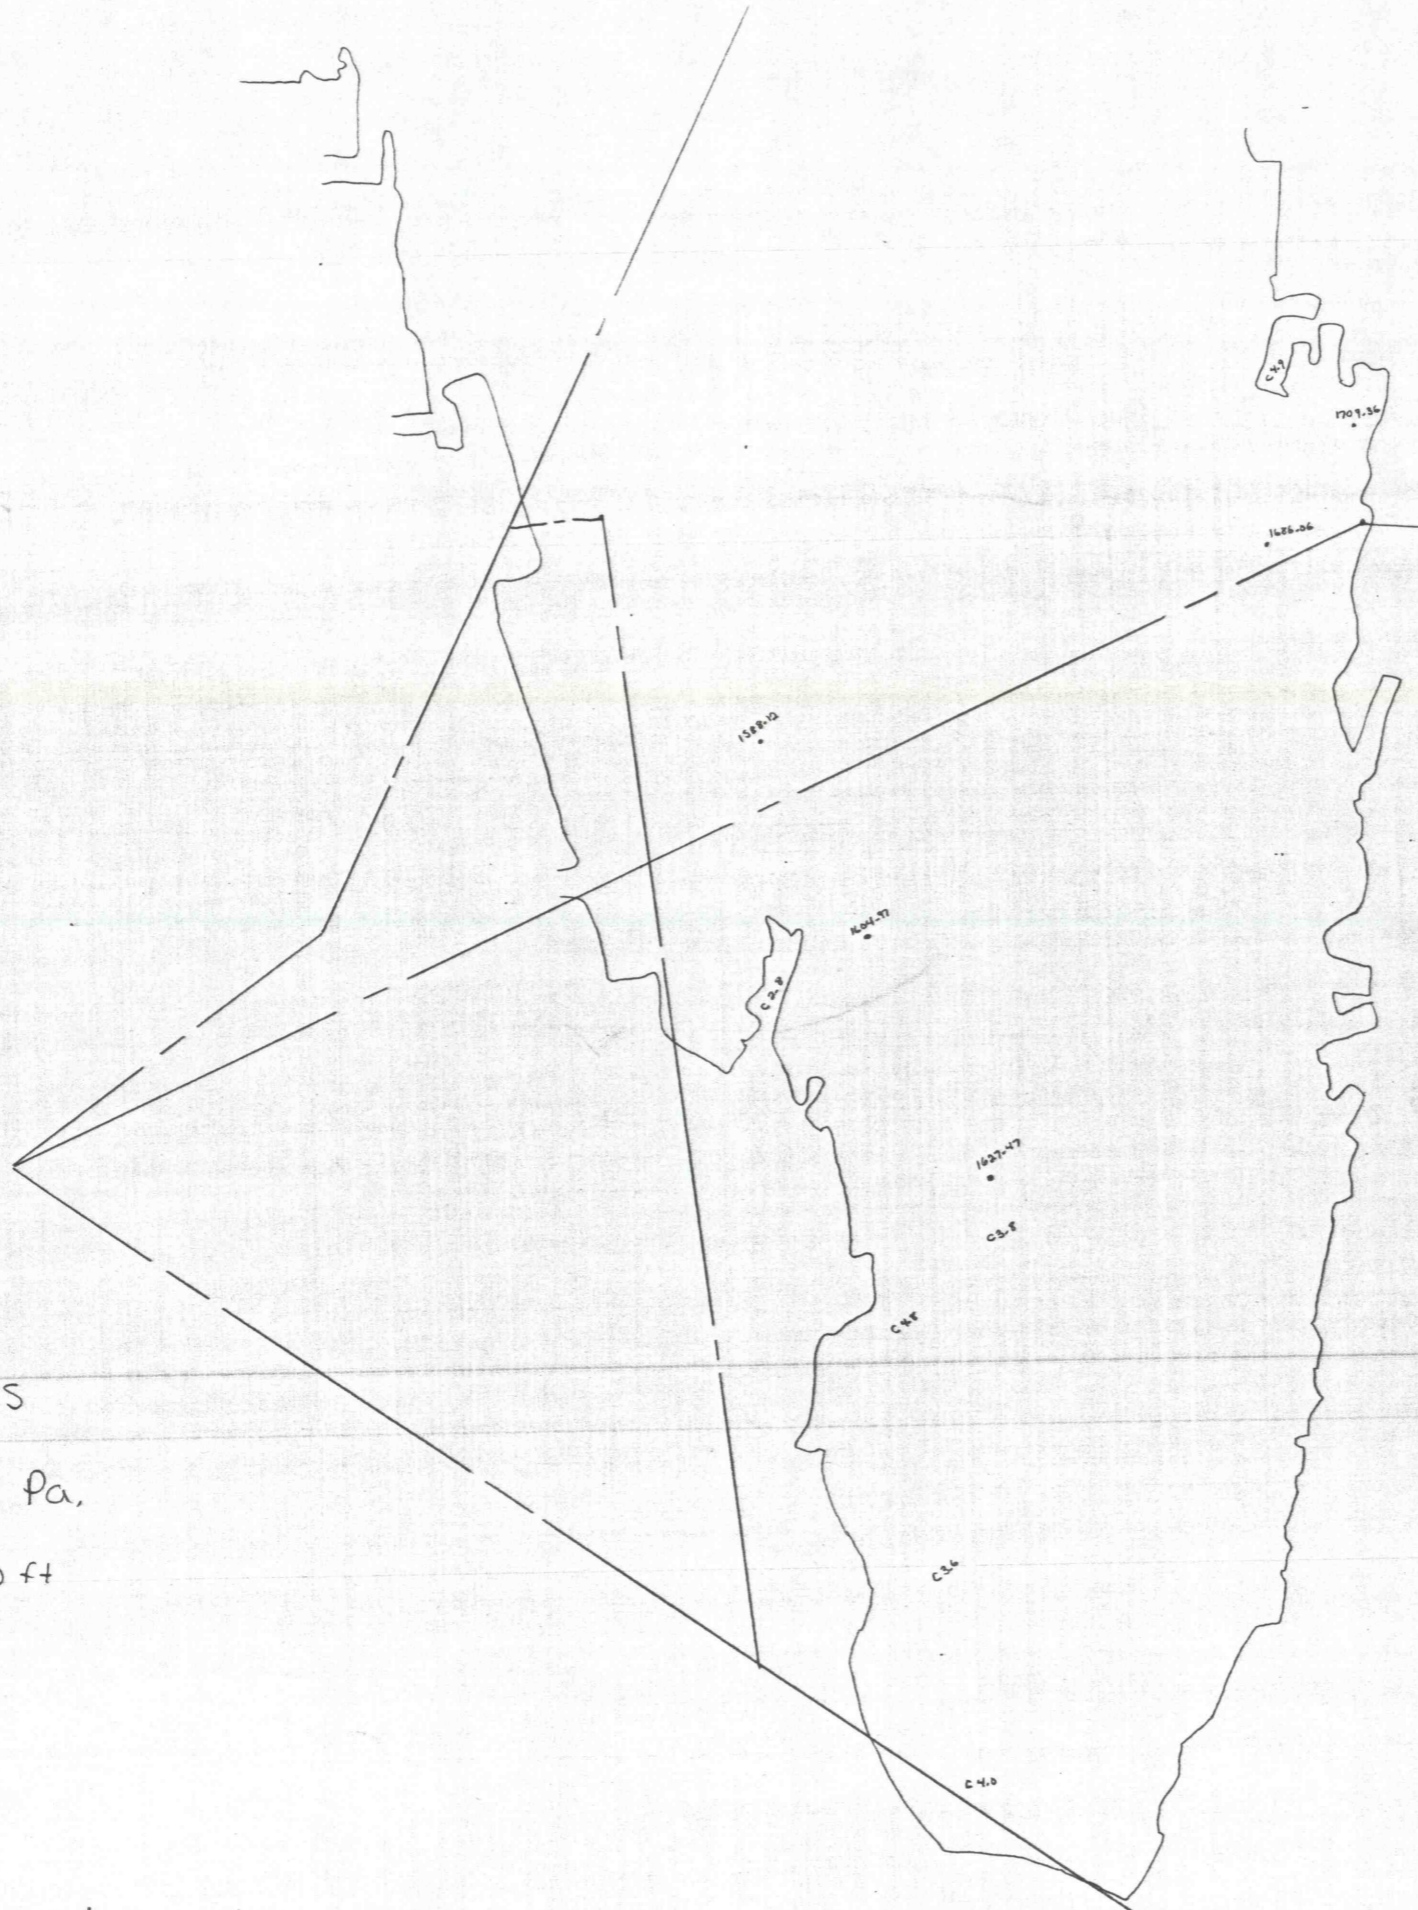

MAP OF  
KEARNEY MINES  
operated By  
Joseph Thropp  
Bedford County, Pa.  
Scale 1 inch = 100 ft  
1905

S. 25° 05' E. - 2 1/2 mi. 7 = Pa. + S.  
at study run

Kearney Mines 1905  
operated by Joseph Thropp  
Bedford County, Pa.