

SCALE 100 FT to 1 Inch

SIX MILE Run, Pa.


From The MAP

of

The Conard Shaft

workings

Bacon Mine
Barnett
March 1931

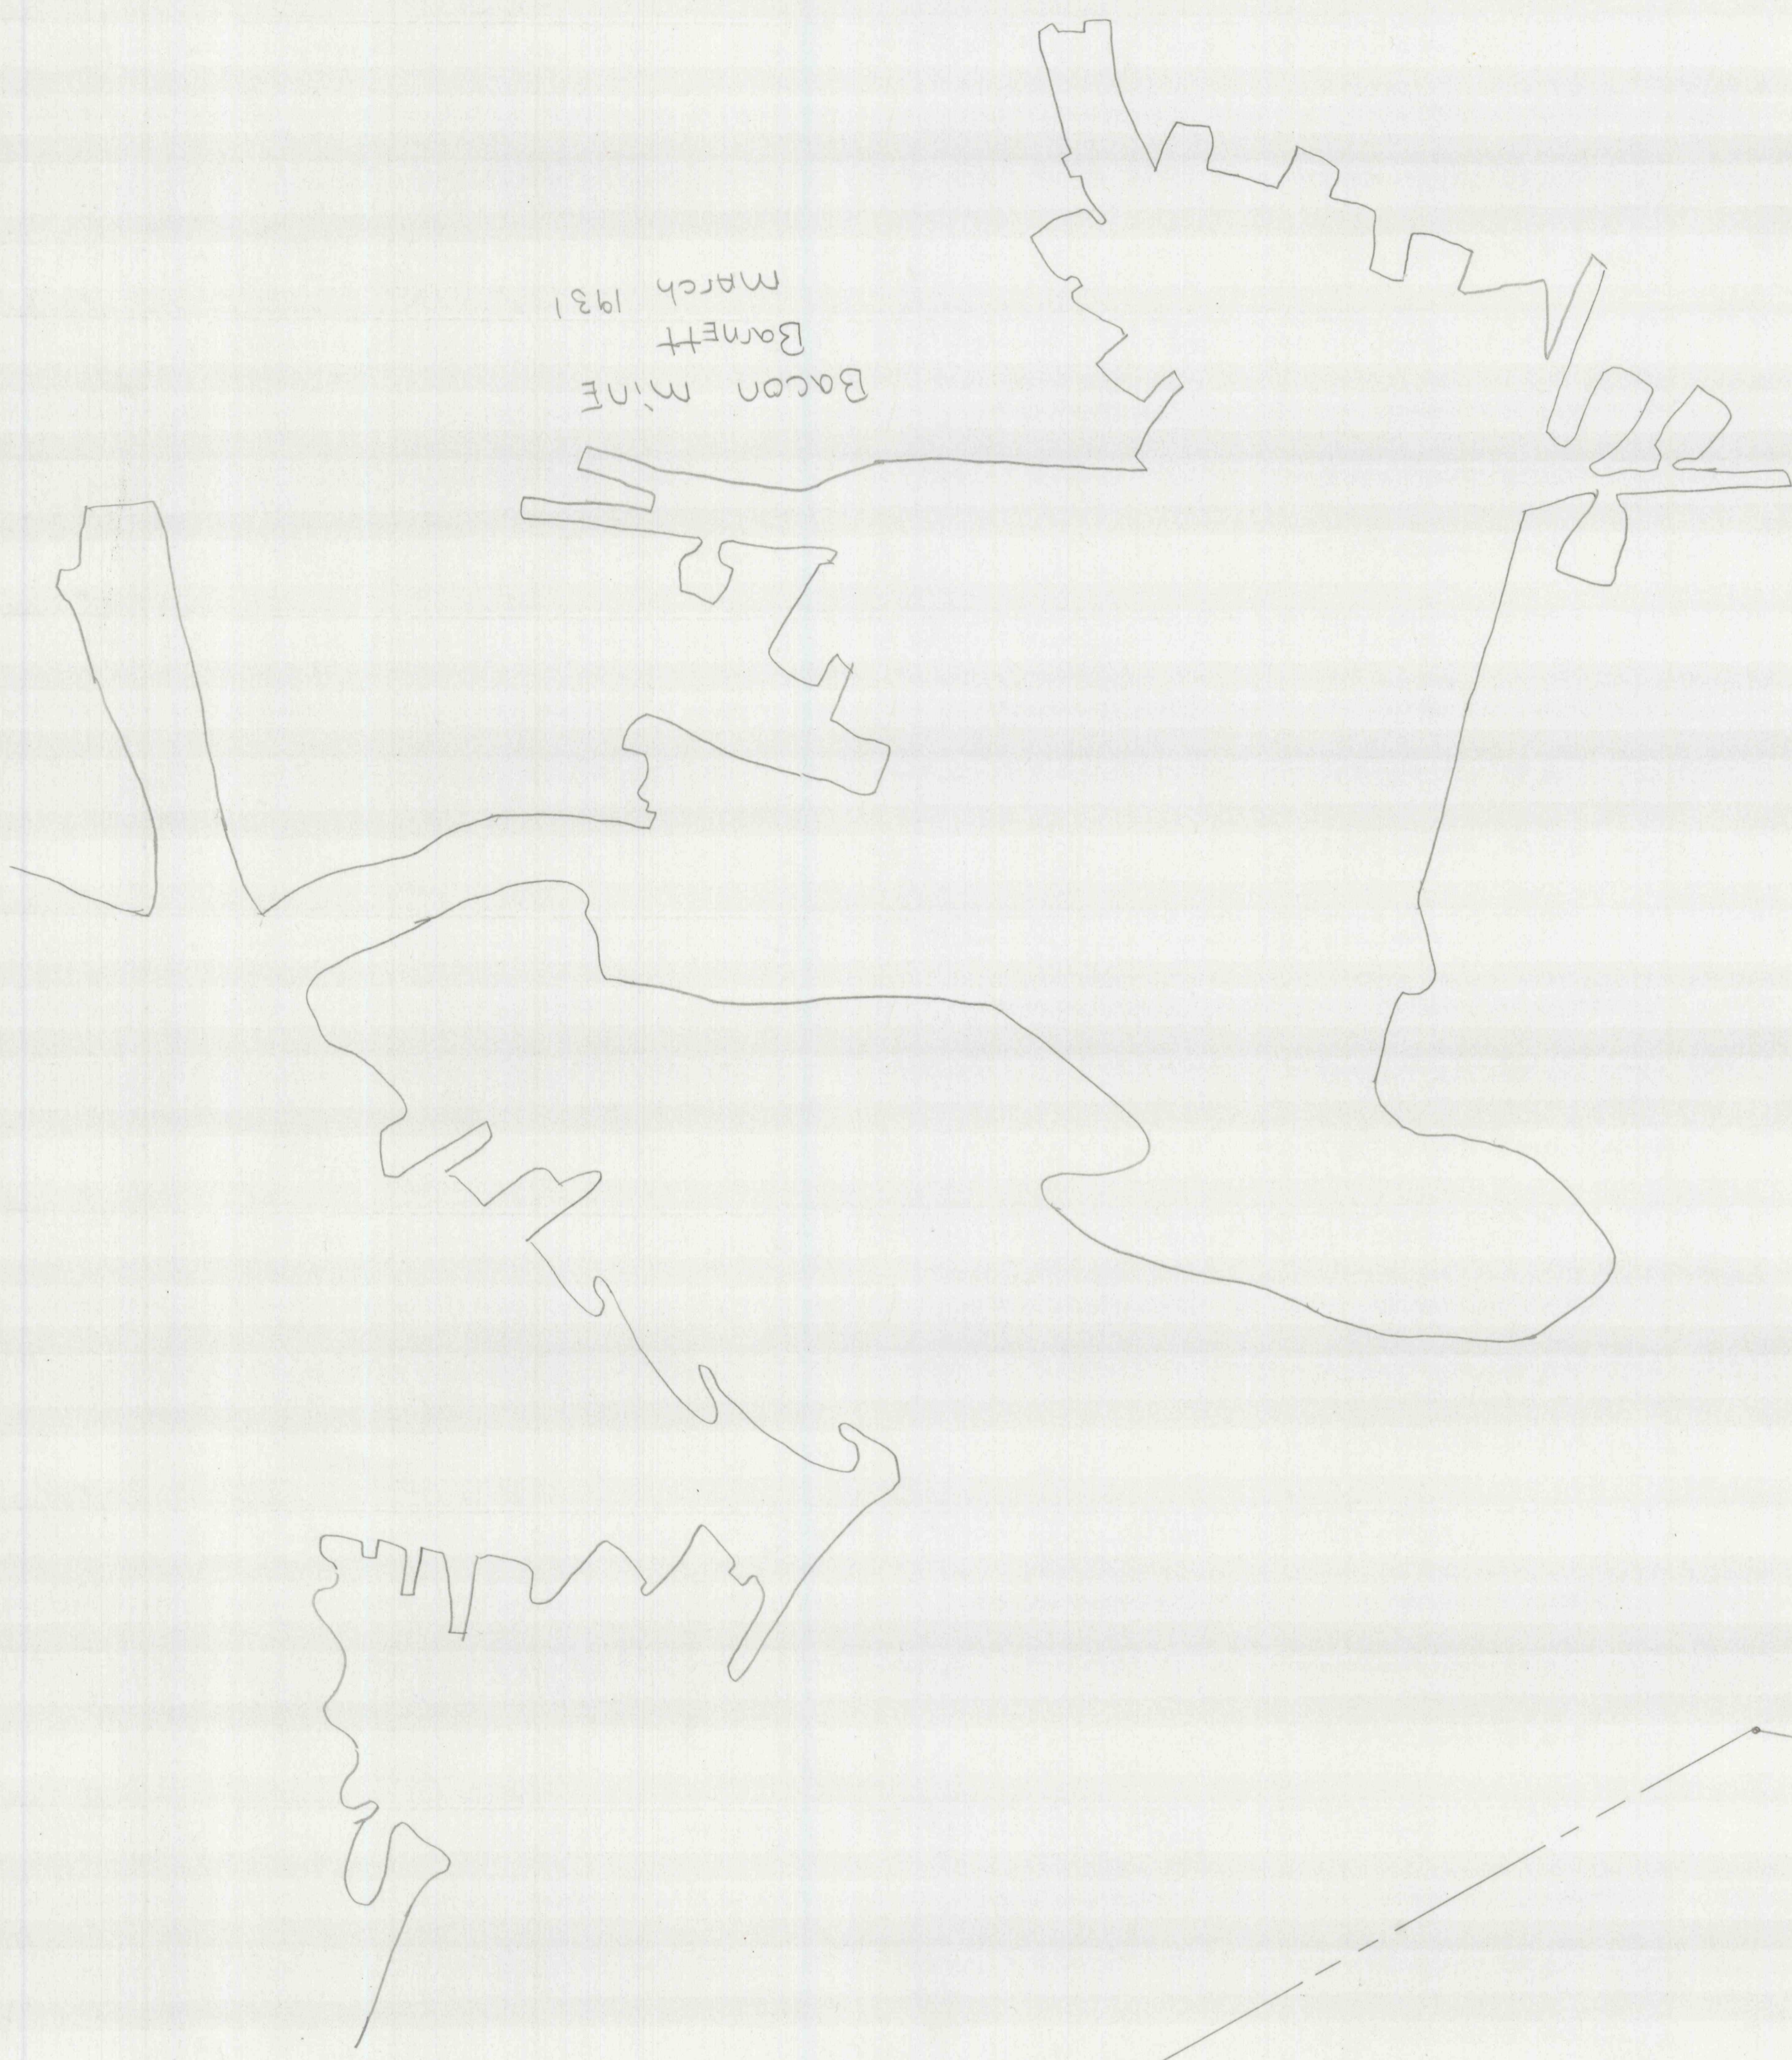

workings
of
Bacon Mine
Barnett Seam
From The

