
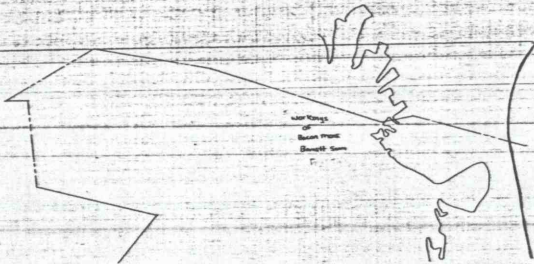


Scale 100 ft to 1 inch

Six mile Run, Pa.
Plan to map
of
the Conrad shaft
workings

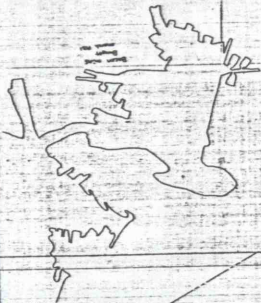

Workings
of
Bennett
Bennett Sum