

Scale 100 Ft to 1 Inch


SIX MILE RUN, Pa.

From The MAP

of

THE Conard Shaft
workings

Bacon mine
Barnett seam
March 1851

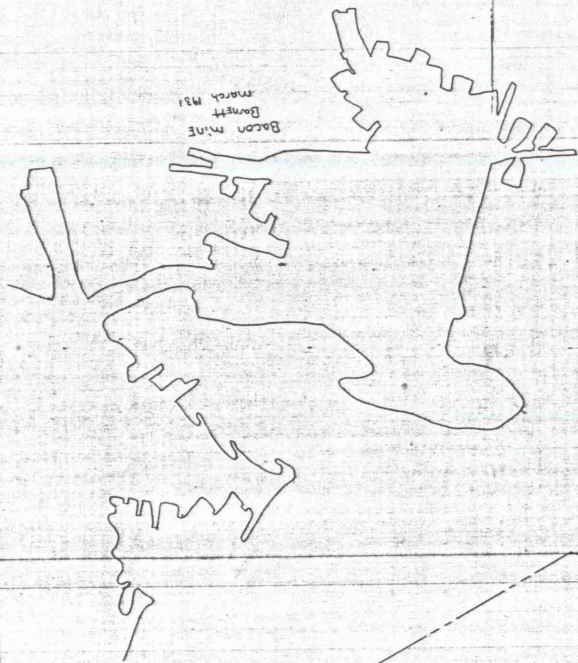

workings
of
Bacon mine
Barnett seam

