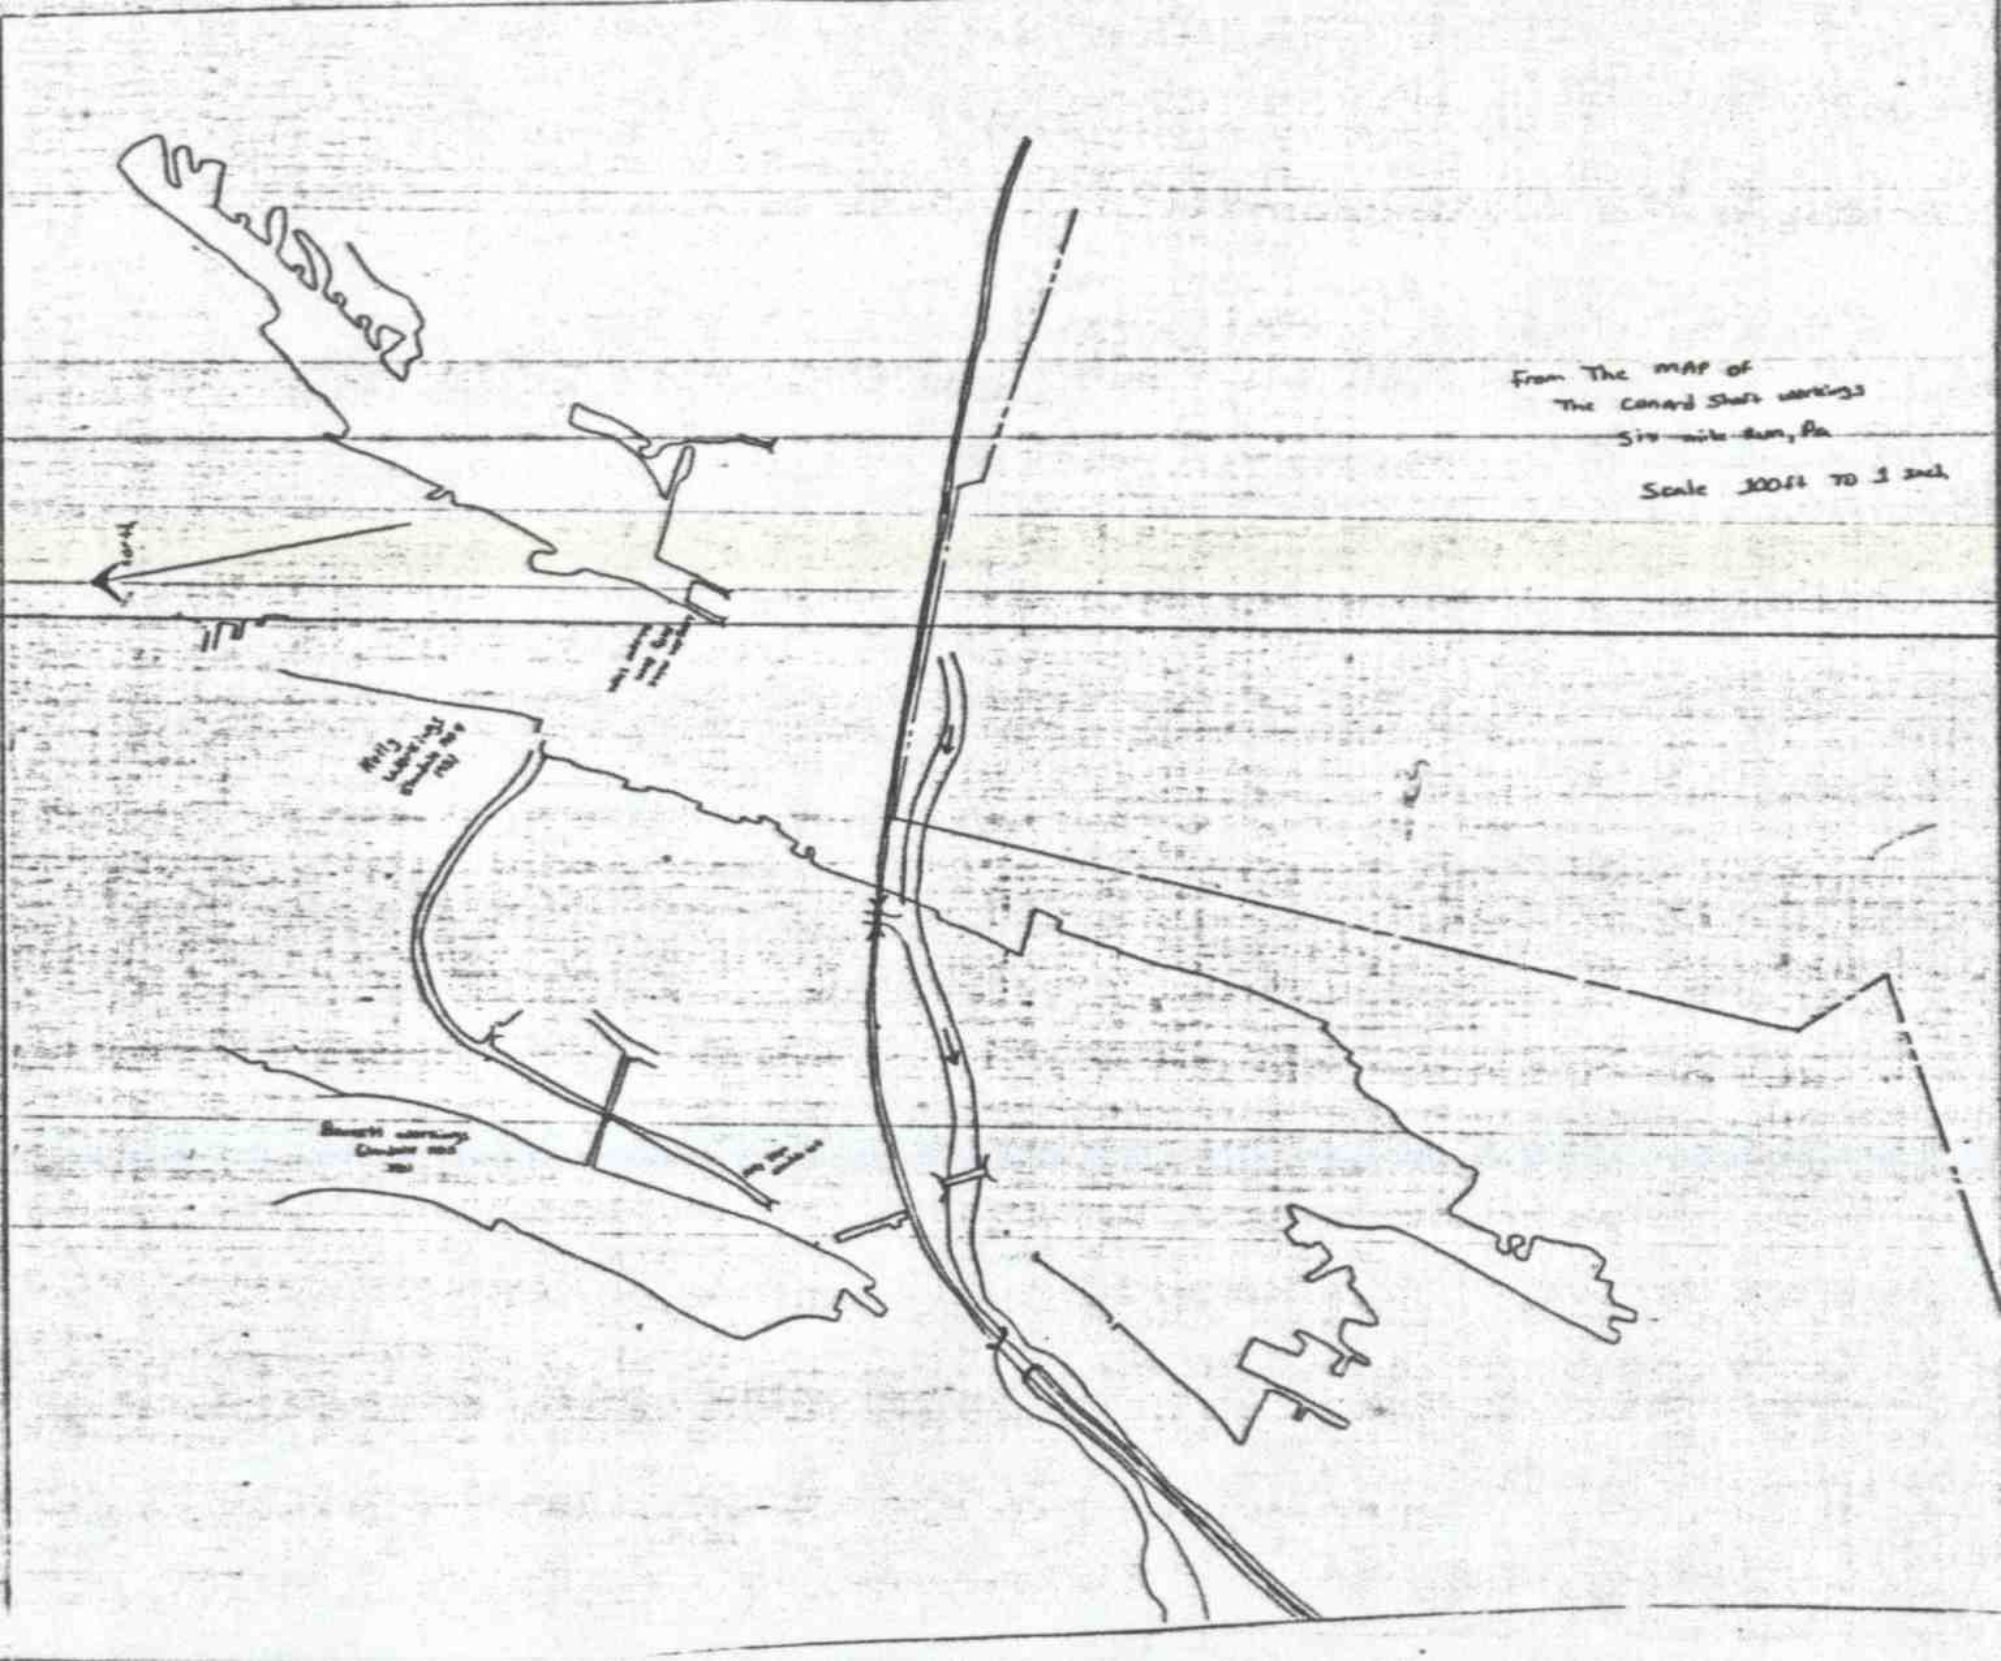
From The MAP of
The Conard Shaft workings
Six mile Run, Pa
Scale 100ft to 1 inch