


JOSEPH E. THROPP
NOW
WEBB & PILLING

Face of Gordon
Mine workings
according to old
map 7-11-21

HUNTINGDON
BEDFORD

COUNTY LINE


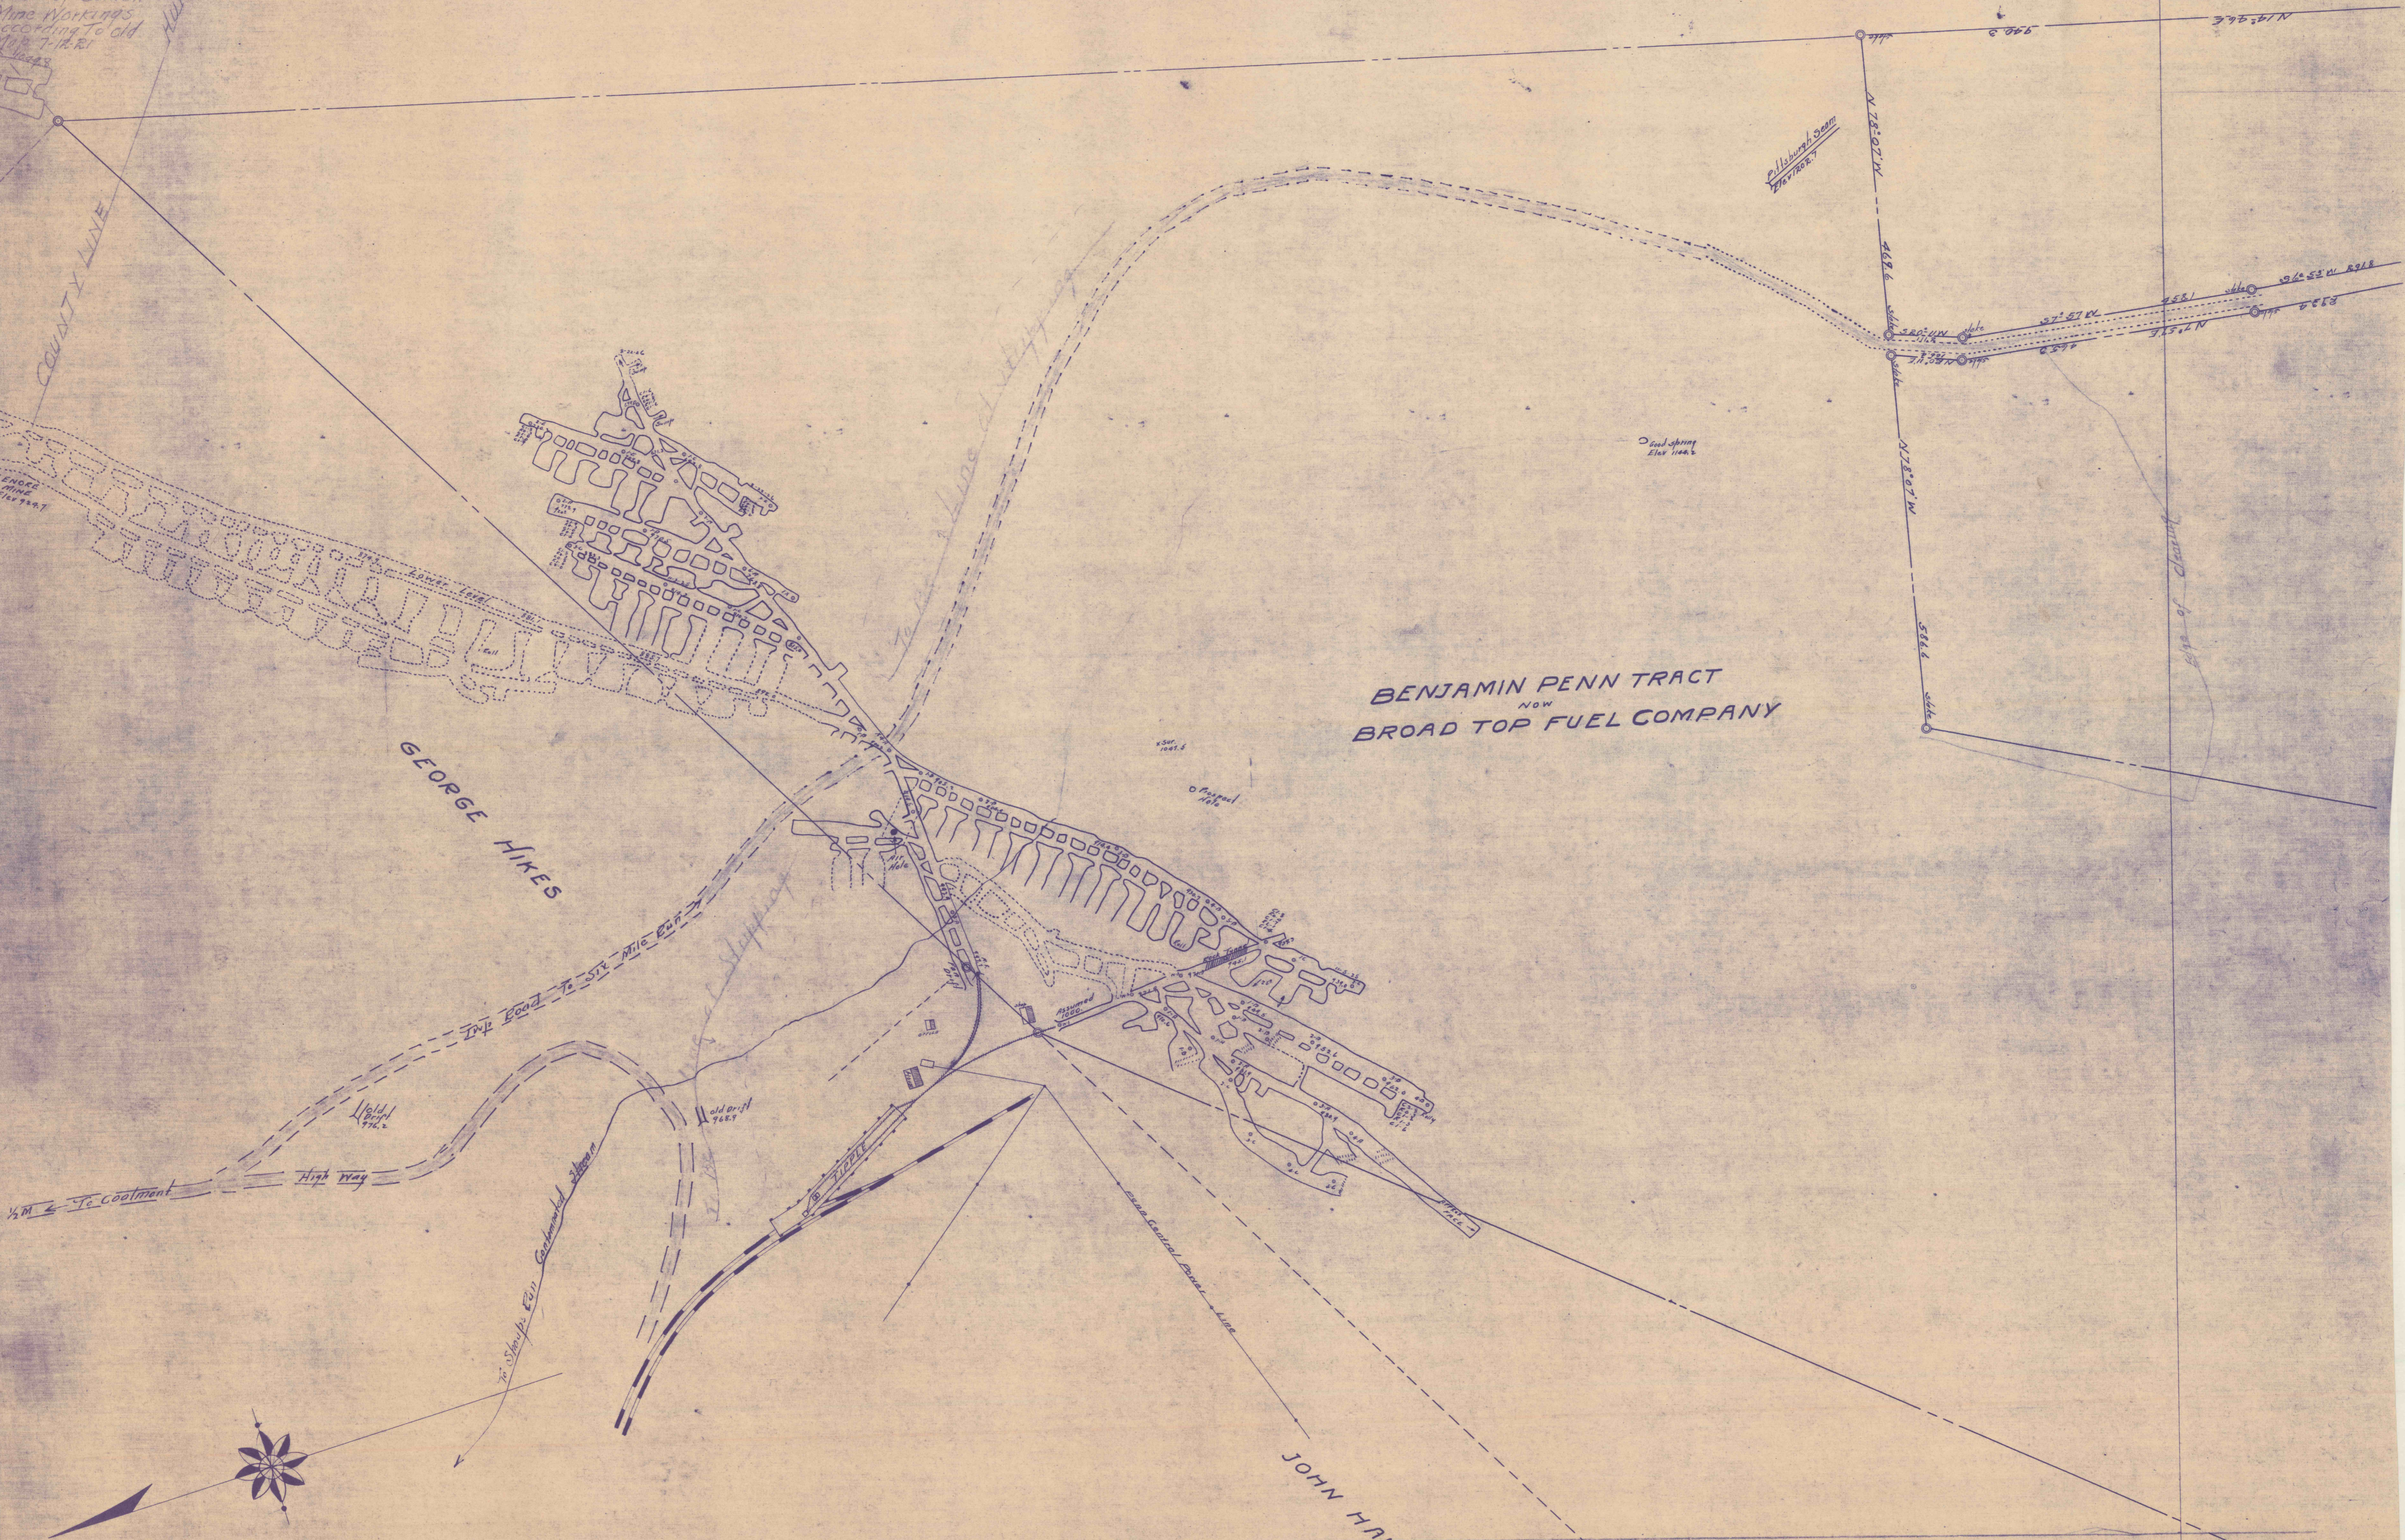

BENJAMIN PENN TRACT
NOW
BROAD TOP FUEL COMPANY

GEORGE HIXES

JOHN HAMILTON

MAP OF LOUISE-MINES

OPERATED BY
BROAD TOP FUEL COMPANY
situated in
Broad Top Twp. Bedford Co. Penna.

Scale - 1" = 100'

Guy C. Askey M.E.
Bedford Pa.

A
12, 13