

JOSEPH E. THROPP
NOW
WEBB & PILLING

Face of Gordon
Mine workings
According to old
Map 7-12-E

COUNTY LINE


HUNTINGDON
BEDFORD

Collinsburg seam
1717-1806-7

BENJAMIN PENN TRACT
NOW
BROAD TOP FUEL COMPANY

GEORGE HIKES

JOHN HAMILTON

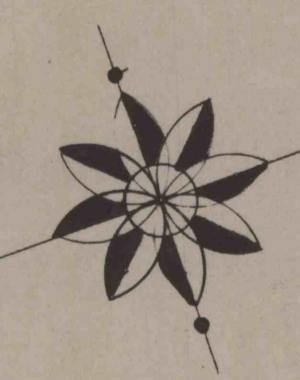

MAP OF LOUISE-MINES

OPERATED BY
BROADTOP FUEL COMPANY
situated in
Broad Top Twp. Bedford Co. Penna.

Scale - 1" = 100'

Guy C. Askey M.E.
Bedford Pa.