

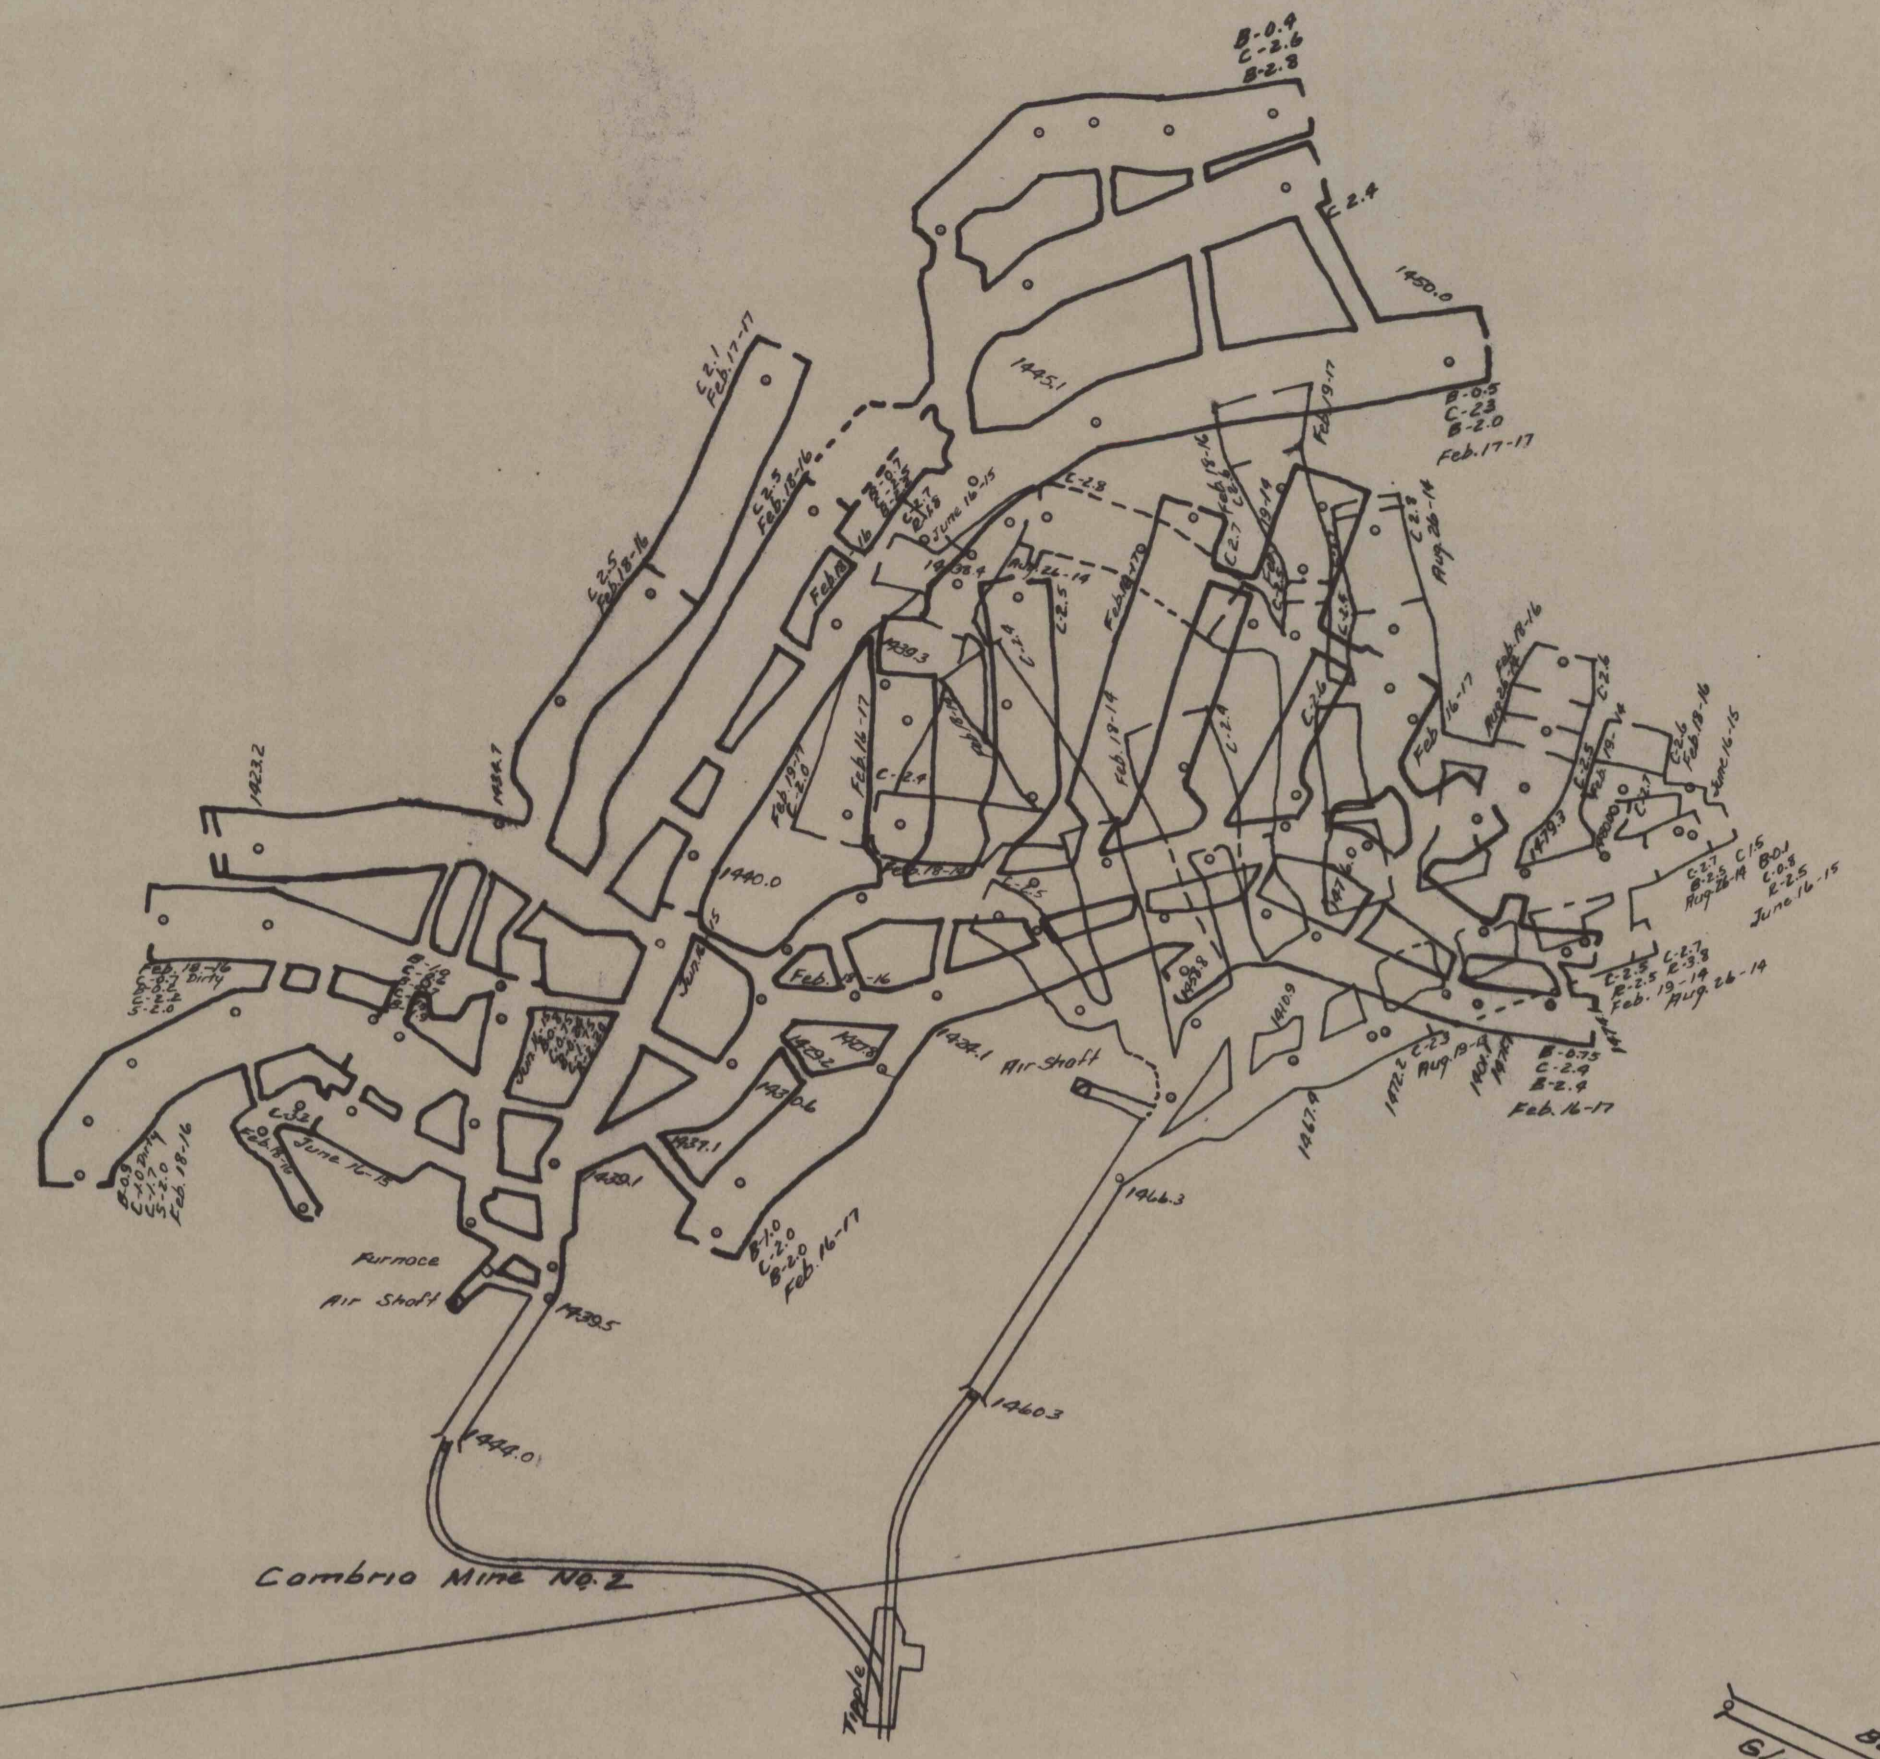


Combia Iron Co.

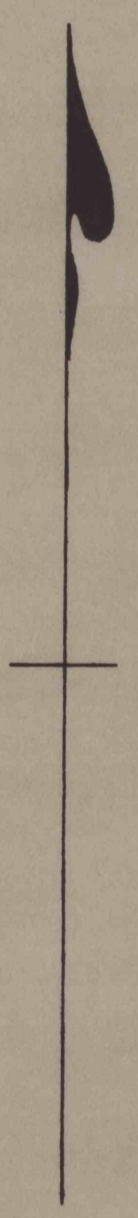

Combia Mine No. 2

Combia Mine No. 1
in twin to the Barnett Seam

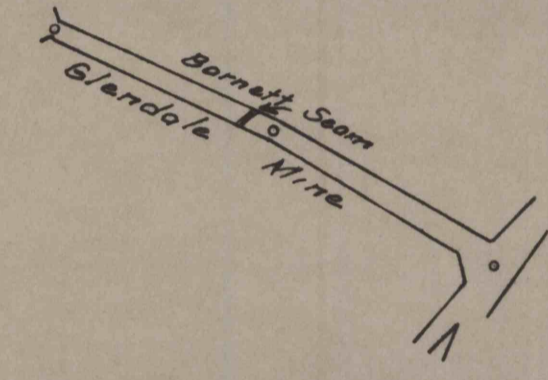

Chavington Mine No. 3
Barnett Seam

