

William W. Reed
Spear Tract

Detweiler

John Langdon Estate



William W. Reed
Hamilton Tract

To Be worked
From Dec. 1958 To July 1963

Worked
To May 1958

Wilday Grace Heirs

Approx. outcrop of Kelly seam

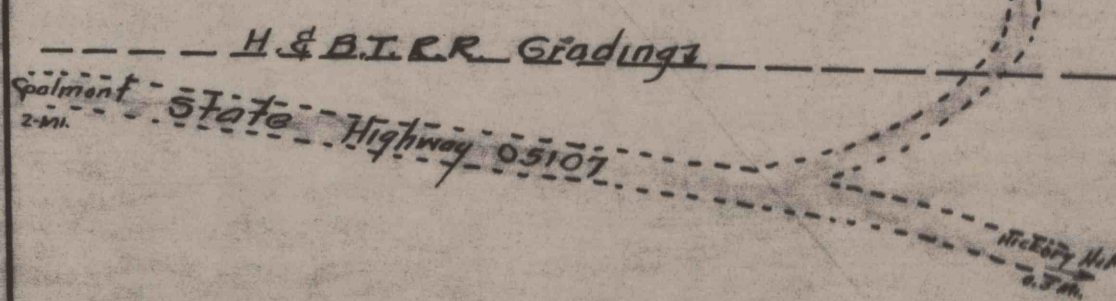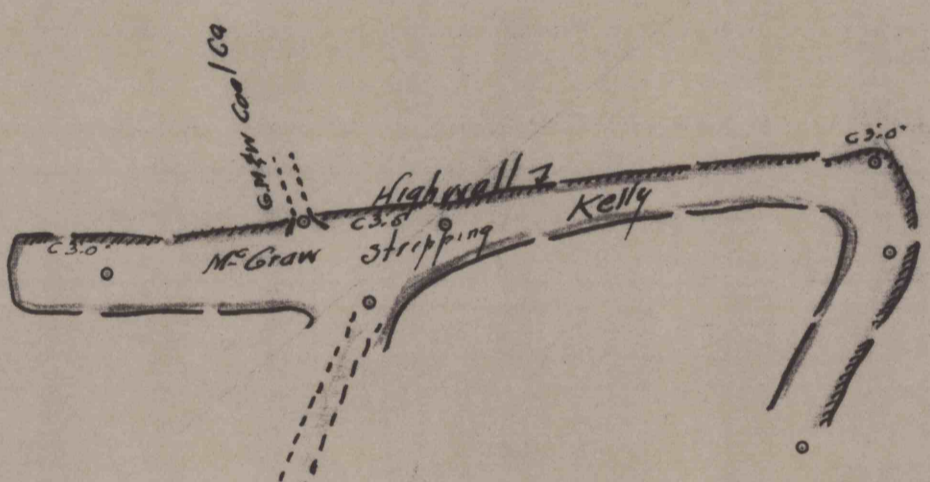

Dewada Mine

Operated By
James Krieger
Broad Top Township - Bedford County
Pennsylvania 1" = 100'

1961 By Rsky
Revised: Nov. 1961
Dec. 1965