


1004 RAG

1005 RAG

1002 RAG

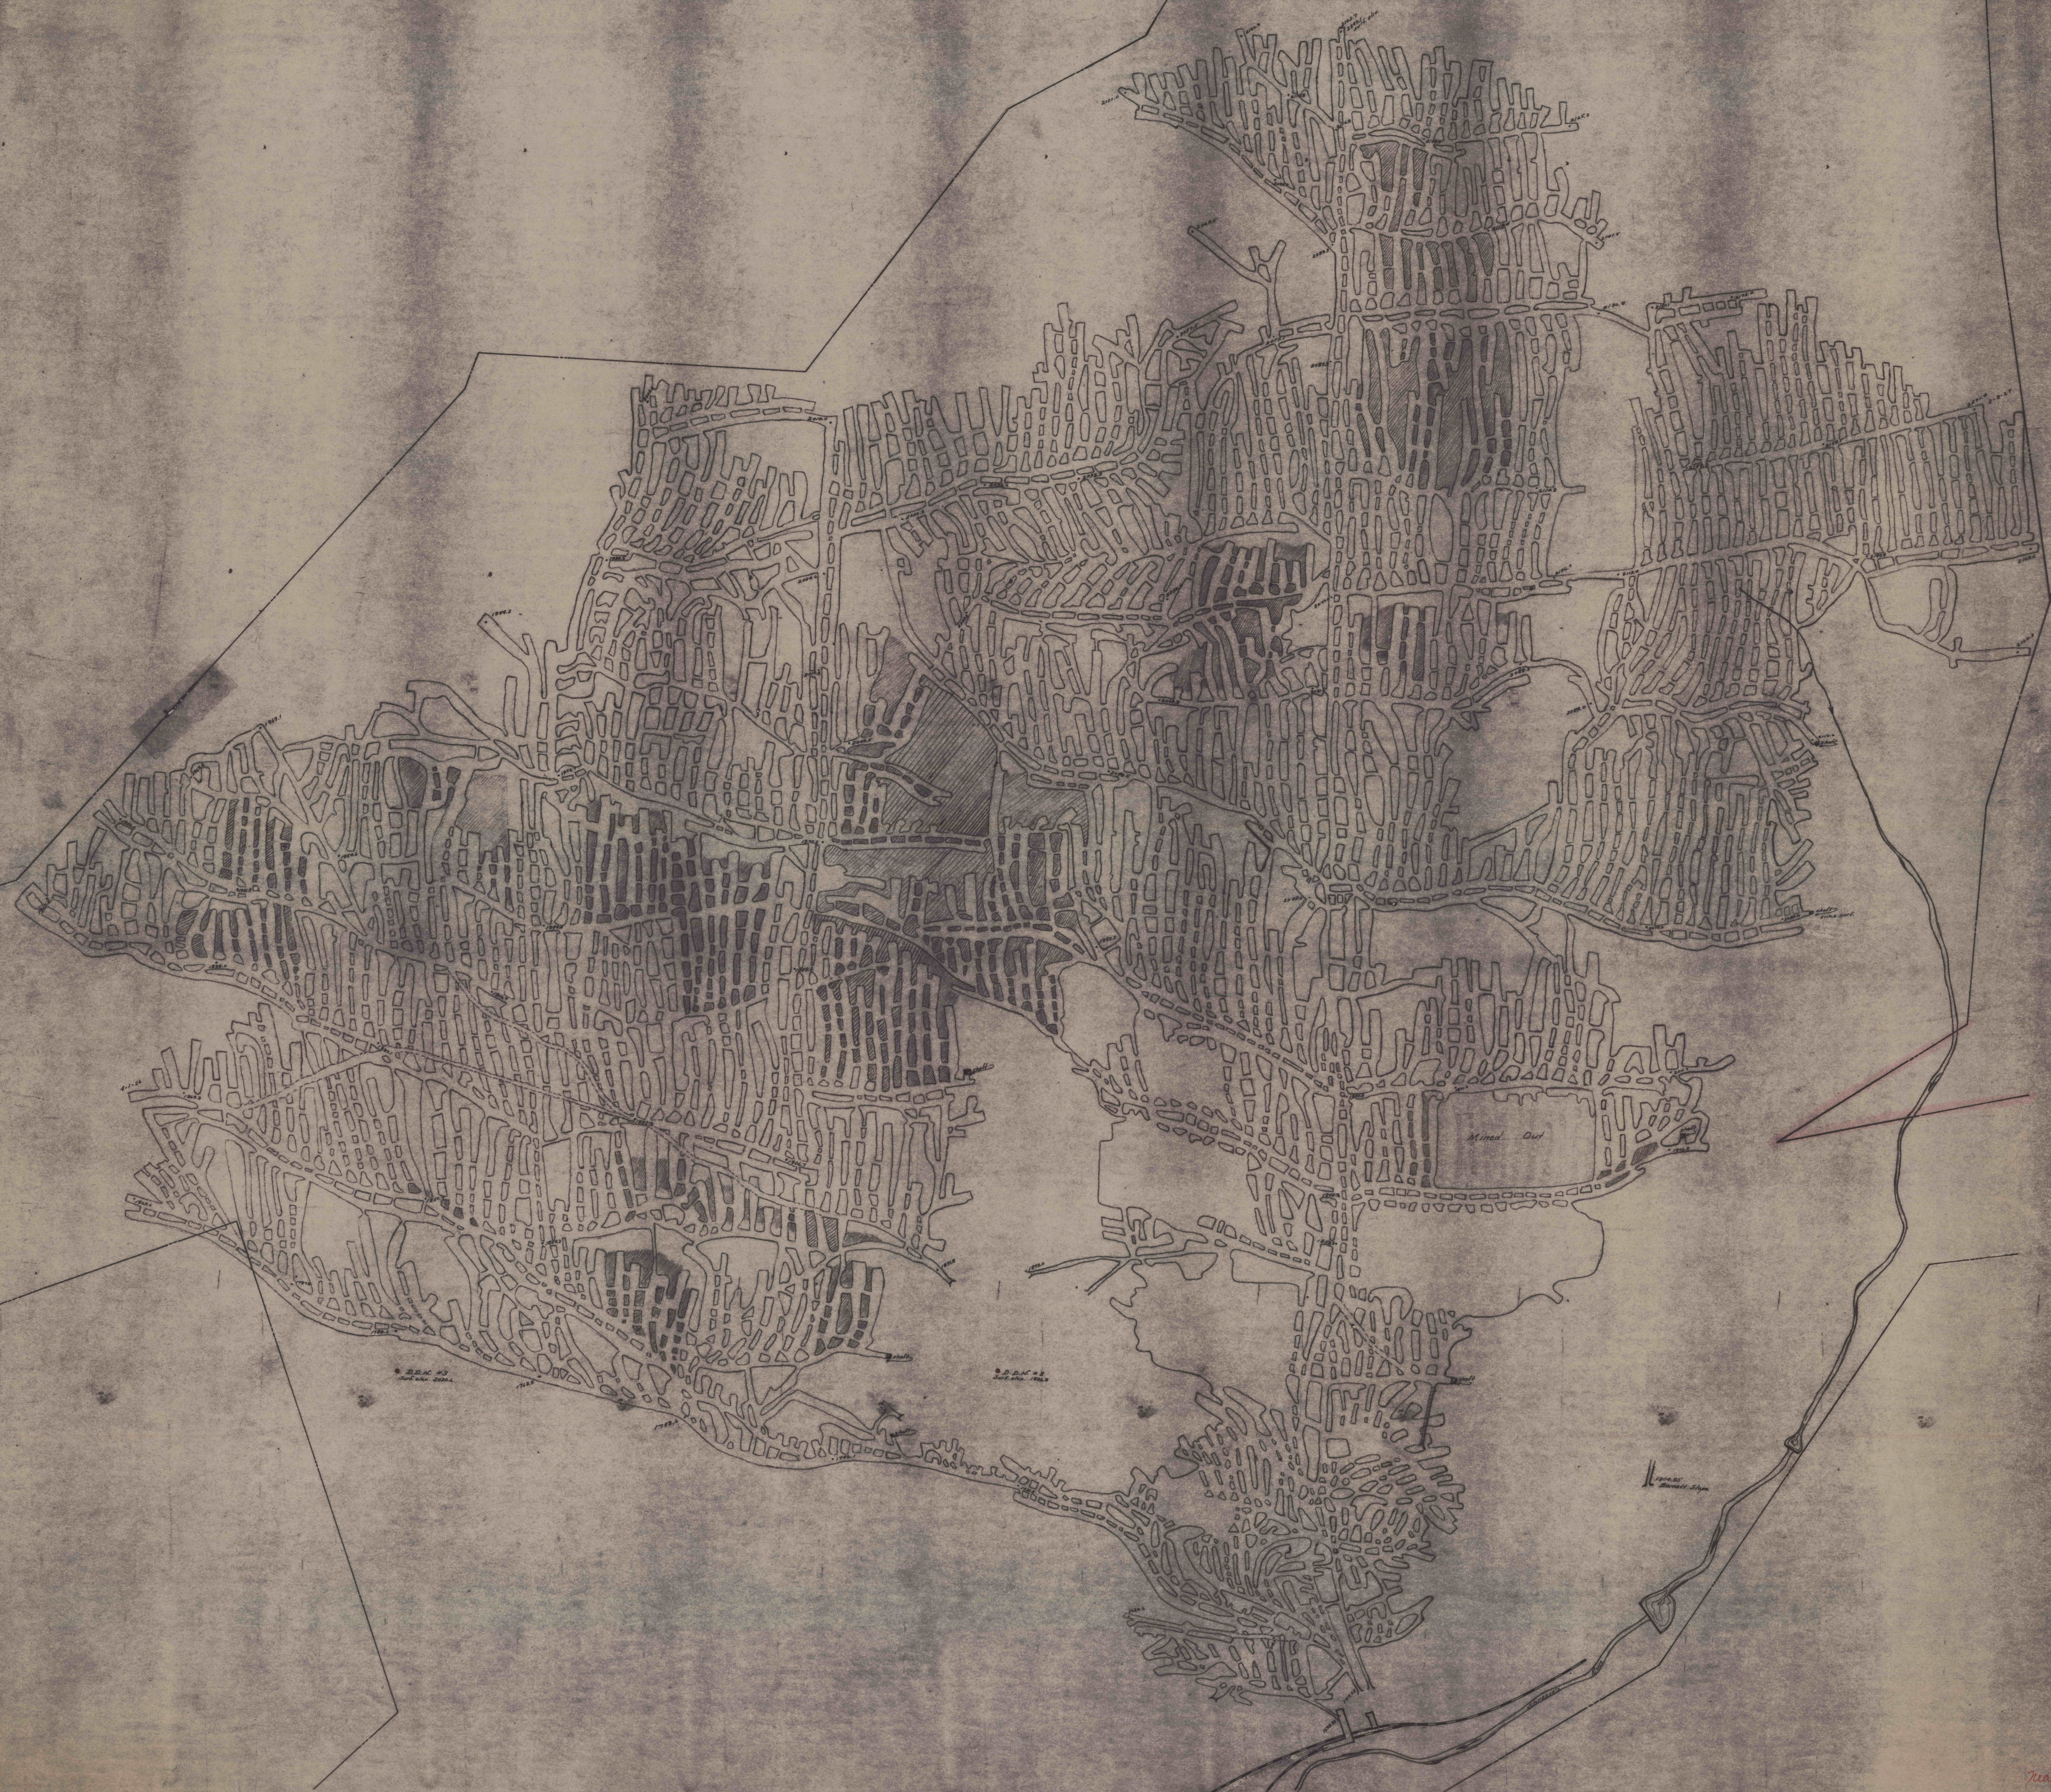

D.D.M. #1
200 yds. 1911

D.D.M. #2
200 yds. 1911

Mined Out

Scale
1" = 100'

Near Finleyville
#45

M. J. HIGGINS - RAG MINE