


Tussey Mt. Mines
(Kay Coal Mining Company)

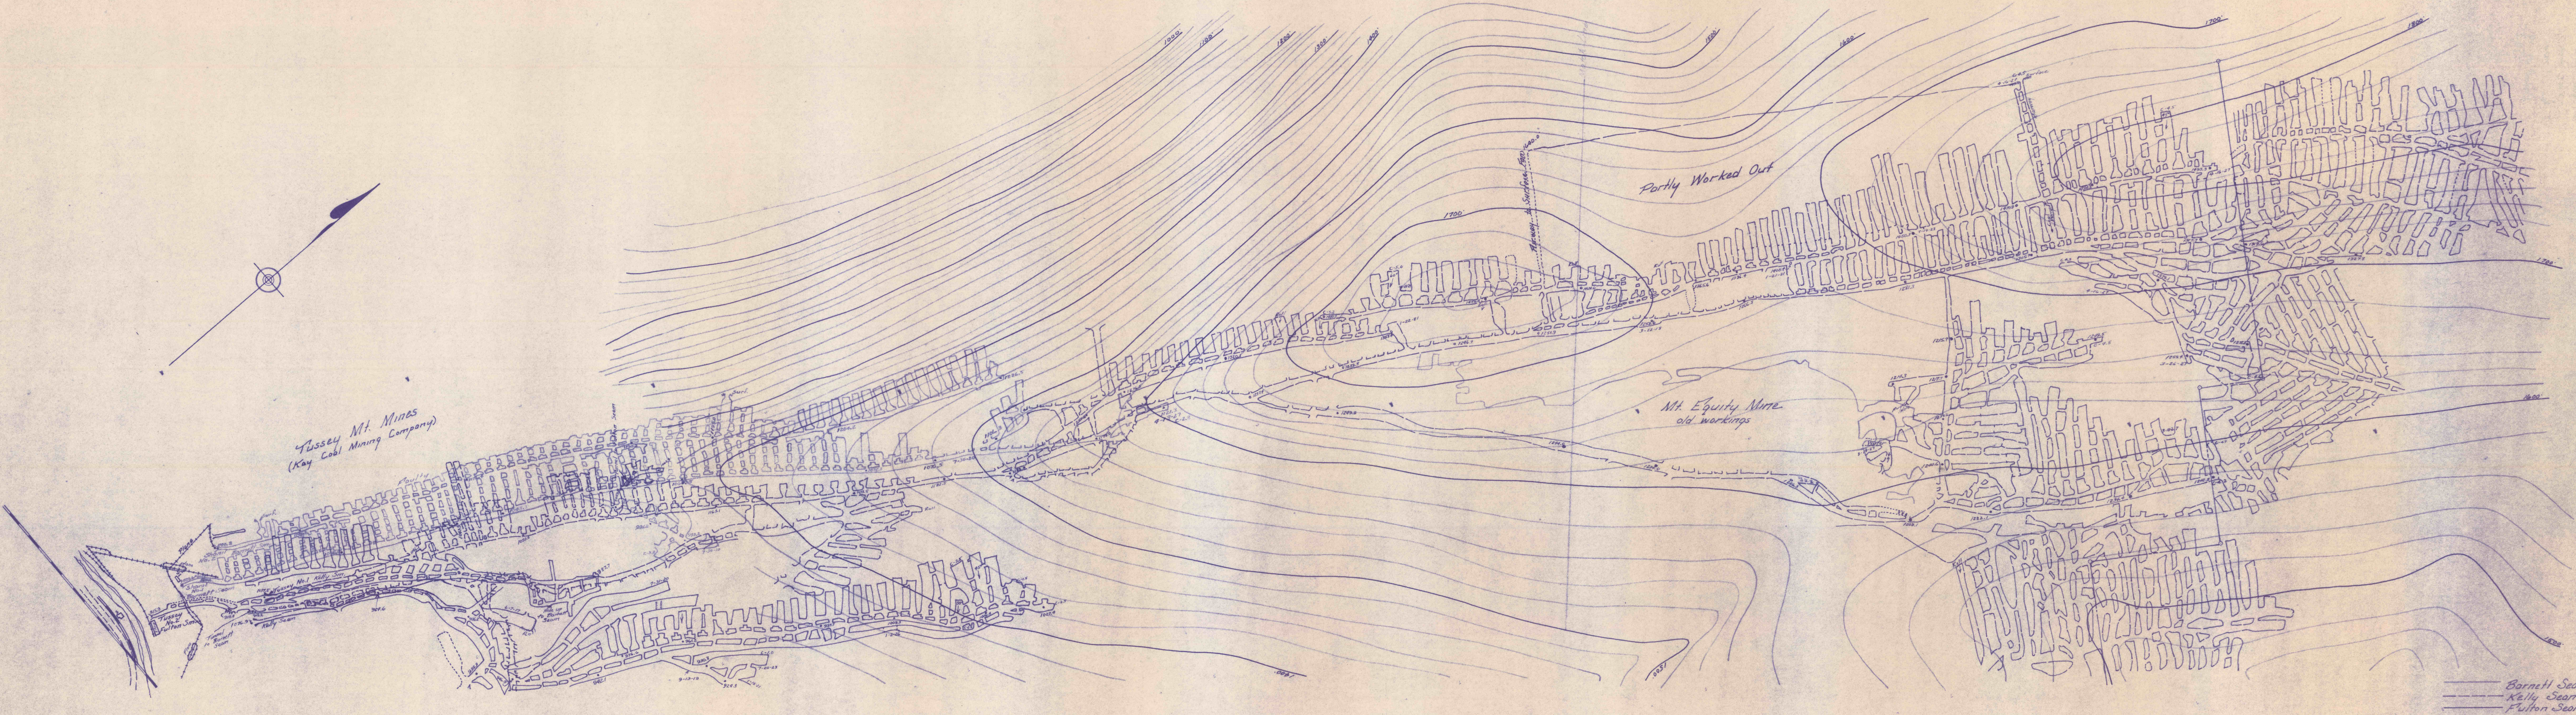

Partly Worked Out

Mt. Equity Mine
old workings

— Barnett Seam
— Kelly Seam
— Fulton Seam