

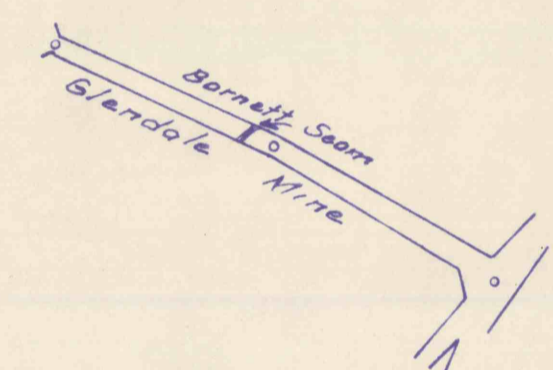


Cambria Iron Co.

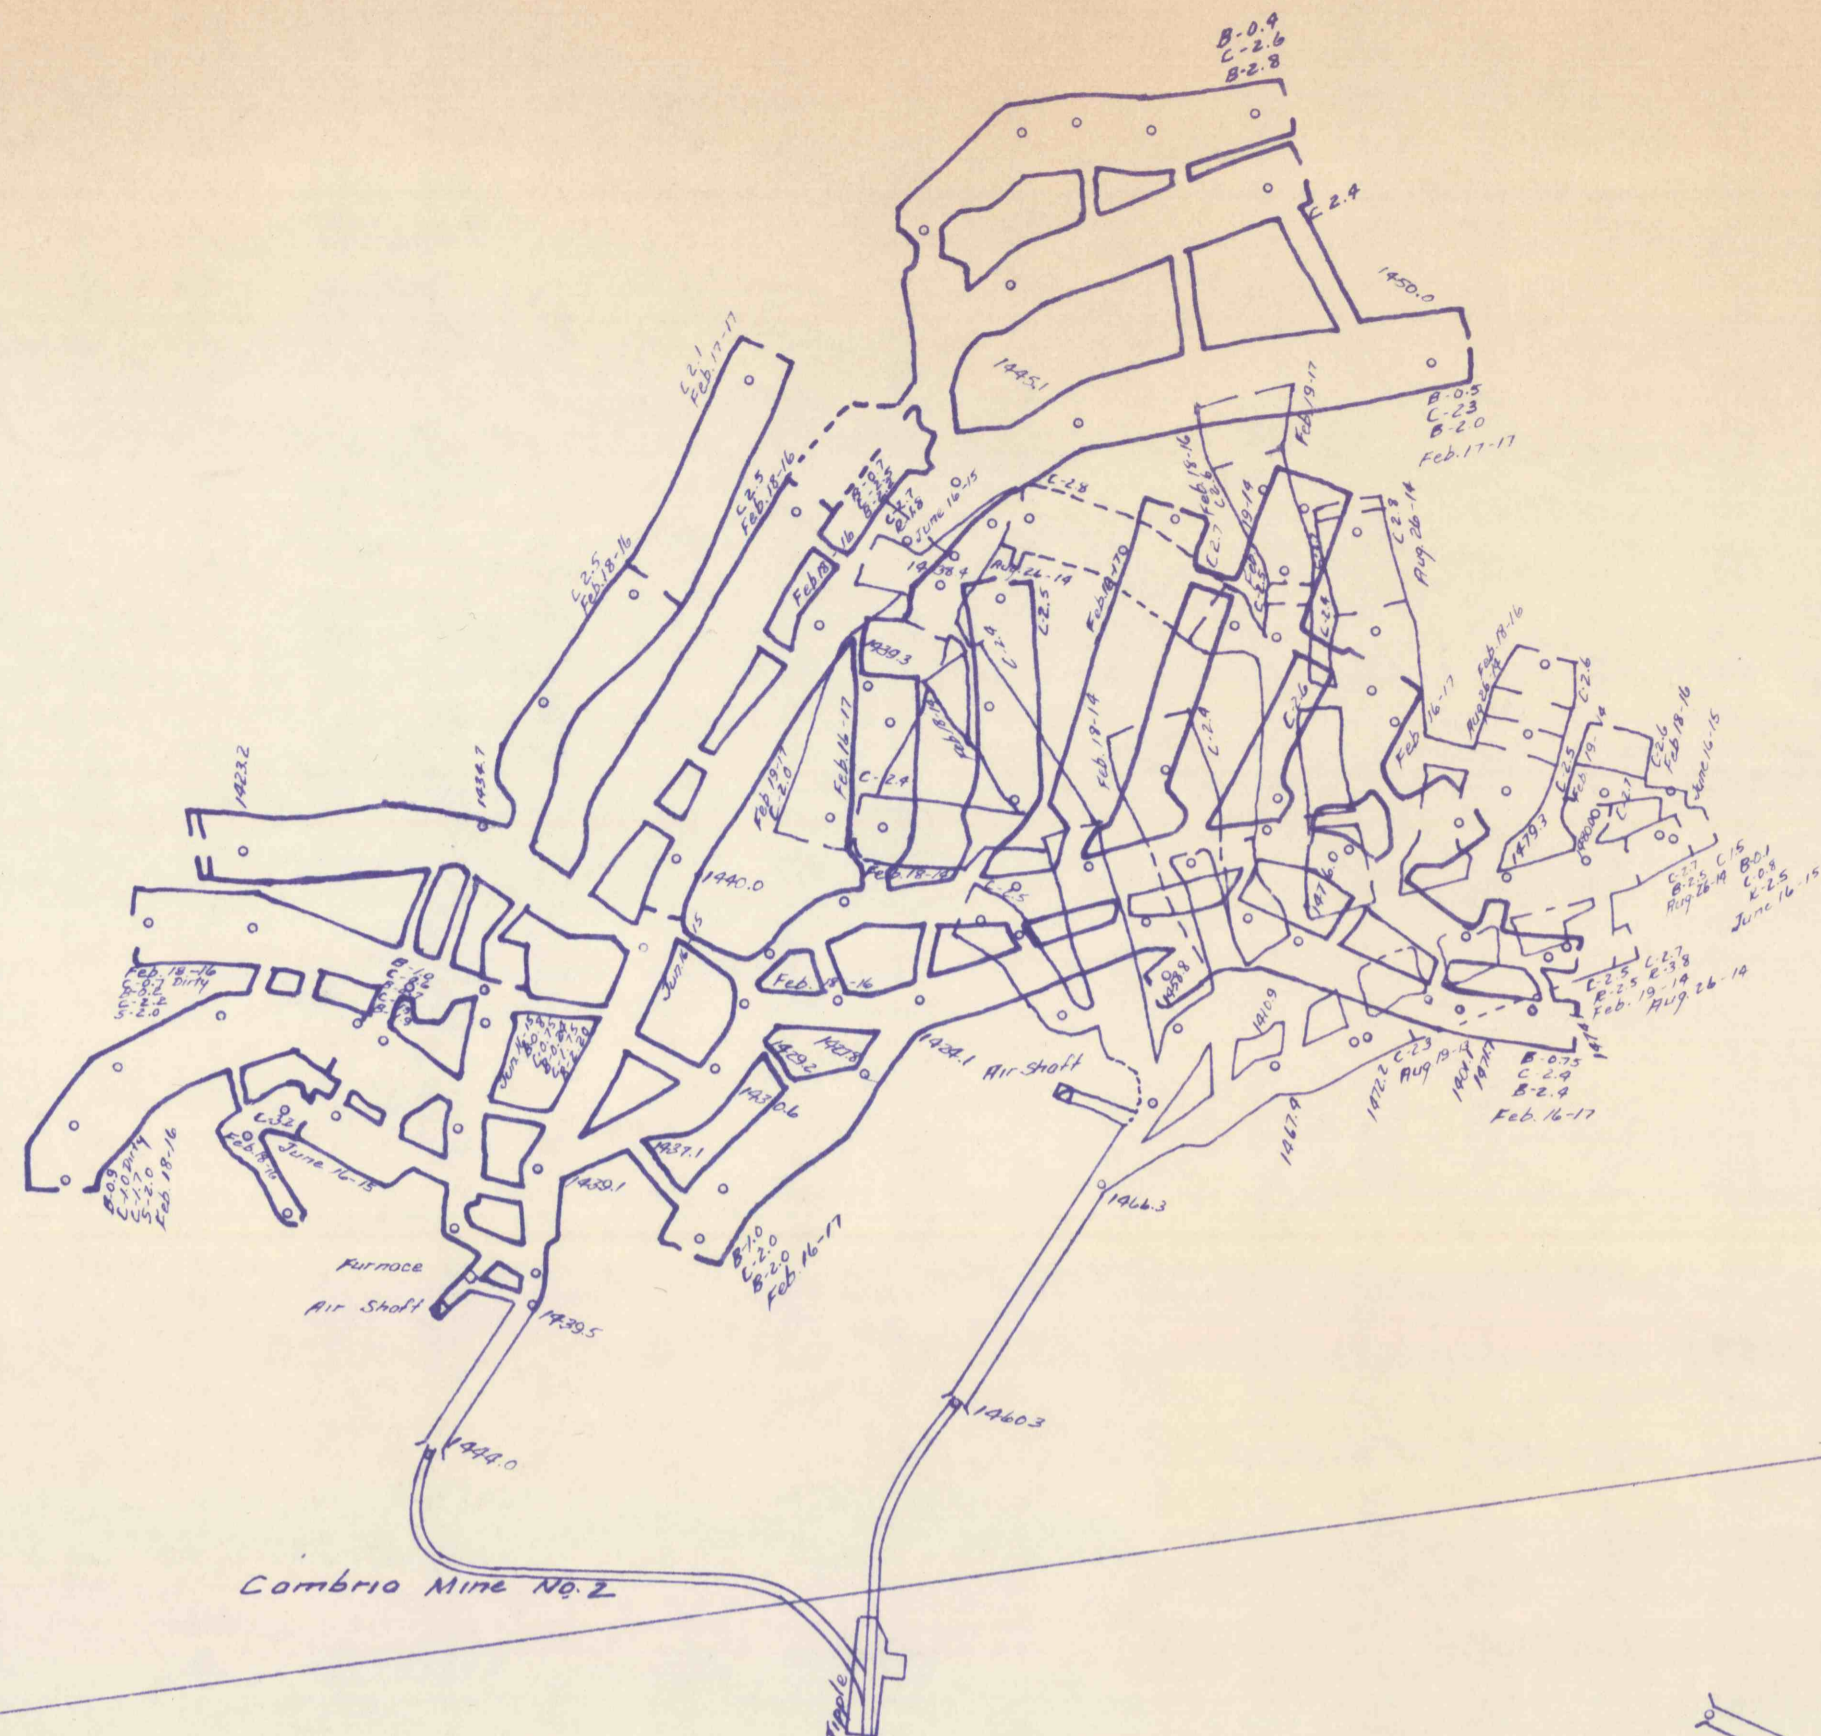

in twin to the Barnett Seam

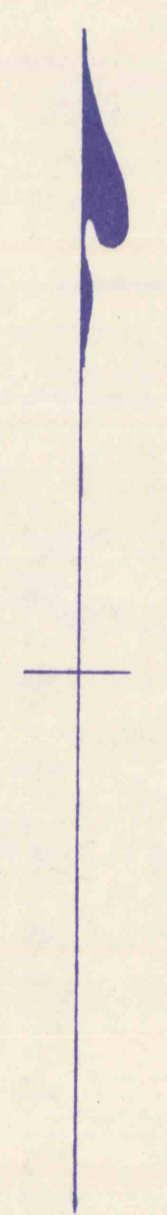

Chevington Mine No. 3
Barnett Seam

