


LINE OF LEASE TO BAYLOR COAL CO.

HARRY WIFE OUTCROP OF FULTON SEAM

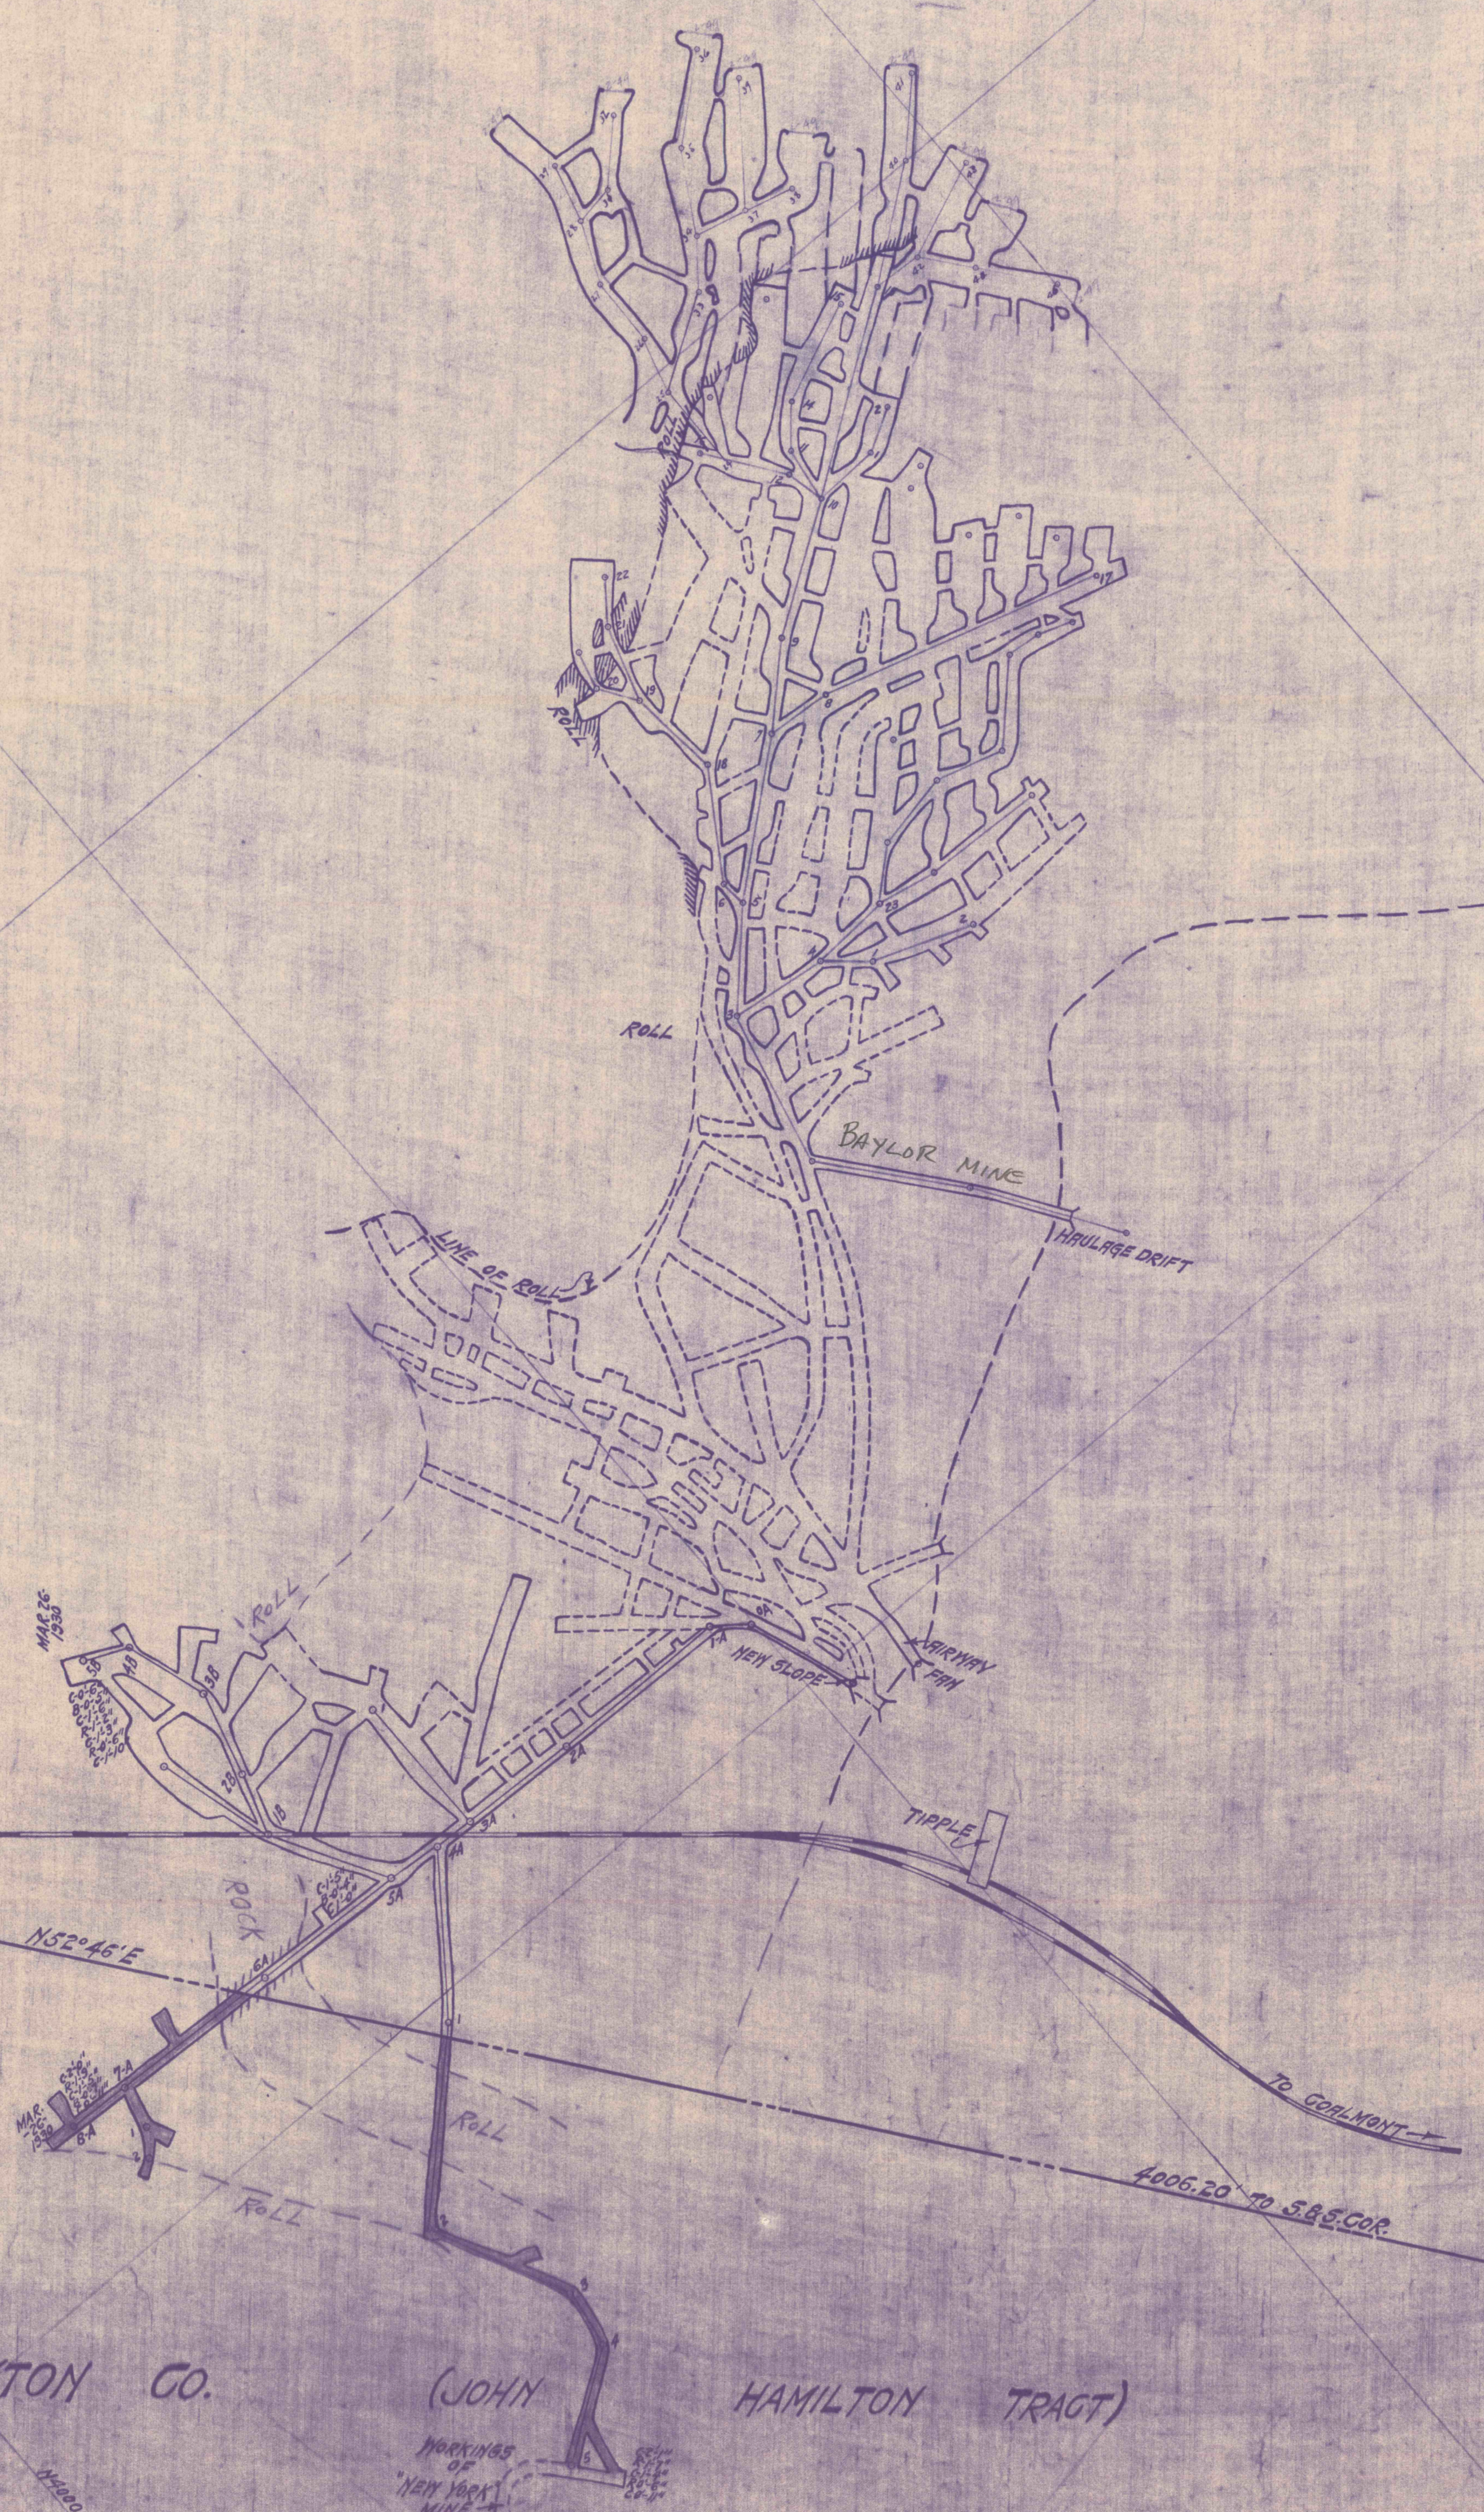

MAP SHOWING MINING OPERATIONS
 OF THE
BAYLOR COAL CO.
 IN THE FULTON SEAM
 ON LANDS OF THE
PENN CENTRAL POWER CO.
 BROAD TOP TOWNSHIP, BEDFORD COUNTY, PA.

SCALE: 1"=100'

JOS. S. SILLYMAN & CO.
ENGINEERS
ALTOONA, PA.

SURVEY REVISED TO [REDACTED]

NOTE - WORKINGS SHOWN BY DASH LINES ARE INACCESSIBLE OR TRACED FROM OTHER MAPS.

EVERETT-SAXTON CO. (JOHN HAMILTON TRACT)