
 


No. 1, No. 9, and
NO. 10 MINE
BROADTOP MINING CO.

BROADTOP TWP. BEDFORD COUNTY PENNA.
Scale 1" = 100'

— 1944 —
Revised To Sept 1954

Guy C. Askey, Min. Engr.
Bedford, Pa.

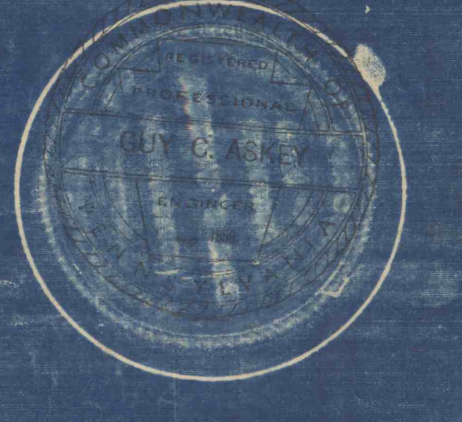

Handwritten note: fault dip 21°

Handwritten note: APPROX. WATER LEVEL

Handwritten note: ANTICLINE

Handwritten note: SYNCLINE

Handwritten note: ANTICLINE

JOHN LANGDON EST.

SHAFT COAL CO.

SHAFT COAL CO.

Handwritten note: Longwall Shaft
Top El. 1289.96
Bot El. 120.96

