

MC-7

R. C. & I. CO.

H. &


R. R.

R. CO.

RIDDLE

J. MOYER  
NOW  
H. & B. T. M. R. R. CO.

Surveyed To  
Oct. 16, 1894  
May 27, 1895  
Sept. 30, 1896  
Apr. 27, 1907

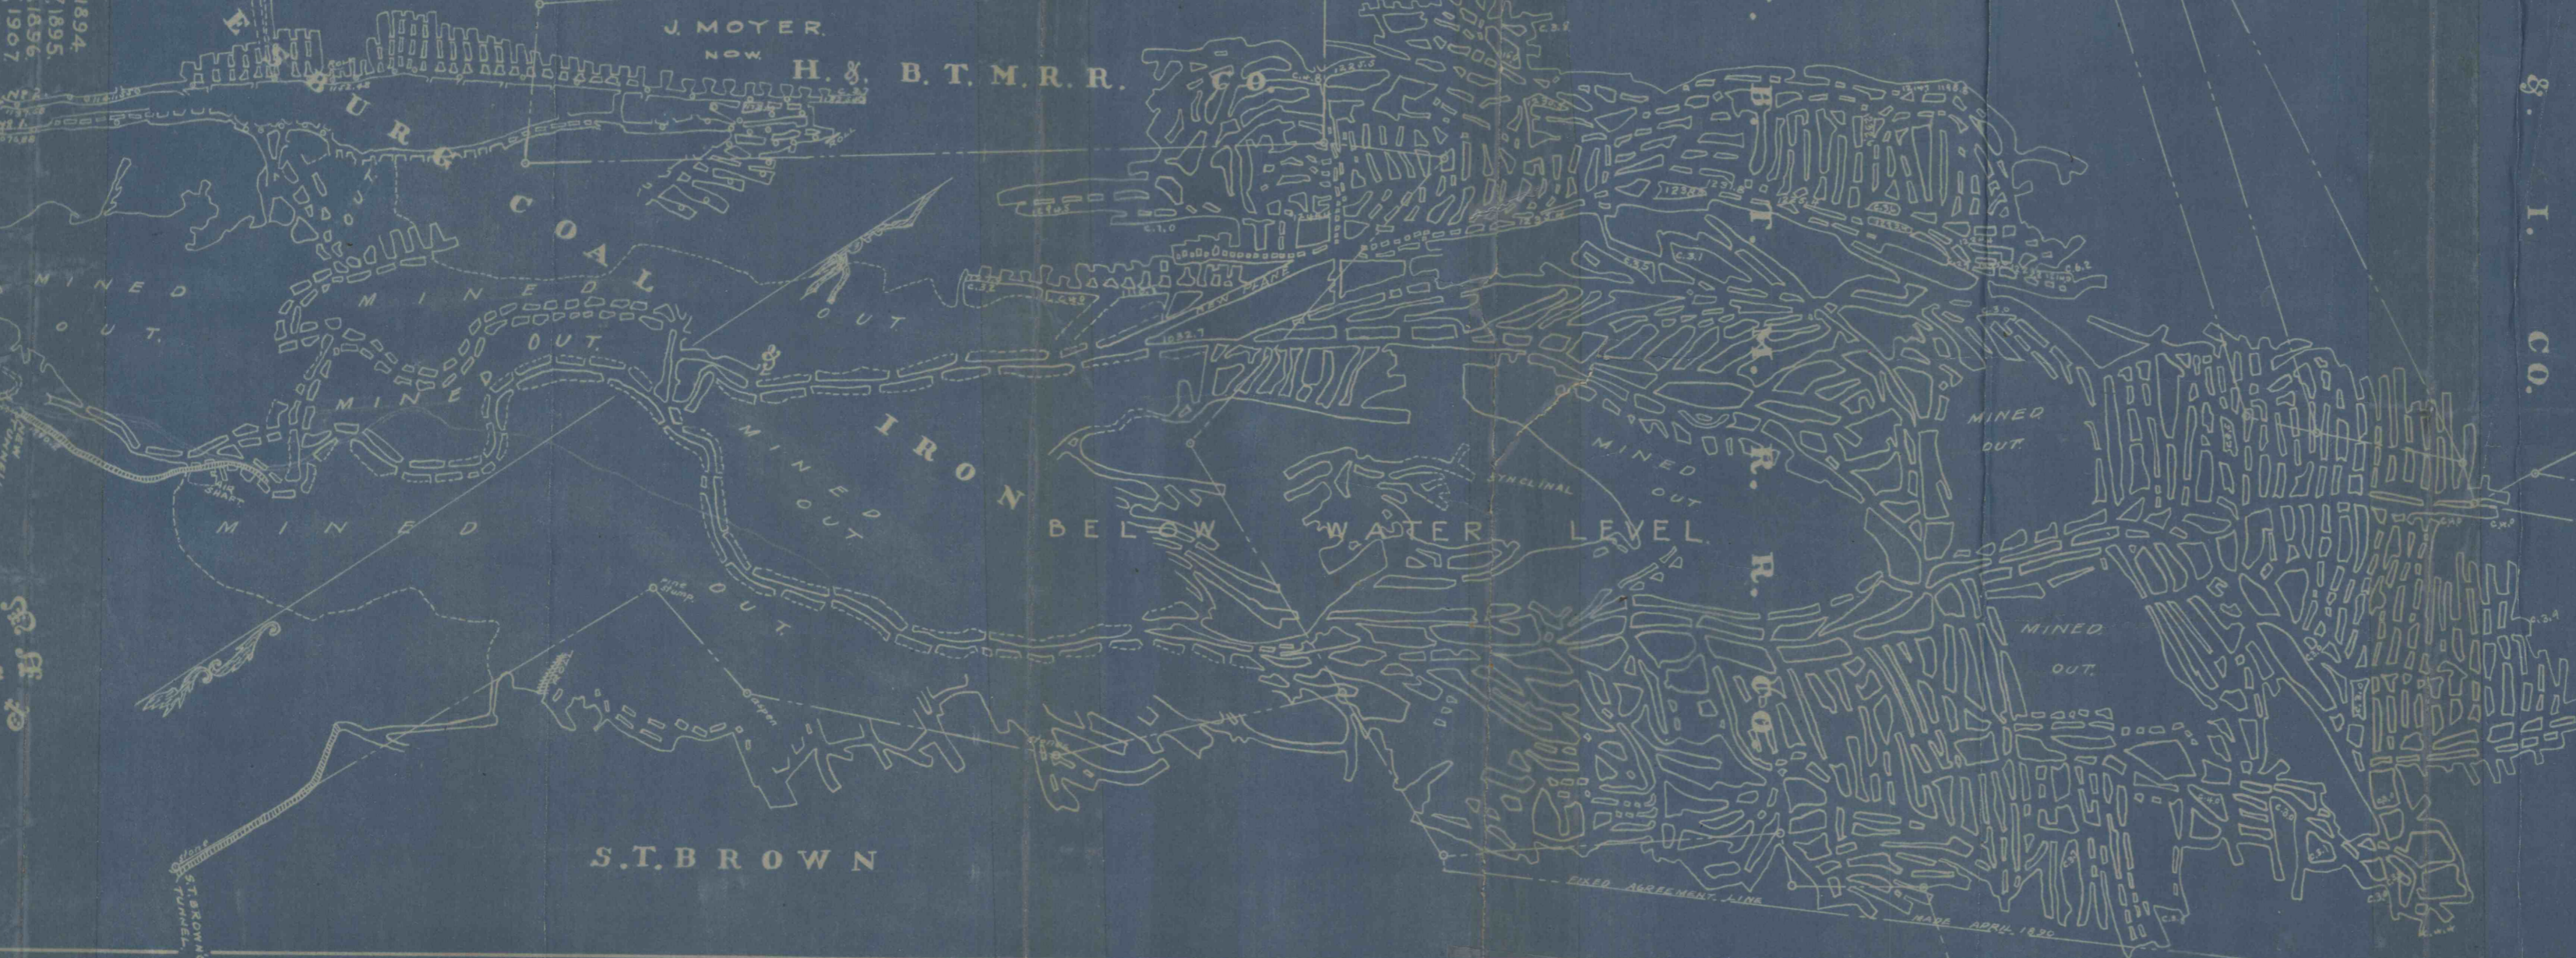

S.T. BROWN

**MOUNT EQUITY**  
COLLIERY  
OPERATED BY THE  
**KEMBLE IRON CO.**

RIDDLESBURG BEDFORD CO. PENNA.  
SCALE 1 IN = 40 FT.  
REMOWELSDORFF  
MINING ENGR.  
1895  
REDUCED FROM ORIGINAL TRACING  
BY  
STEVENSON & KNIGHT ENGRS.  
SCRANTON PA.

MC-7