


1" = 1000'

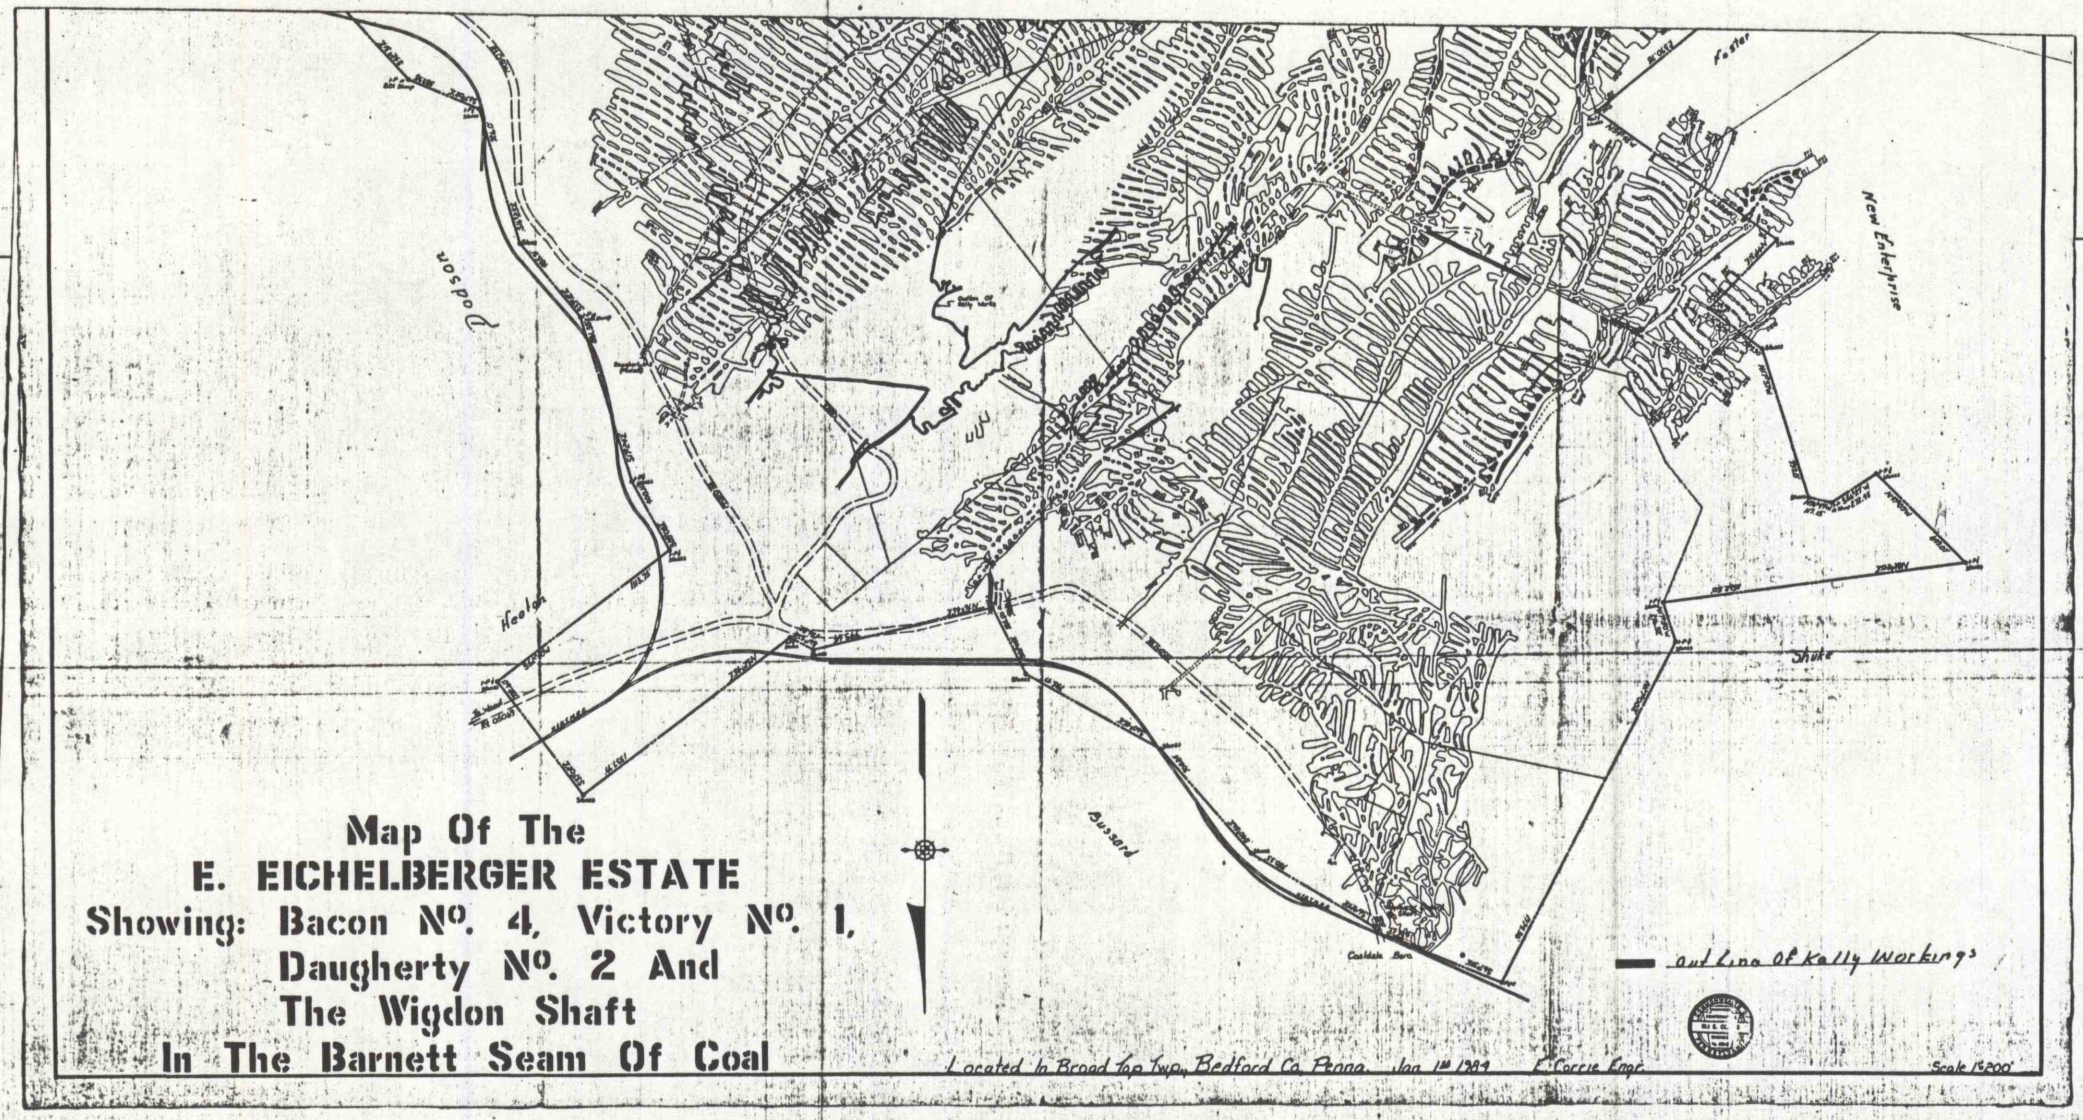

**Map Of The  
E. EICHELBERGER ESTATE**  
Showing: Bacon No. 4, Victory No. 1,  
Daugherty No. 2 And  
The Wigdon Shaft  
In The Barnett Seam Of Coal

Located in Broad Top Twp, Bedford Co. Penna. Jan 1st 1889  
