


Curtman & Maderr

B-45

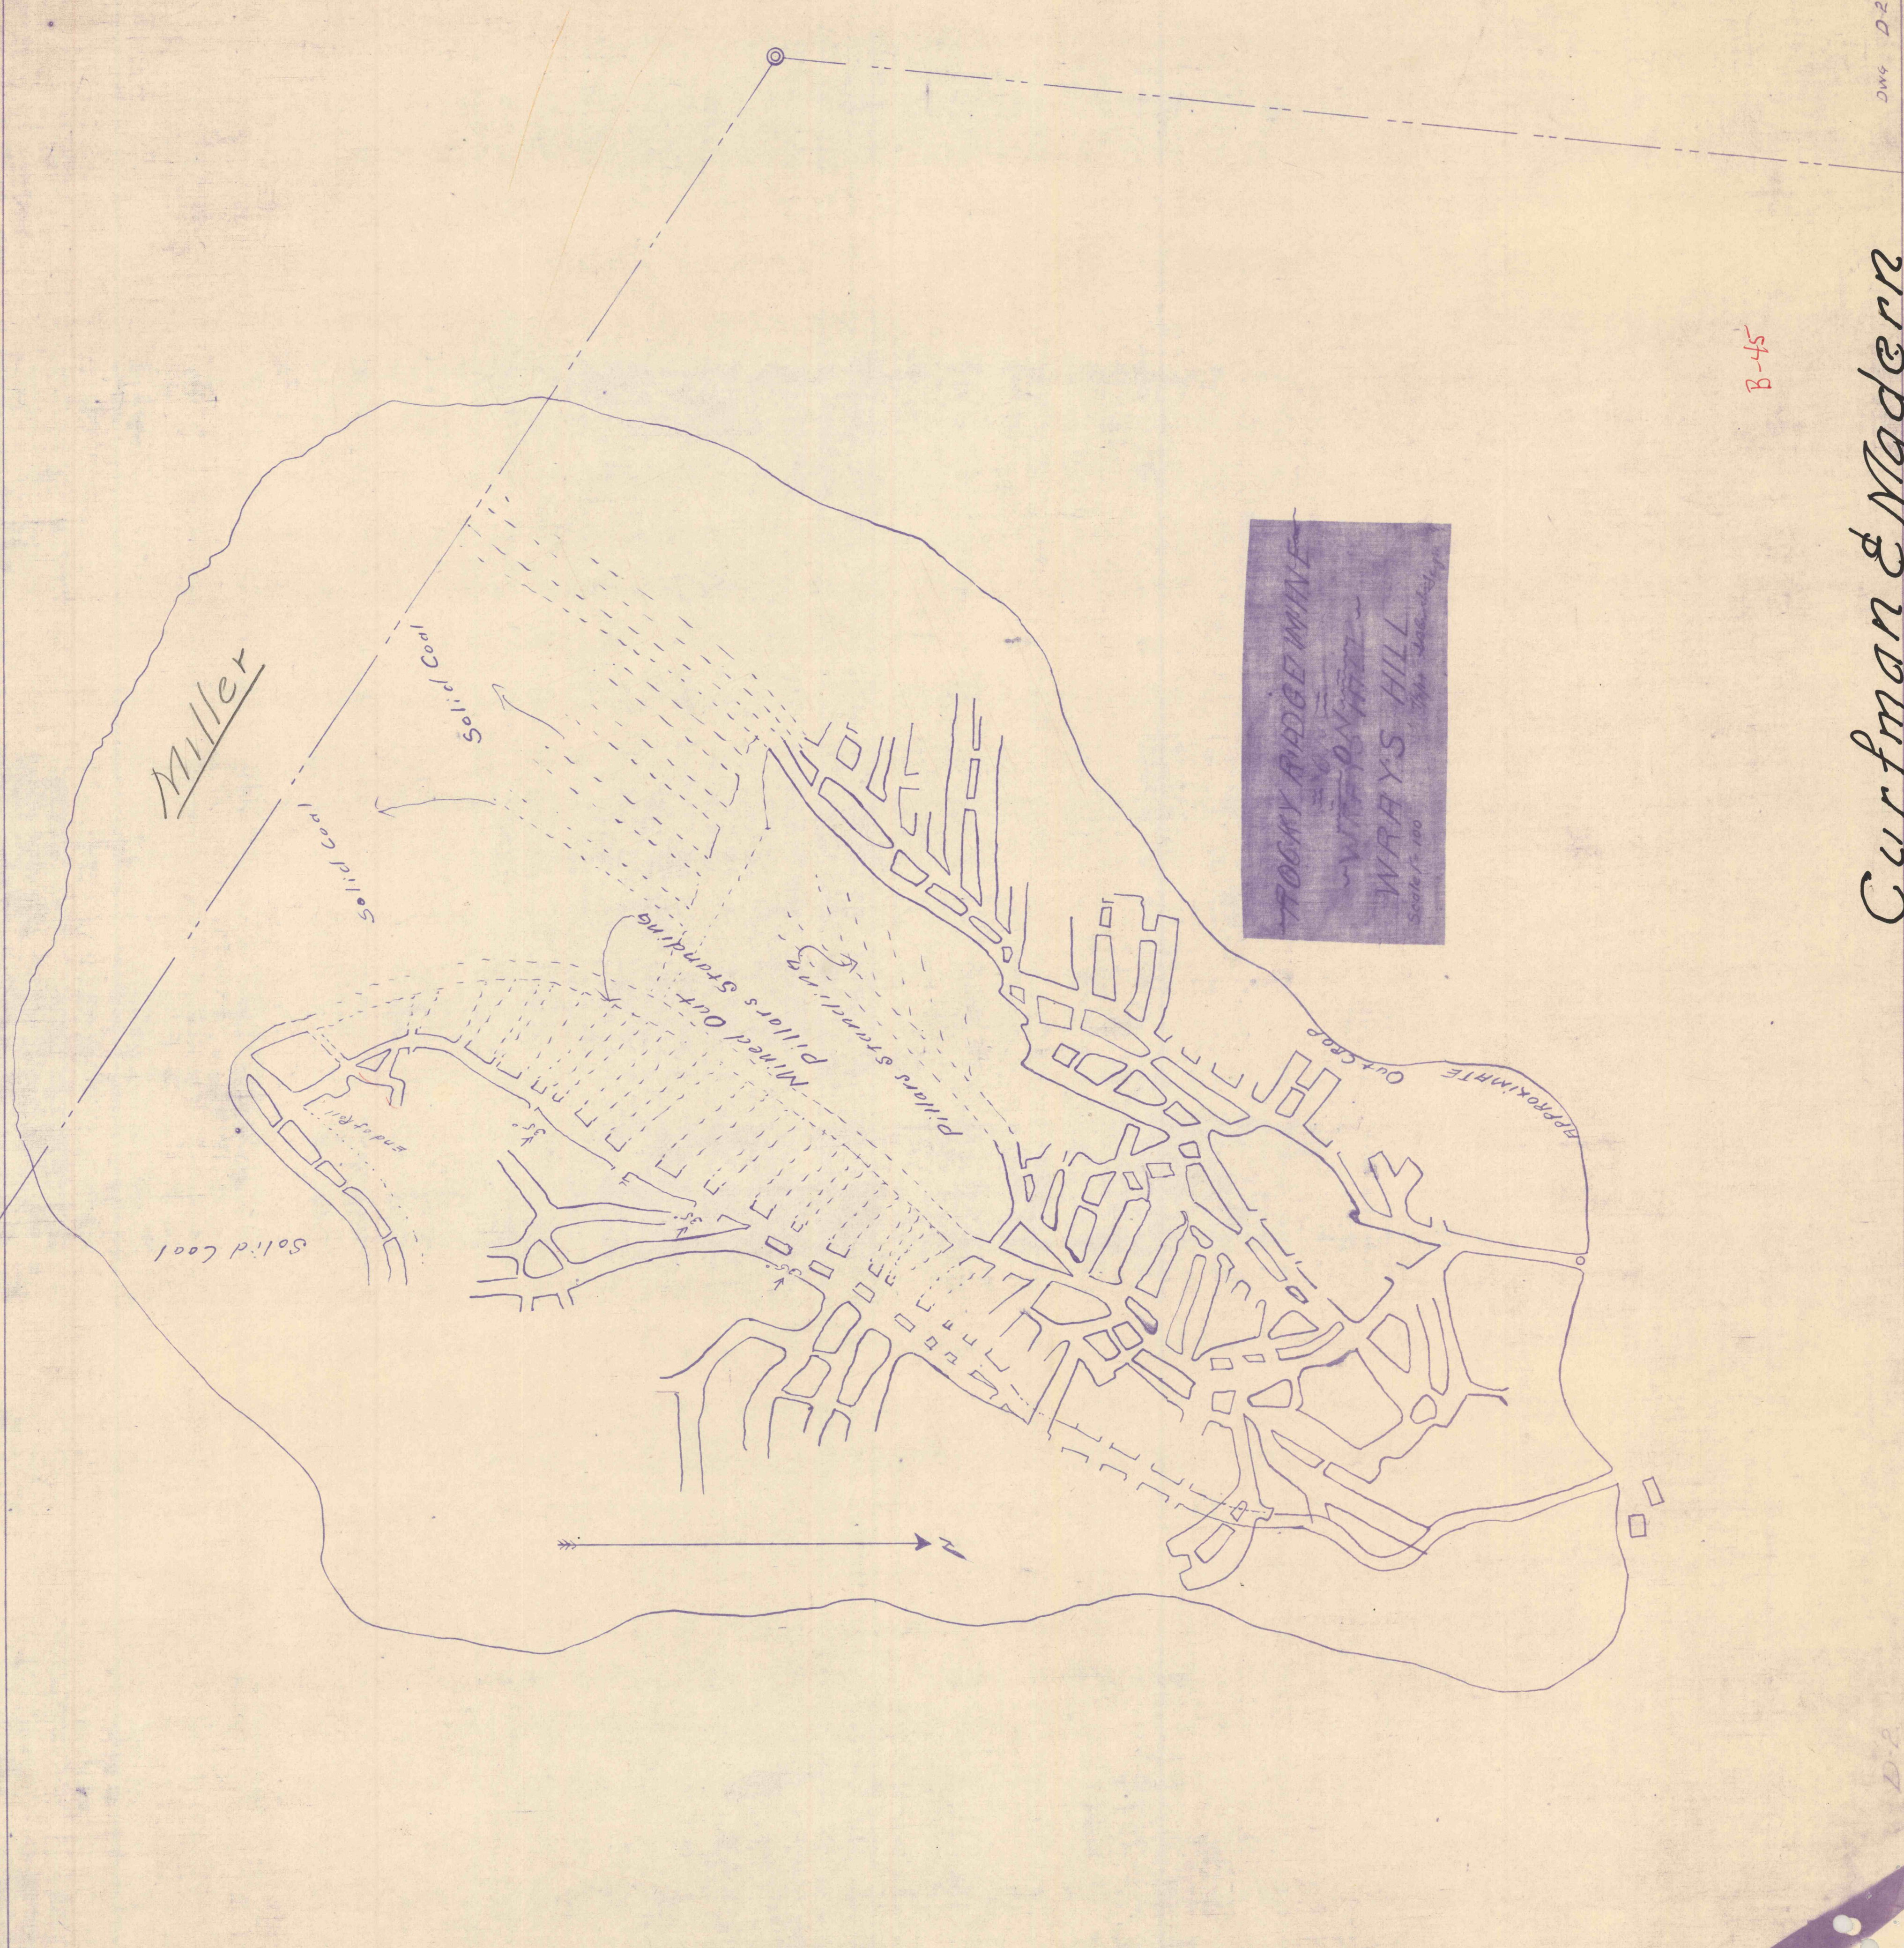

ROCKY RIDGE MINE  
 WAYS HILL  
 Scale 1" = 100'  
 1/10/1911