


NO.	DATE	BY	REVISION	NO.	DATE	BY	REVISION

MAP SHOWING MINE WORKINGS
OF THE
RED ROSE AND LOUDON MINES
RUSSET COAL CO.

SITUATE IN
LOGAN TWP BLAIR CO. PA.
SCALE 1"=100' SEPT. 21, 1921

(FETTERMAN ENG. CO.)
(JOHNSTOWN, PA.)

SUCCEEDED MAY, 1919 BY
A. CALVIN GALBRAITH
PROFESSIONAL ENGINEER
JOHNSTOWN, PA.

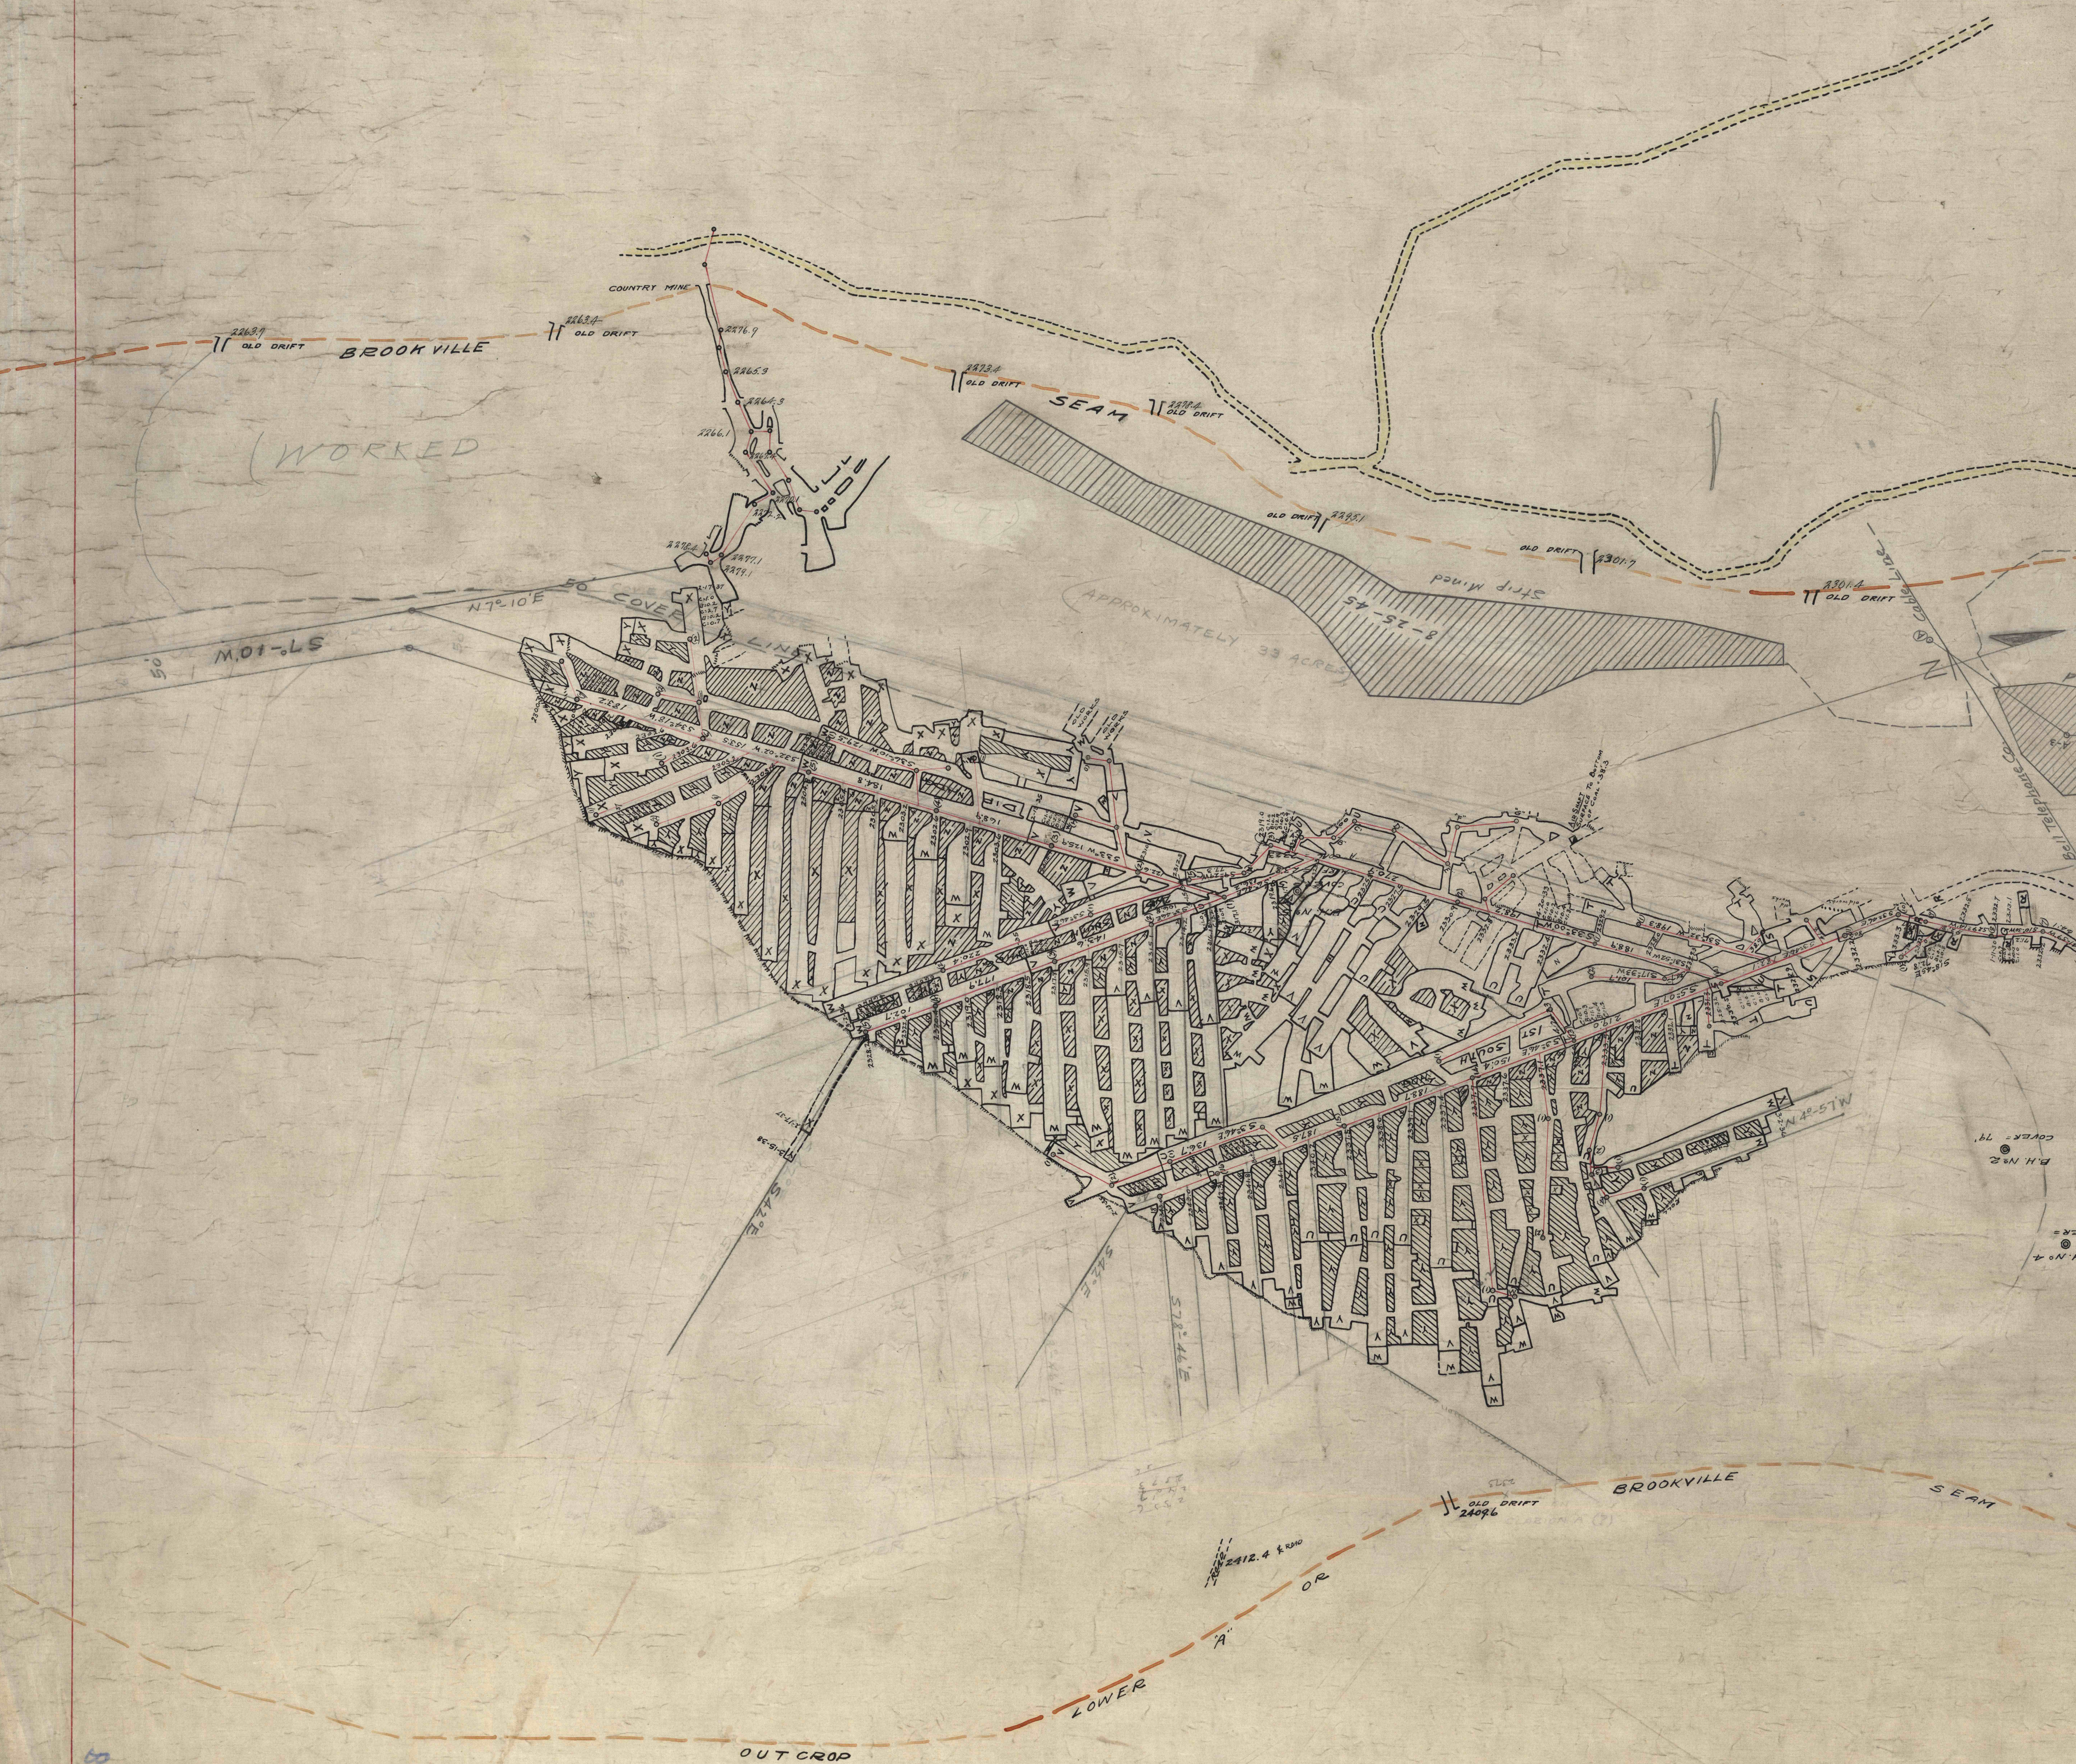

51-113