


LEGEND							
Letter	Survey Date	Surveyed By	Plotted By	Letter	Survey Date	Surveyed By	Plotted By
"A"	Nov 7-22	Singer	Edkins	"O"	Jan 8, 1923	Galbraith	A. R. Hinks
"B"	Nov 8-22	"	"				
"C"	Sept 25-23	Galbraith	Hinks				
"D"	Apr 9-24	"	Edkins				
"E"	Oct 10-24	"	Galbraith				
"F"	Jan 1-25	"	Hinks				
"G"	Nov 20-25	"	A. Hinks				
"H"	Nov 12-26	"	"				
"I"	Feb 1-27	"	"				
"J"	June 10-27	"	Galbraith				
"K"	Nov 7-27	"	A. Hinks				
"L"	Oct 30-29	"	"				
"M"	June 1-29	"	"				
"N"	Jan 21-30	"	"				

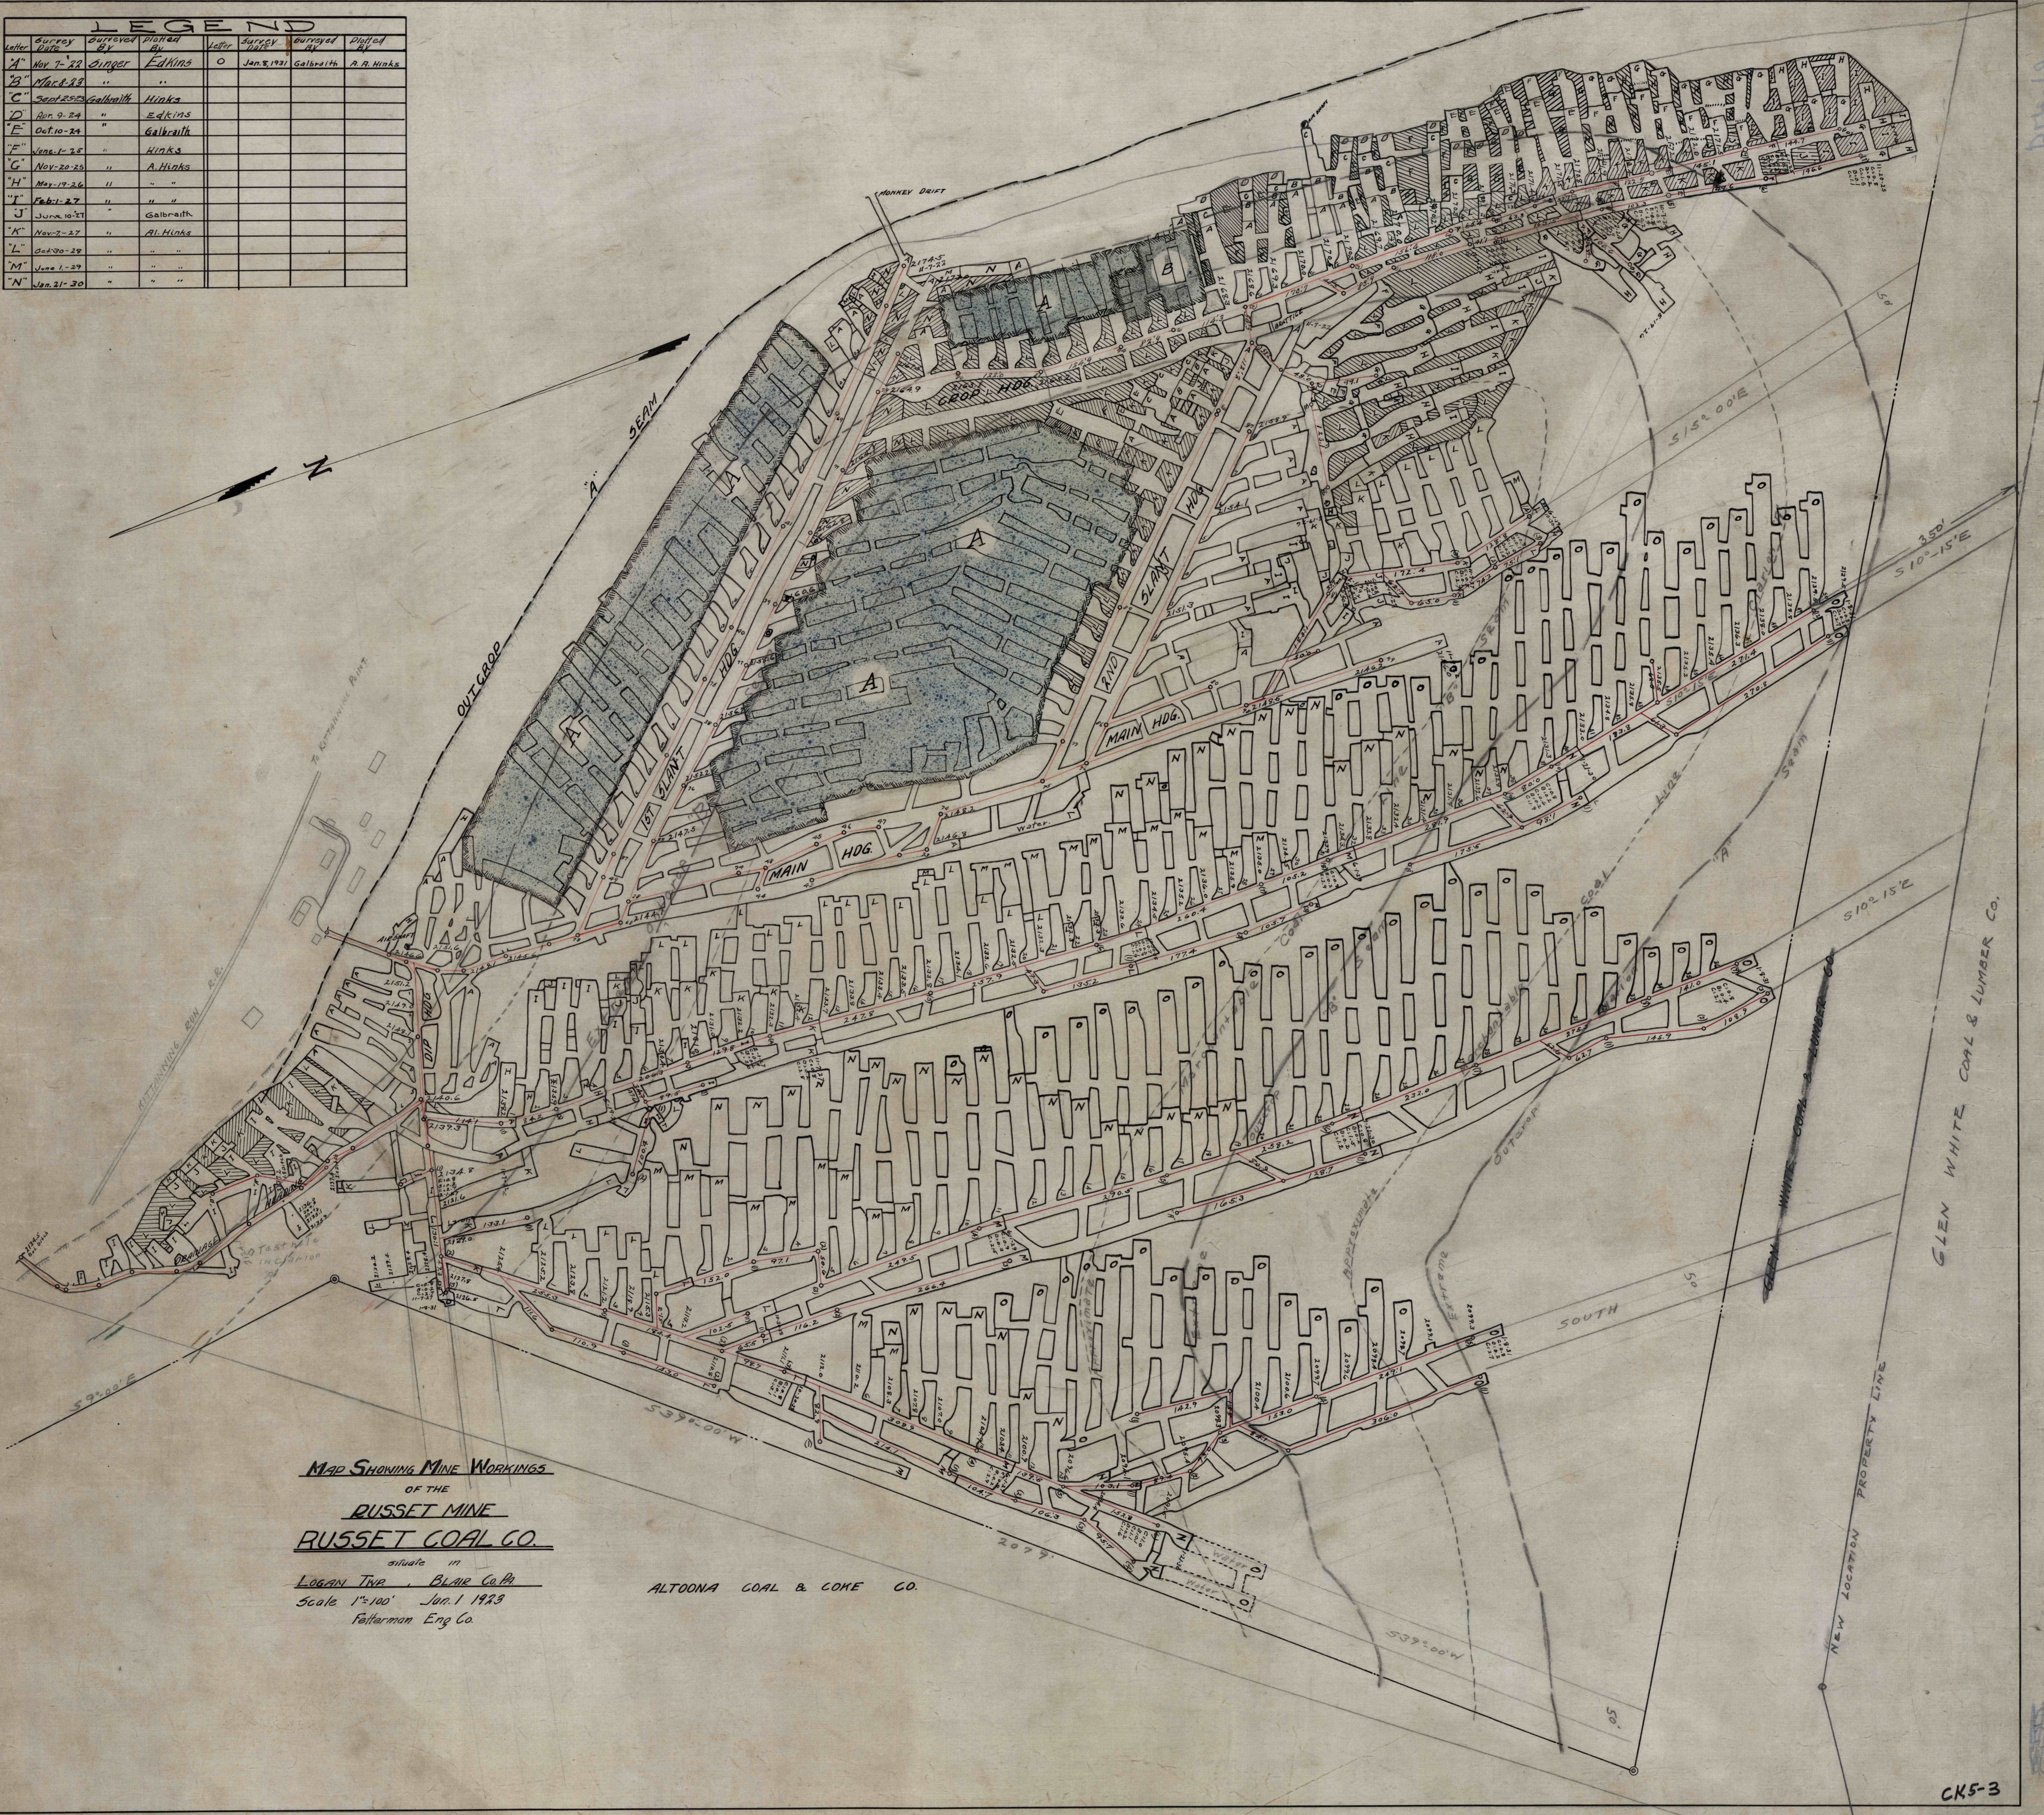

MAP SHOWING MINE WORKINGS
 OF THE
RUSSET MINE
RUSSET COAL CO.
 situated in
LOGAN TWP., BLAIR CO., PA.
 Scale 1"=100' Jan. 1 1923
 Fetterman Eng Co.

ALTOONA COAL & COKE CO.

GLEN WHITE COAL & LUMBER CO.

NEW LOCATION PROPERTY LINE