GLEN WHITE COAL & LUMBER CO.

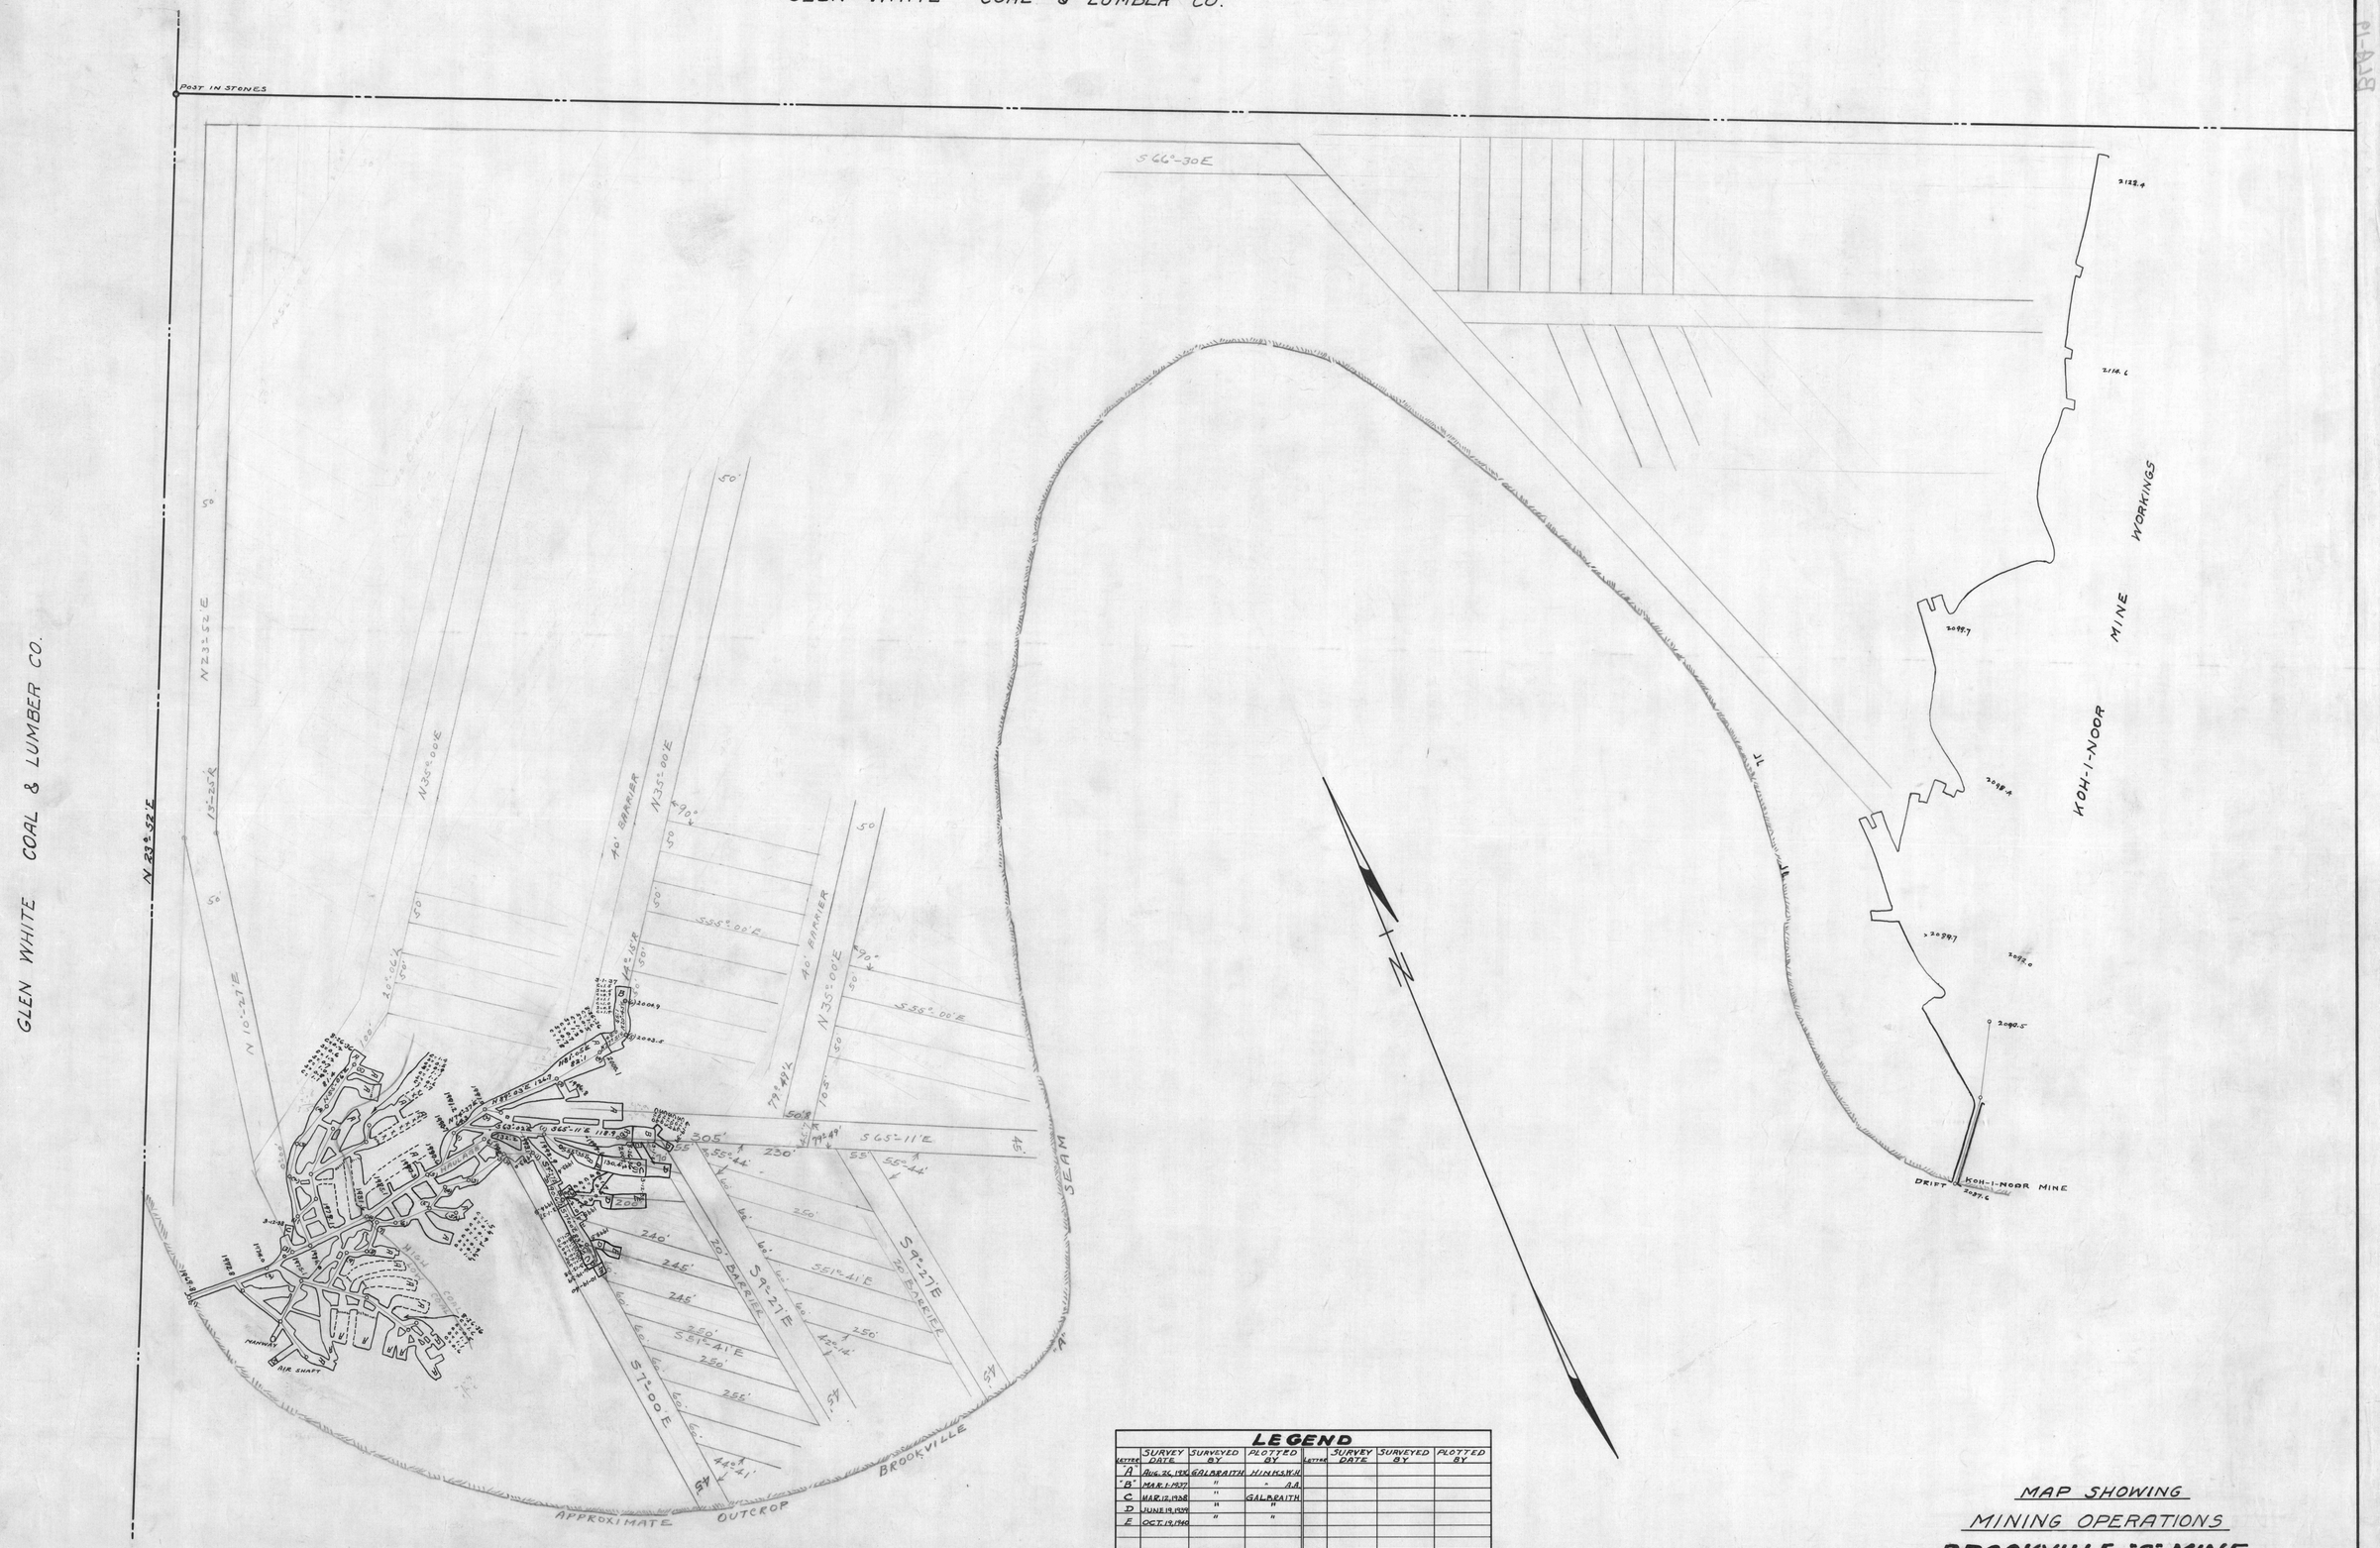

LEGEND							
LETTER	SURVEY DATE	SURVEYED BY	PLOTTED BY	LETTER	SURVEY DATE	SURVEYED BY	PLOTTED BY
"A"	AUG. 26, 1936	GALBRAITH	HINKS, W.H.				
"B"	MAR. 1-1937	"	" A.A.				
C	MAR. 12, 1938	"	GALBRAITH				
D	JUNE 19, 1939	"	"				
E	OCT. 19, 1940	"	"				

MAP SHOWING

MINING OPERATIONS

BROOKVILLE "A" MINE

SURVEYED FOR

GEORGE F. EICHENLAUB

SITUATE AT

GLENWHITE - LOGAN TWP. - BLAIR CO. PA.

SEPT. 14, 1936 SCALE - 1" = 100'

FETTERMAN ENG. CO.

JOHNSTOWN, PA.

CKI-3