WM. DECKER TRACT

ALTOONA COAL & COKE CO.

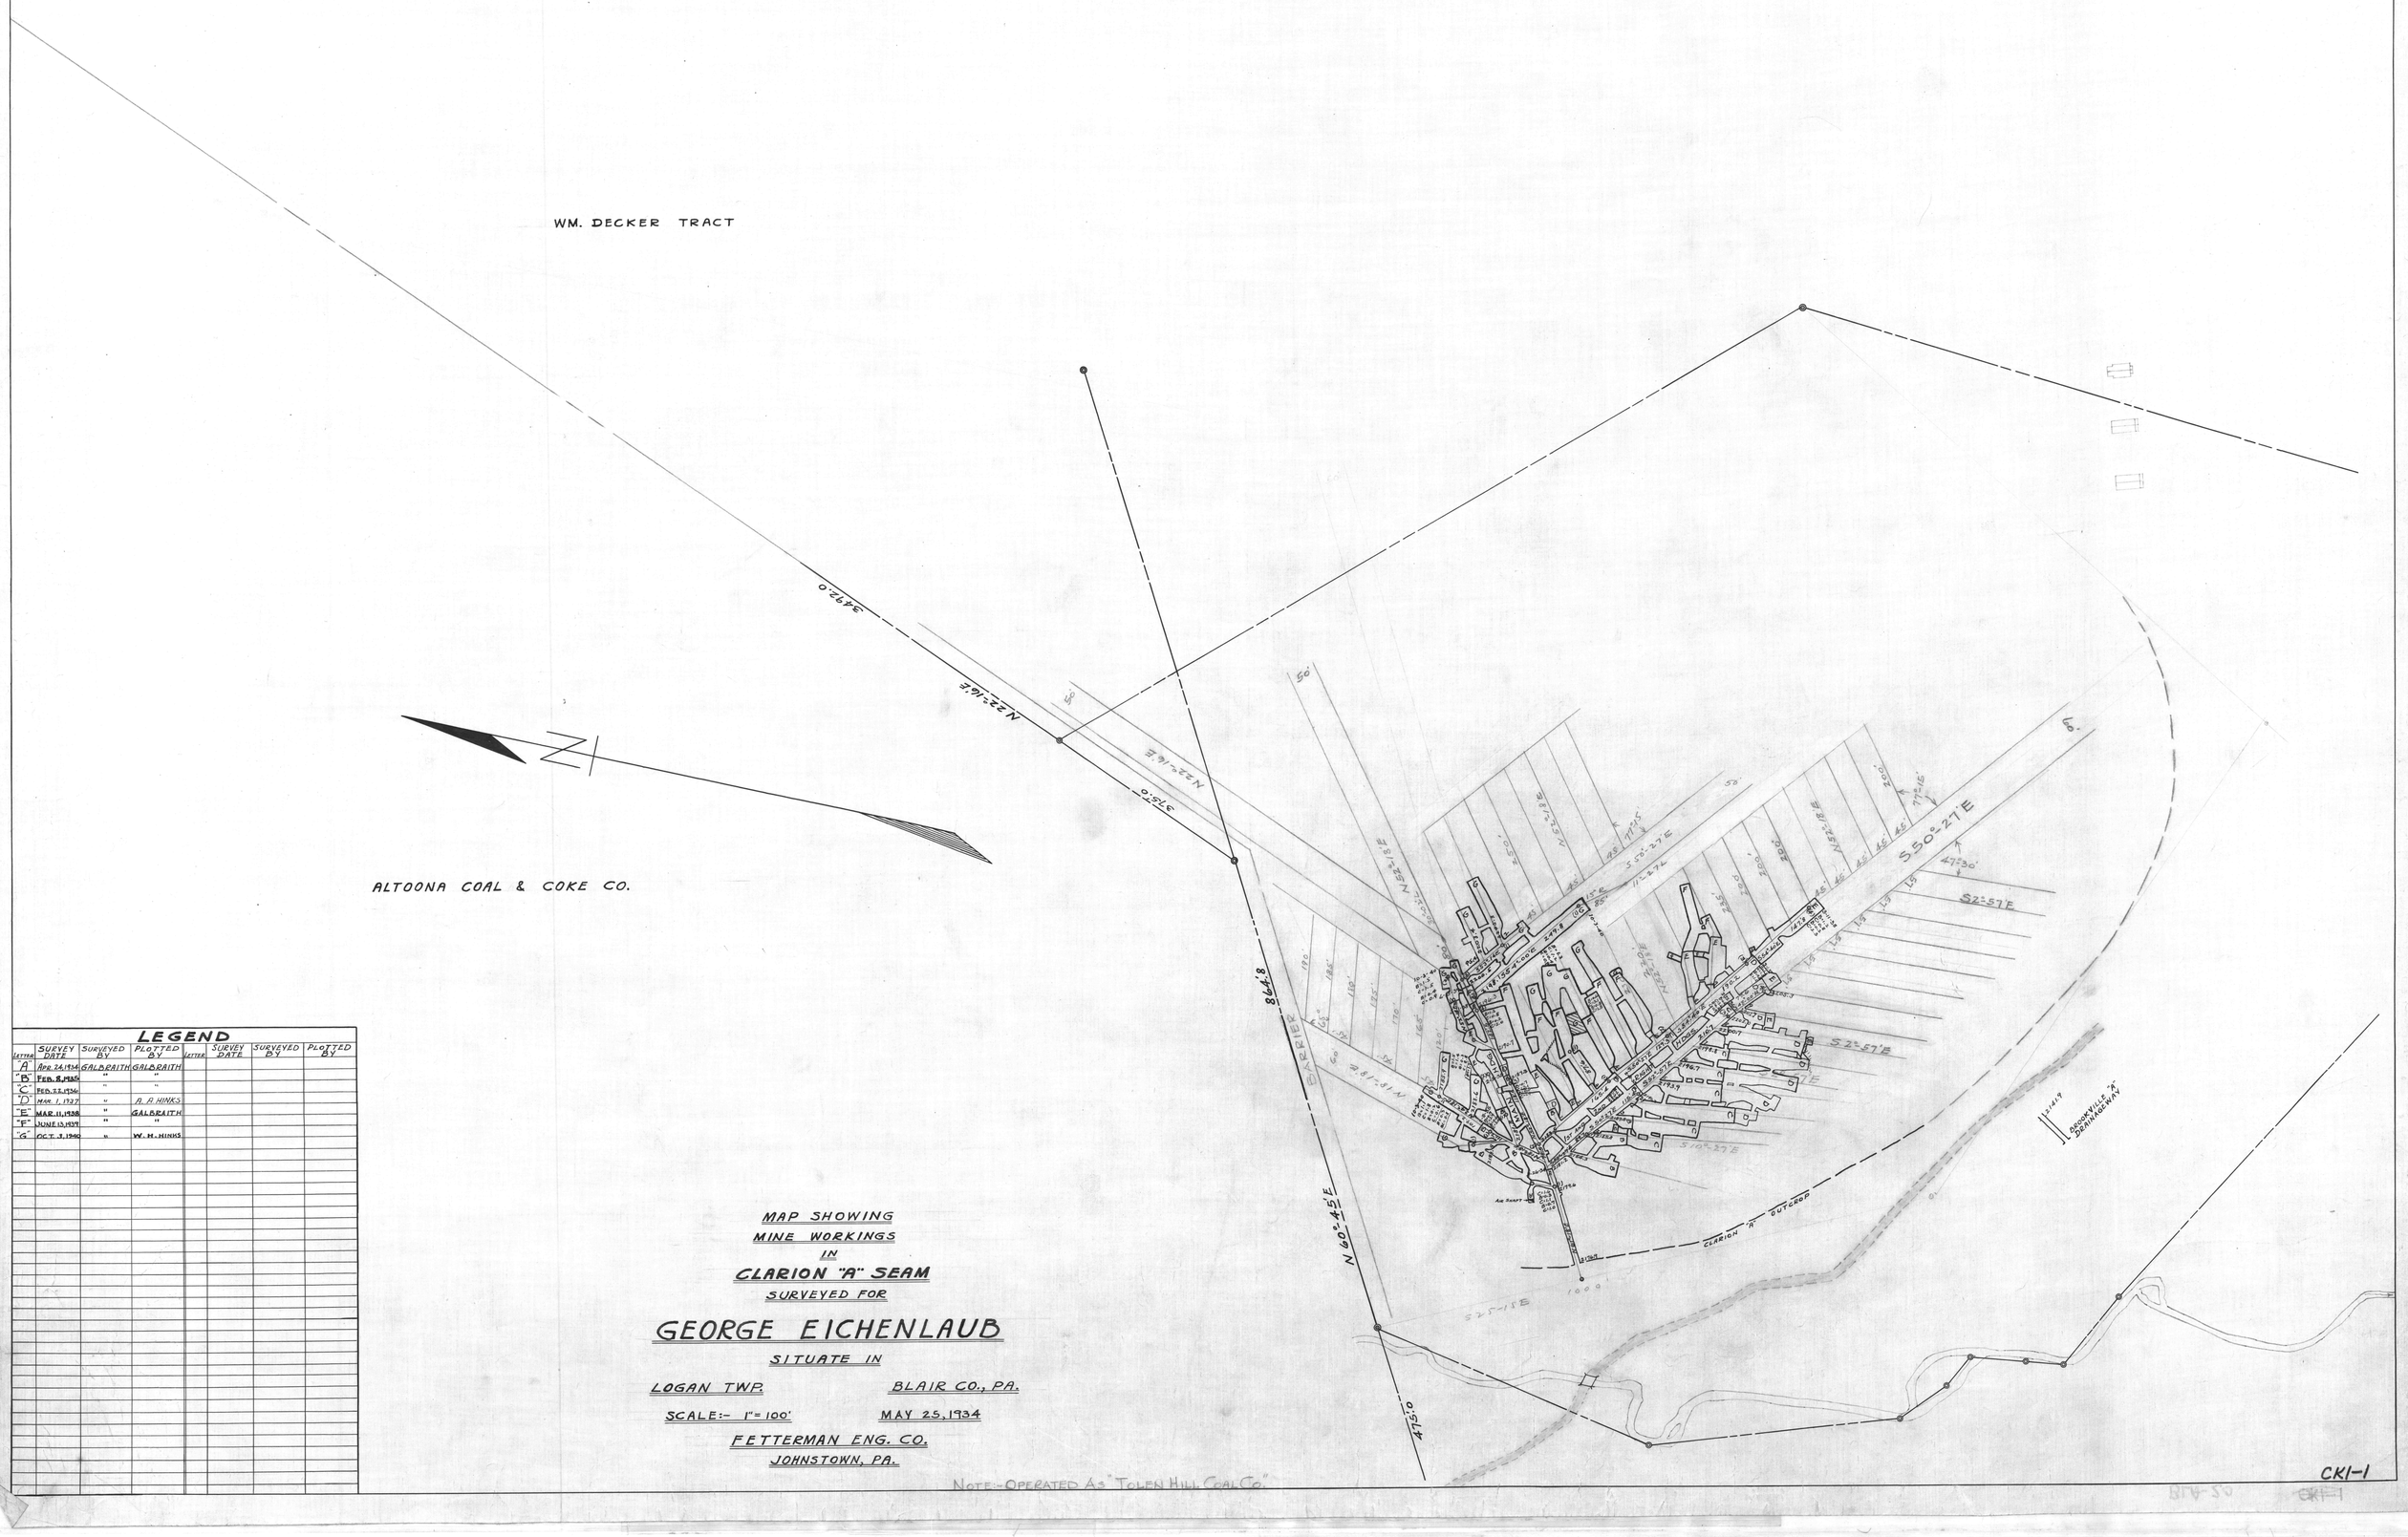

LEGEND

Letter	Survey Date	Surveyed By	Plotted By	Letter	Survey Date	Surveyed By	Plotted By
"A"	Apr. 24, 1934	GALBRAITH	GALBRAITH				
"B"	Feb. 8, 1935	"	"				
"C"	Feb. 22, 1936	"					
"D"	Mar. 1, 1937	"	A. A. HINKS				
"E"	Mar. 11, 1938	"	GALBRAITH				
"F"	June 13, 1939	"	"				
"G"	Oct. 3, 1940	"	W. M. HINKS				

MAP SHOWING
MINE WORKINGS
IN
CLARION "A" SEAM
SURVEYED FOR

GEORGE EICHENLAUB

SITUATE IN

LOGAN TWP. BLAIR CO., PA.

SCALE:- 1"= 100' MAY 25, 1934

FETTERMAN ENG. CO.
JOHNSTOWN, PA.

NOTE:- OPERATED AS "TOLEN HILL COAL CO."

CK1-1