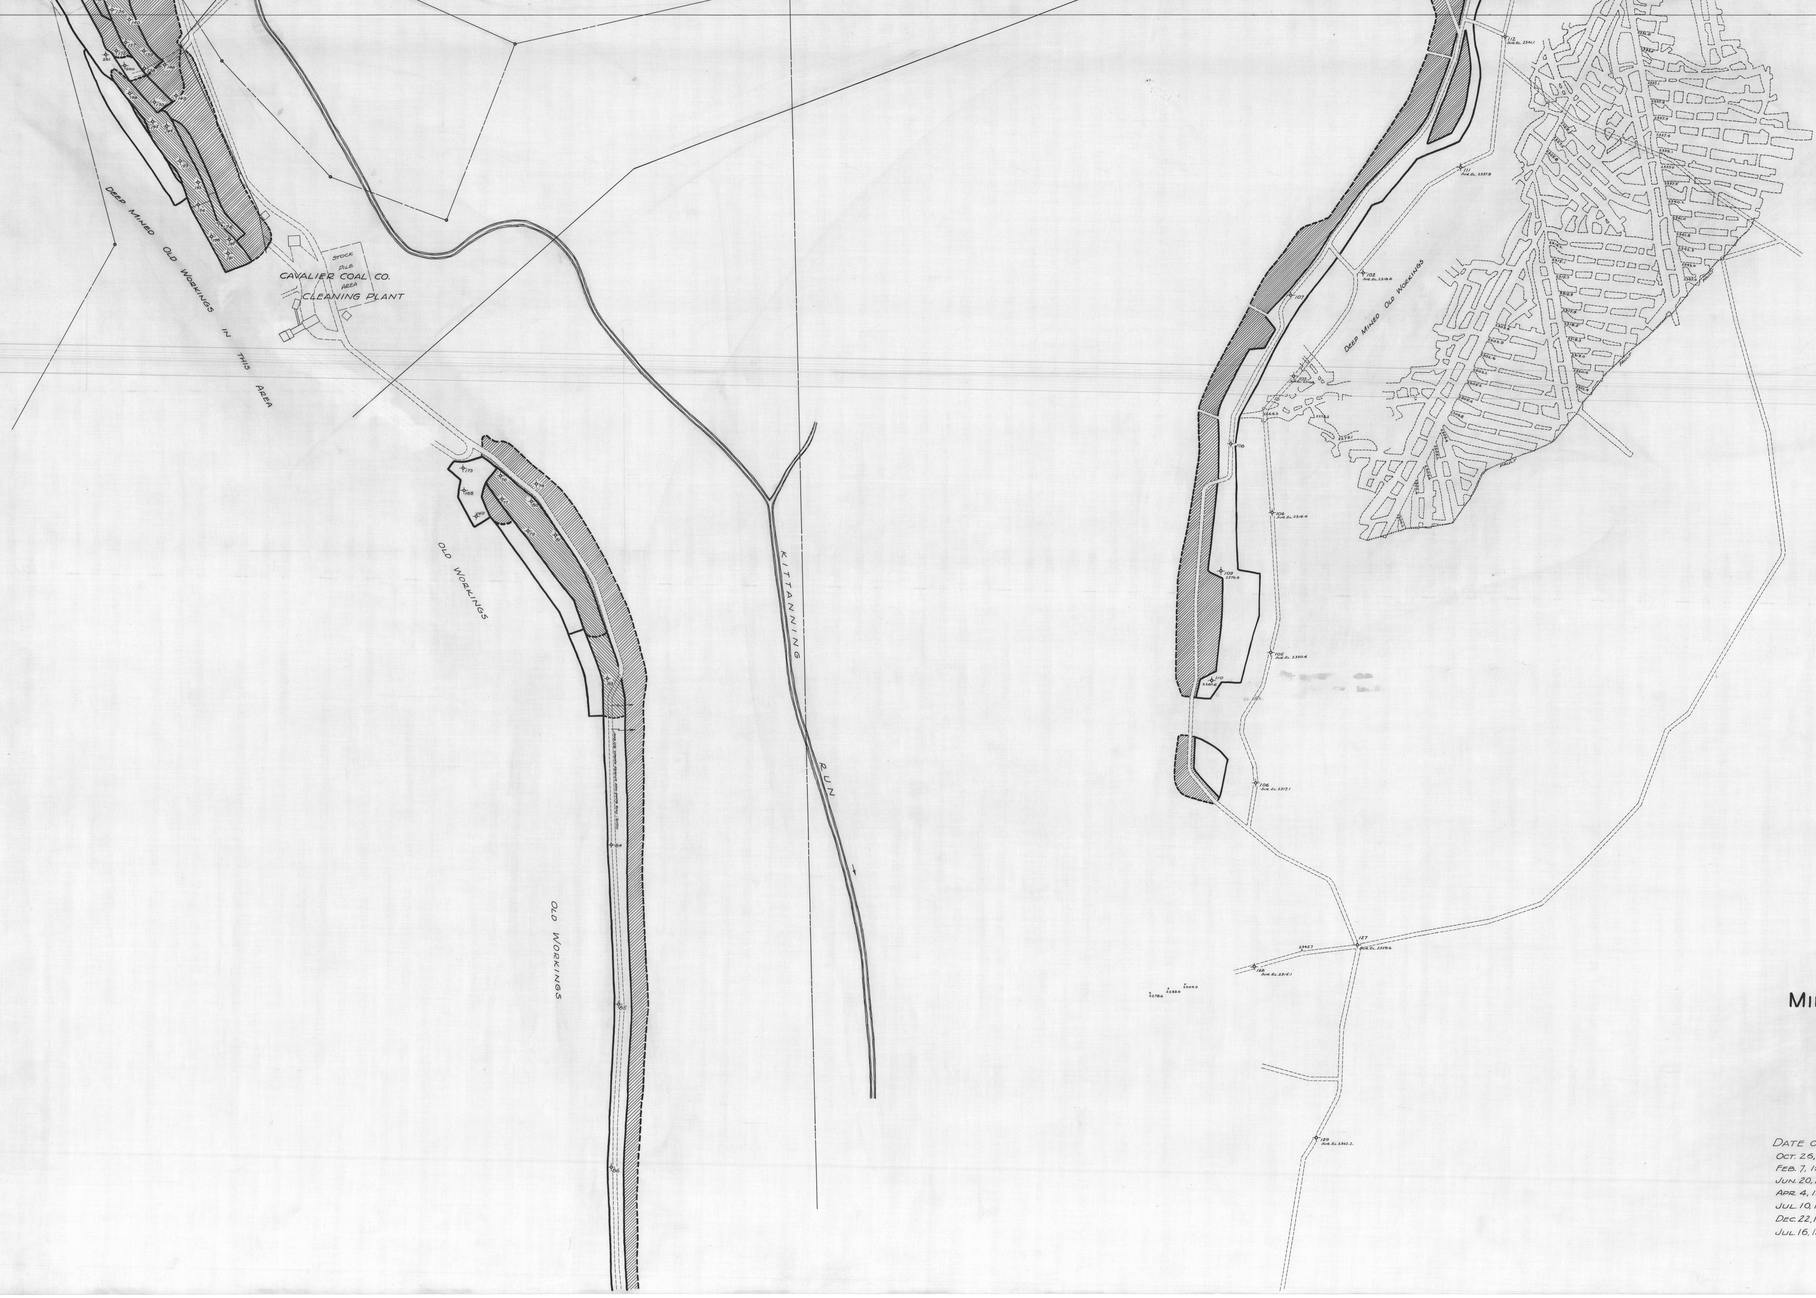

MAP SHOWING
MINING OPERATIONS IN THE BROOKVILLE SEAM
JAMES A. PAGE TRACT

SITUATE IN
LOGAN TOWNSHIP, BLAIR COUNTY, PENNSYLVANIA
SCALE: 1 IN. = 100 FT.

ENGINEERING DEPT. GARFIELD REFRACTORIES CO.

DATE OF SURVEY
OCT. 26, 1951
FEB. 7, 1952
JUN. 20, 1952
APR. 4, 1953
JUL. 10, 1953
DEC. 22, 1953
JUL. 16, 1954

NOTE: DEEP MINE WORKINGS TRACED FROM MAP MADE BY FETTERMAN ENGINEERING COMPANY. PILLAR EXTRACTION IN DEEP MINING NOT SHOWN TO PRODUCE ADDED CLEARNESS IN THE STRIPPING AREAS.