


OFFICE
2-A-15

~~H.C. KENNER~~
JAMES PAGE

ALTOONA
COAL
&
COKE
CO.

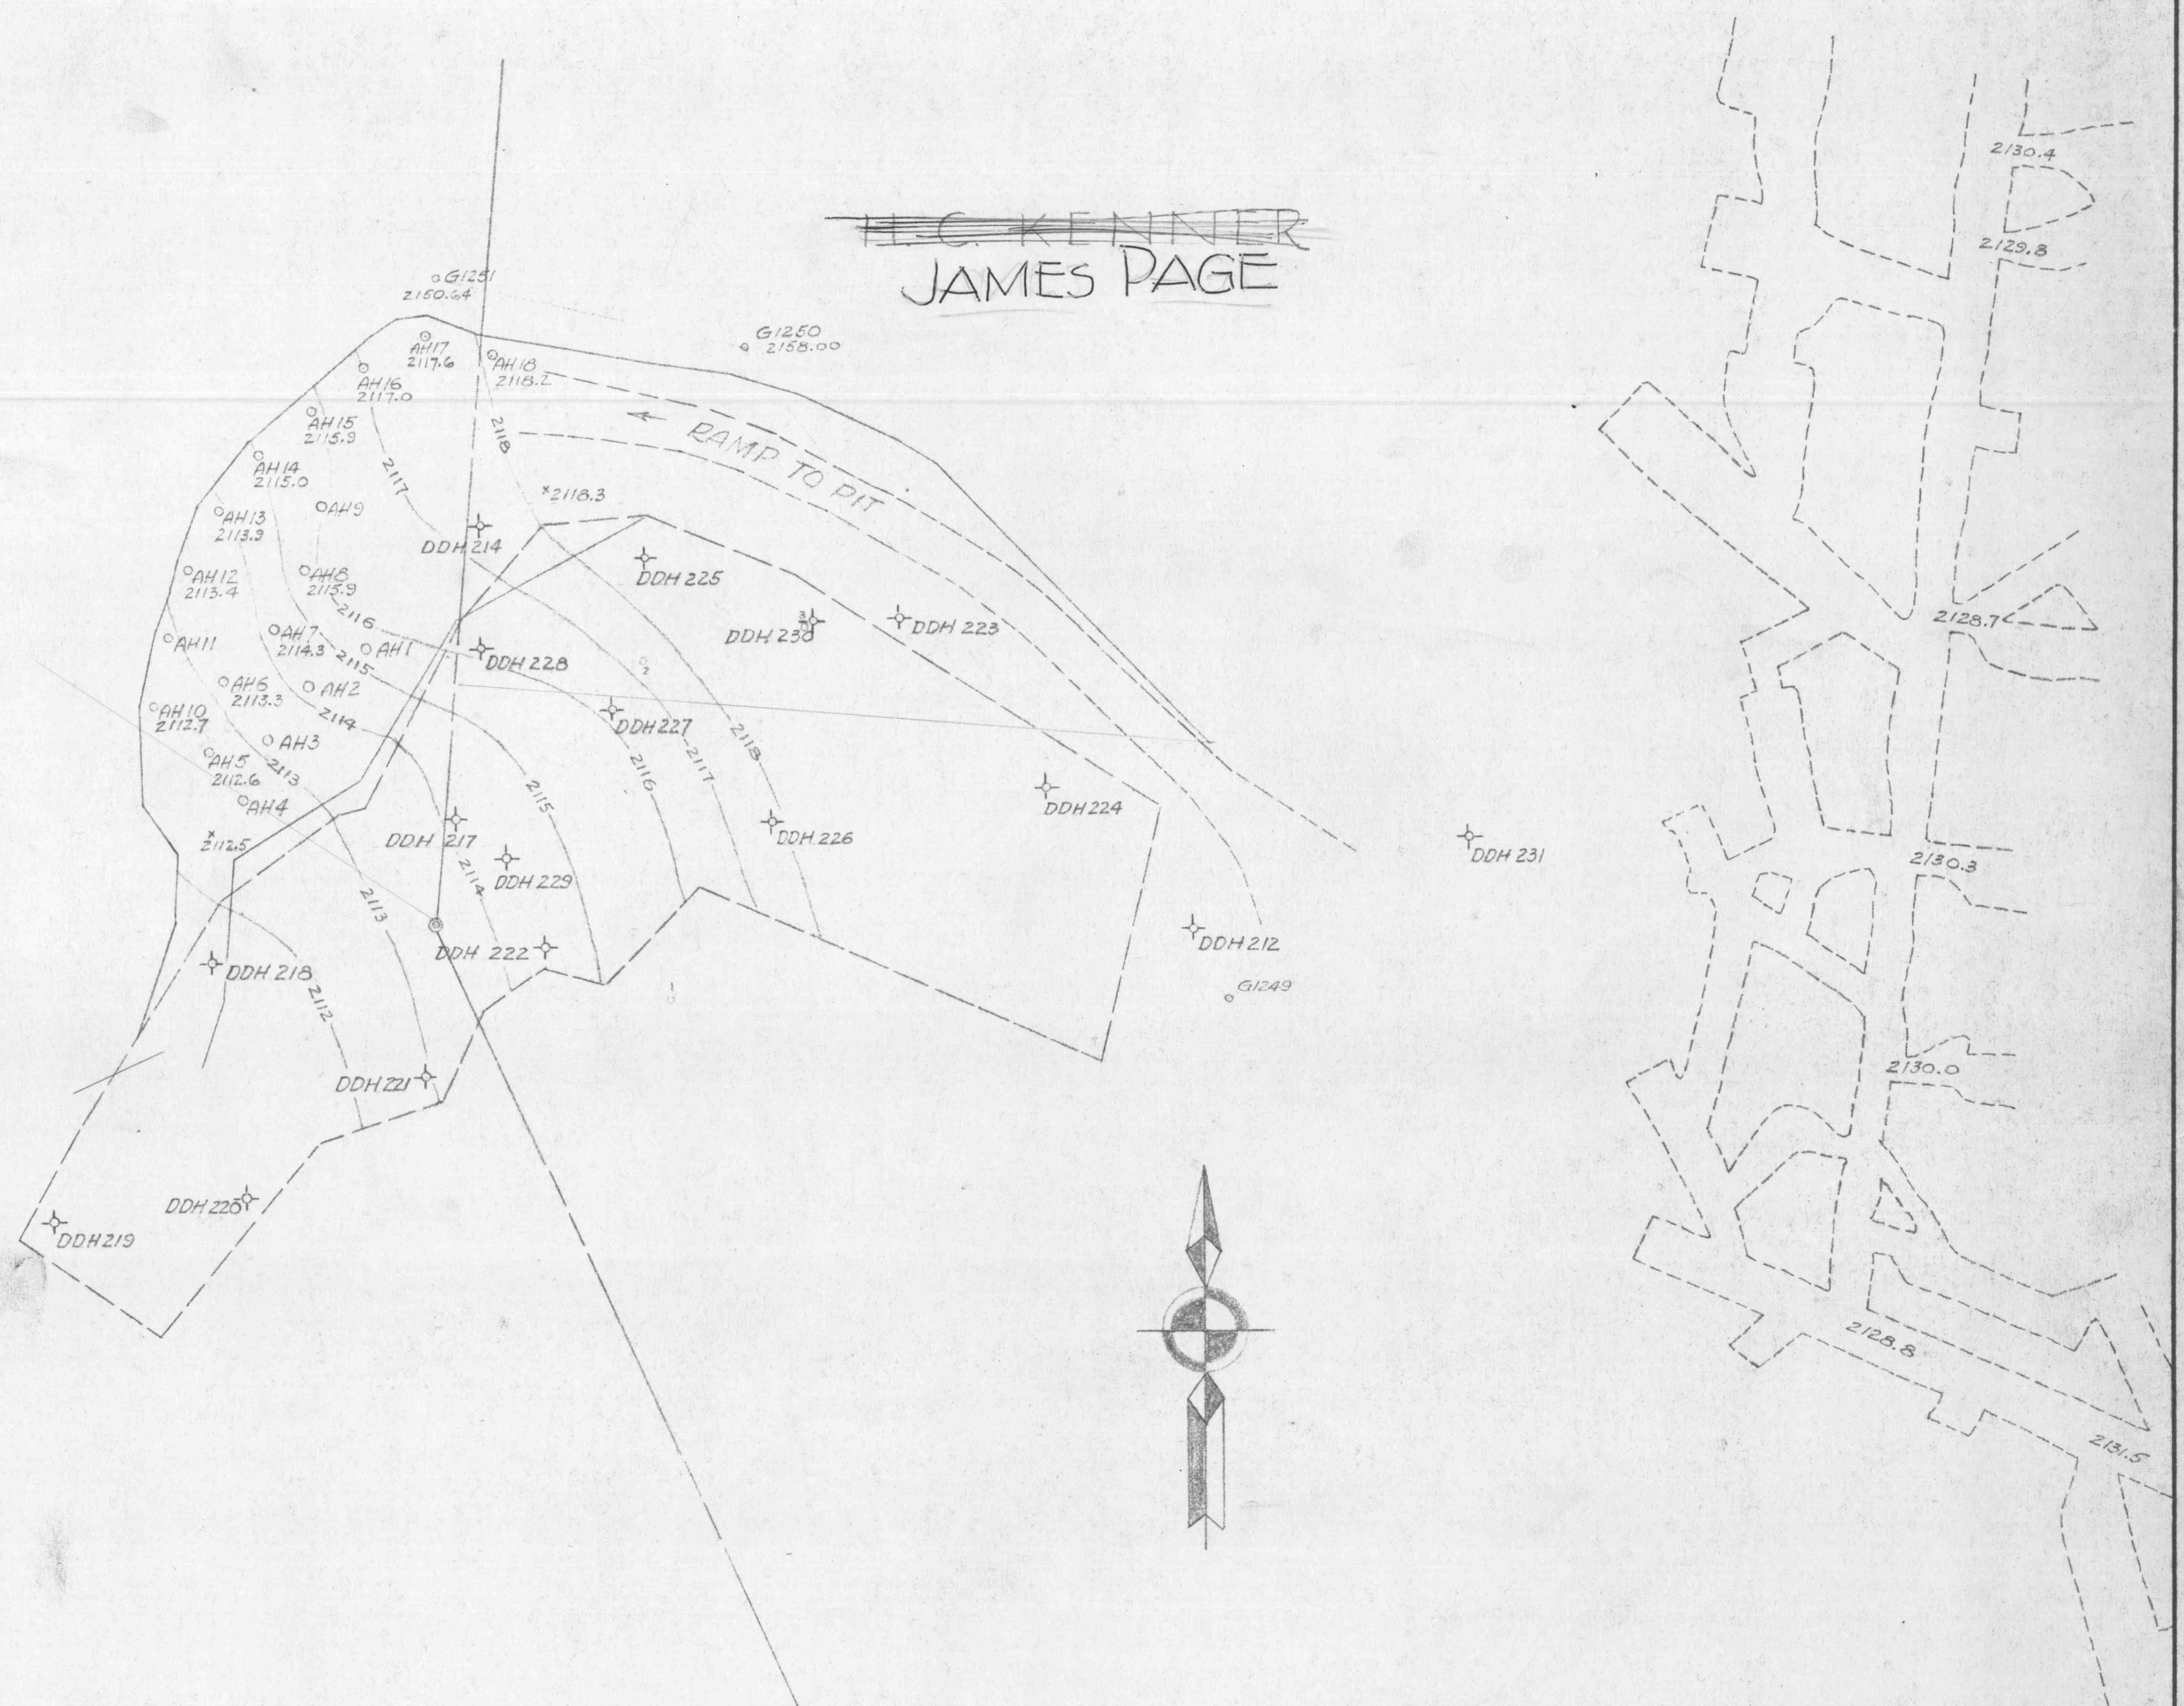

CAVALIER COAL CO., INC.
ALTOONA, PA.

DRILL HOLE LOCATIONS
IN
BROOKVILLE FIRE CLAY SEAM
FOR: GARFIELD REFRACTORIES CO., BOLIVAR, PA.

REVISIONS		SCALE: 1" = 40'	DRAWN BY: J.W.F.
DATE	REMARKS		
Sept. 7	Corrected Prop. Title	DATE: SEPT. 2, 1955	DRAWING NO. G 9551 1 of 2
		CHECKED:	