

MAP SHOWING MINE WORKINGS
 OF THE
BRADLEY MINE COAL CO.
 IN THE "B" SEAM OF COAL
 AND RELATION OF SAME TO THE SURFACE OWNERSHIP OF
HEIRS OF JAMES P. MURRAY
 ALLEGHENY TOWNSHIP, BLAIR COUNTY, PA.


SCALE: 1"=100'

W.A. SILLIMAN
 MINING ENGINEER
 ALTOONA, PA.

B7B5-2

LEGEND

- AREA OF COAL MINED OUT AND REMOVED BY BRADLEY MINE COAL CO. SHOWN THUS:—
- CLEARED LAND OVERLYING MINE WORKINGS OF BRADLEY MINE COAL CO. OUTLINED THUS:—
- SURFACE OWNERSHIP OF HEIRS OF JAMES P. MURRAY, OUTLINED THUS:—

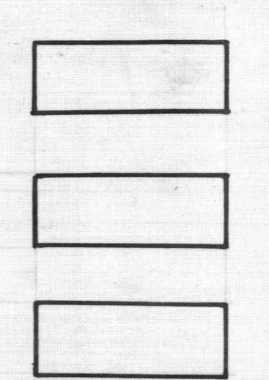

GWIN ENGINEERS INC.
 1200 12th AVENUE
 ALTOONA, PENNSYLVANIA 16601

BRADLEY MINE CO. No. 4 DRIFT