

MENELIS MINE

OPERATED BY


G.F. EICHENLAUB COAL CO.

IN THE "B" OR "MILLER" COAL SEAM.

NEAR THE BUCKHORN, BLAIR COUNTY, PENNA.

SCALE: 1"=100'

W.A. SILLIMAN,
MINE ENGINEER
ALTOONA, PA.

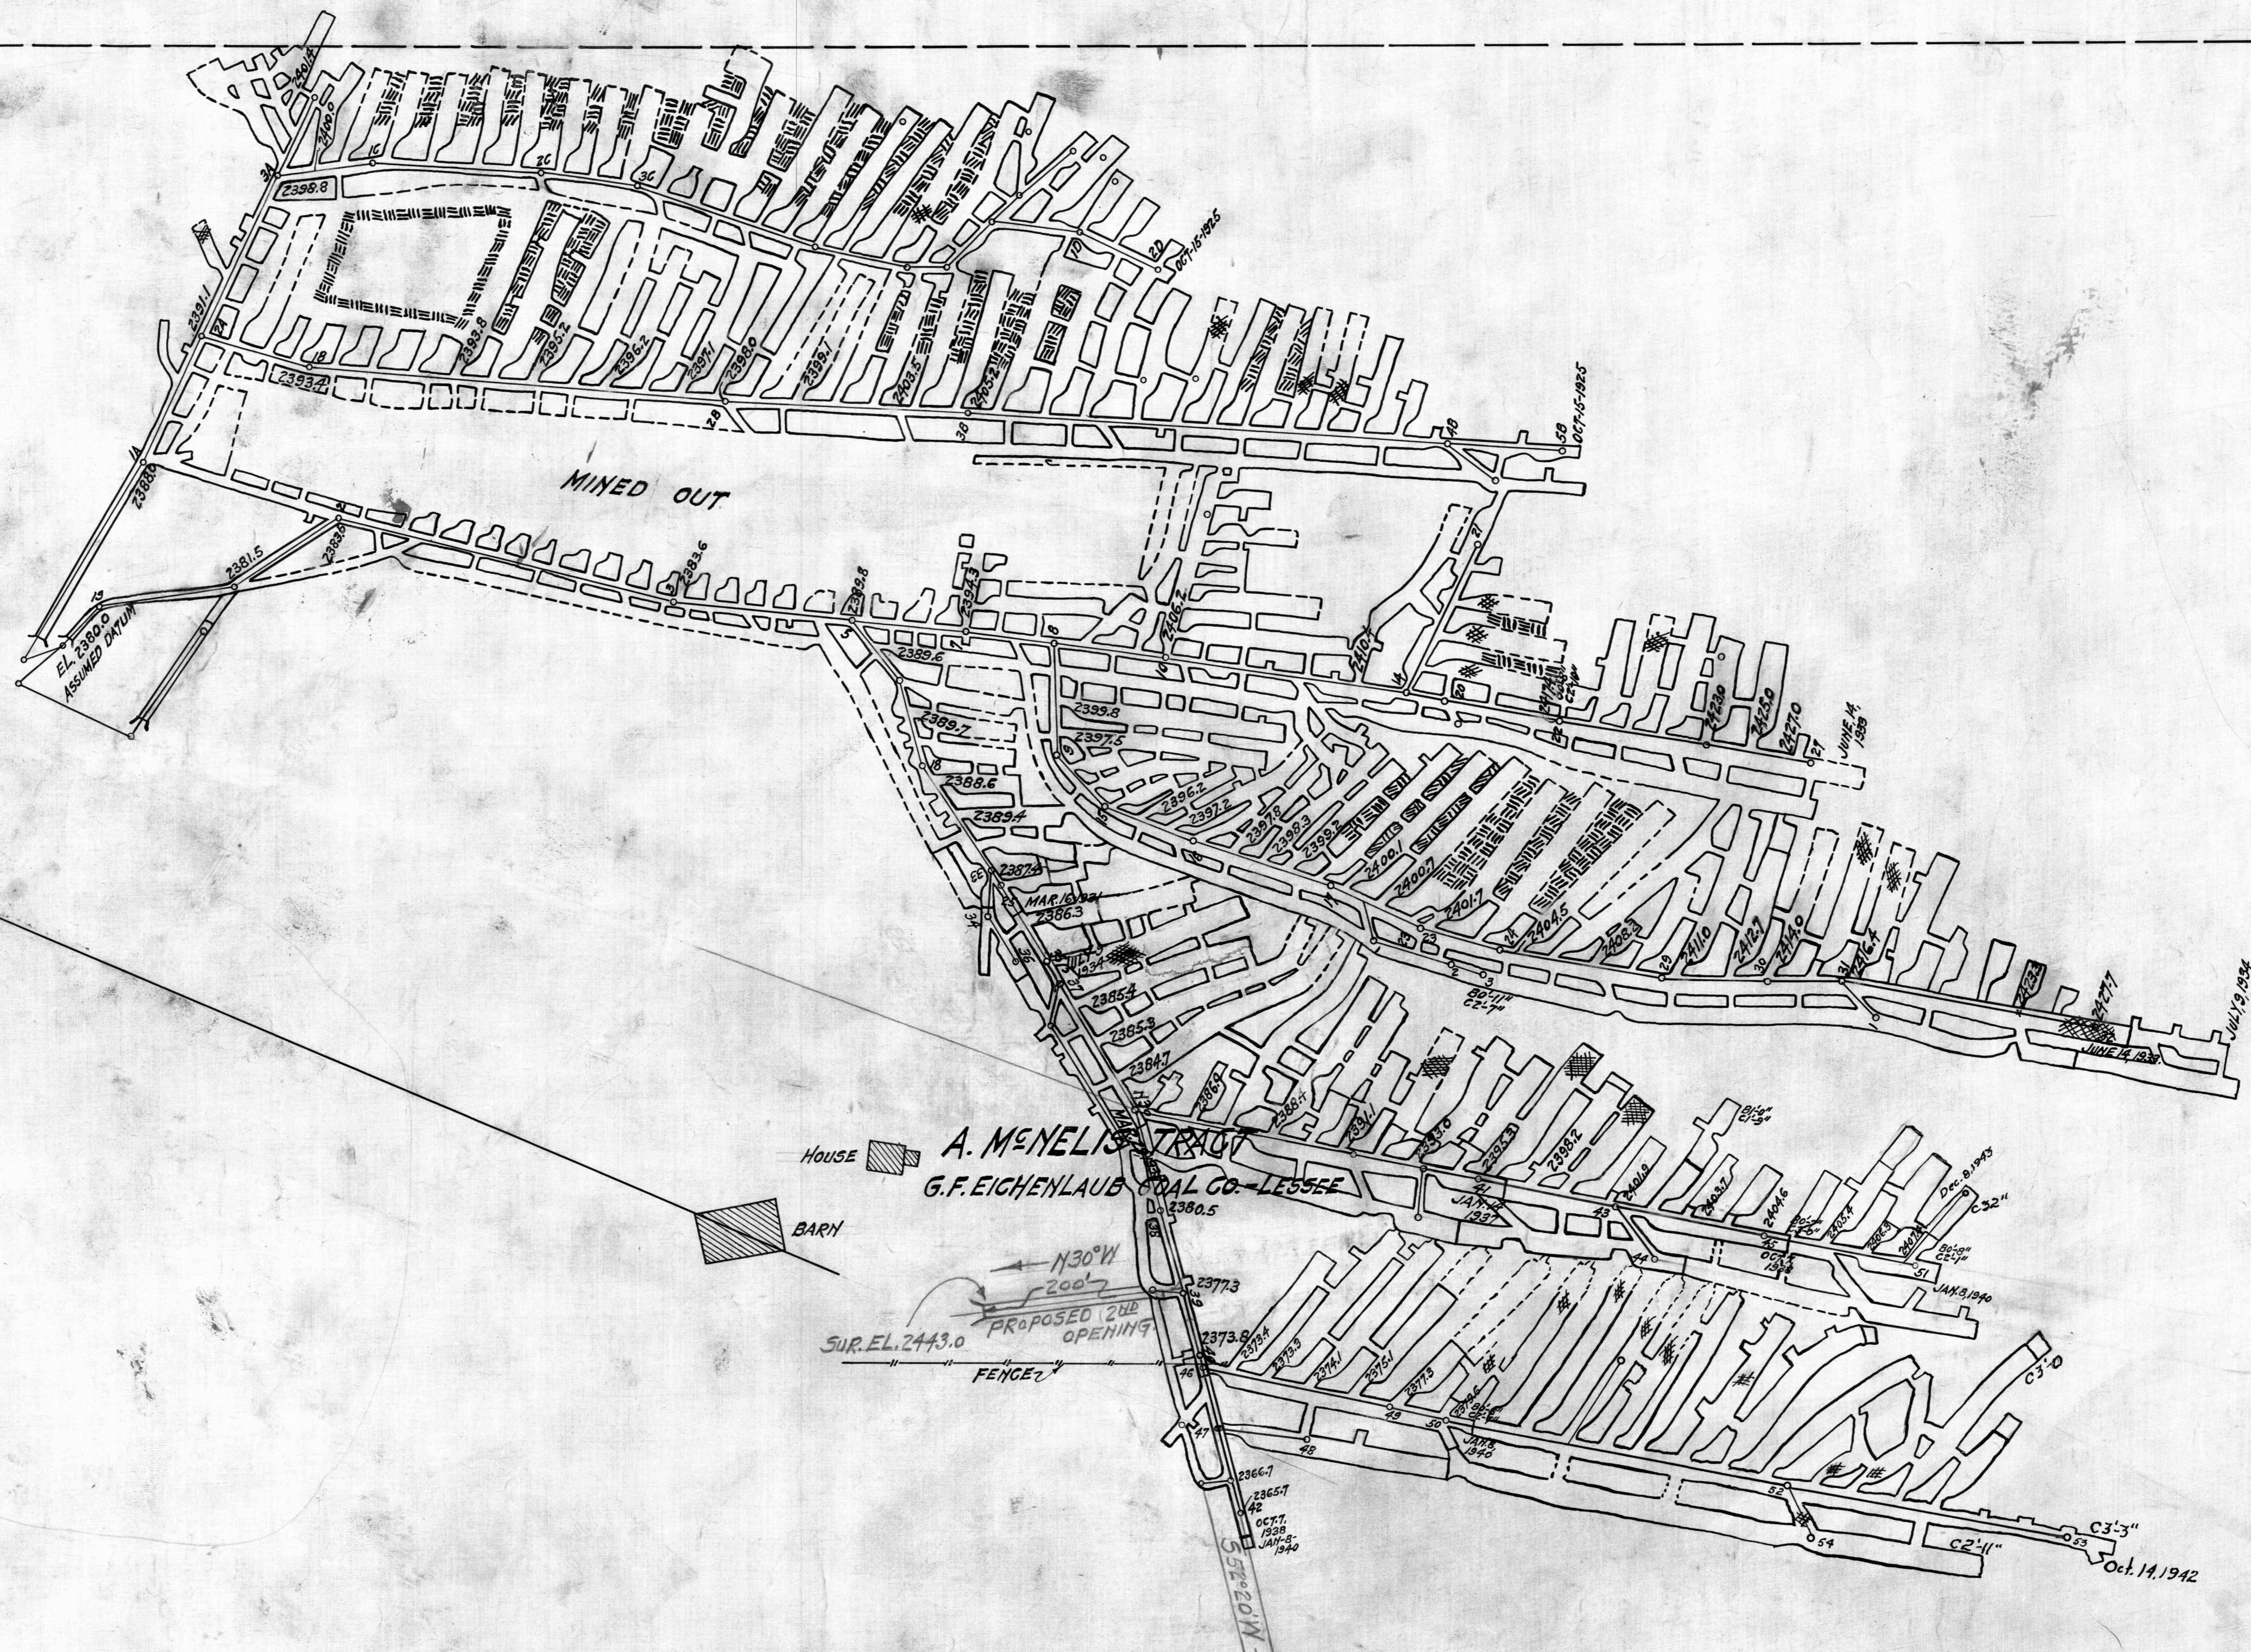

ALTOONA COAL & COKE CO.

WM. DECKER TRACT

ALTOONA COAL & COKE CO.

WORKINGS

OF

WM. DECKER TRACT

JAMES A. PAGE, TRUSTEE.

"HORSESHOE"

MINE